


NM-2936 1934



Anchor Mine
Battery

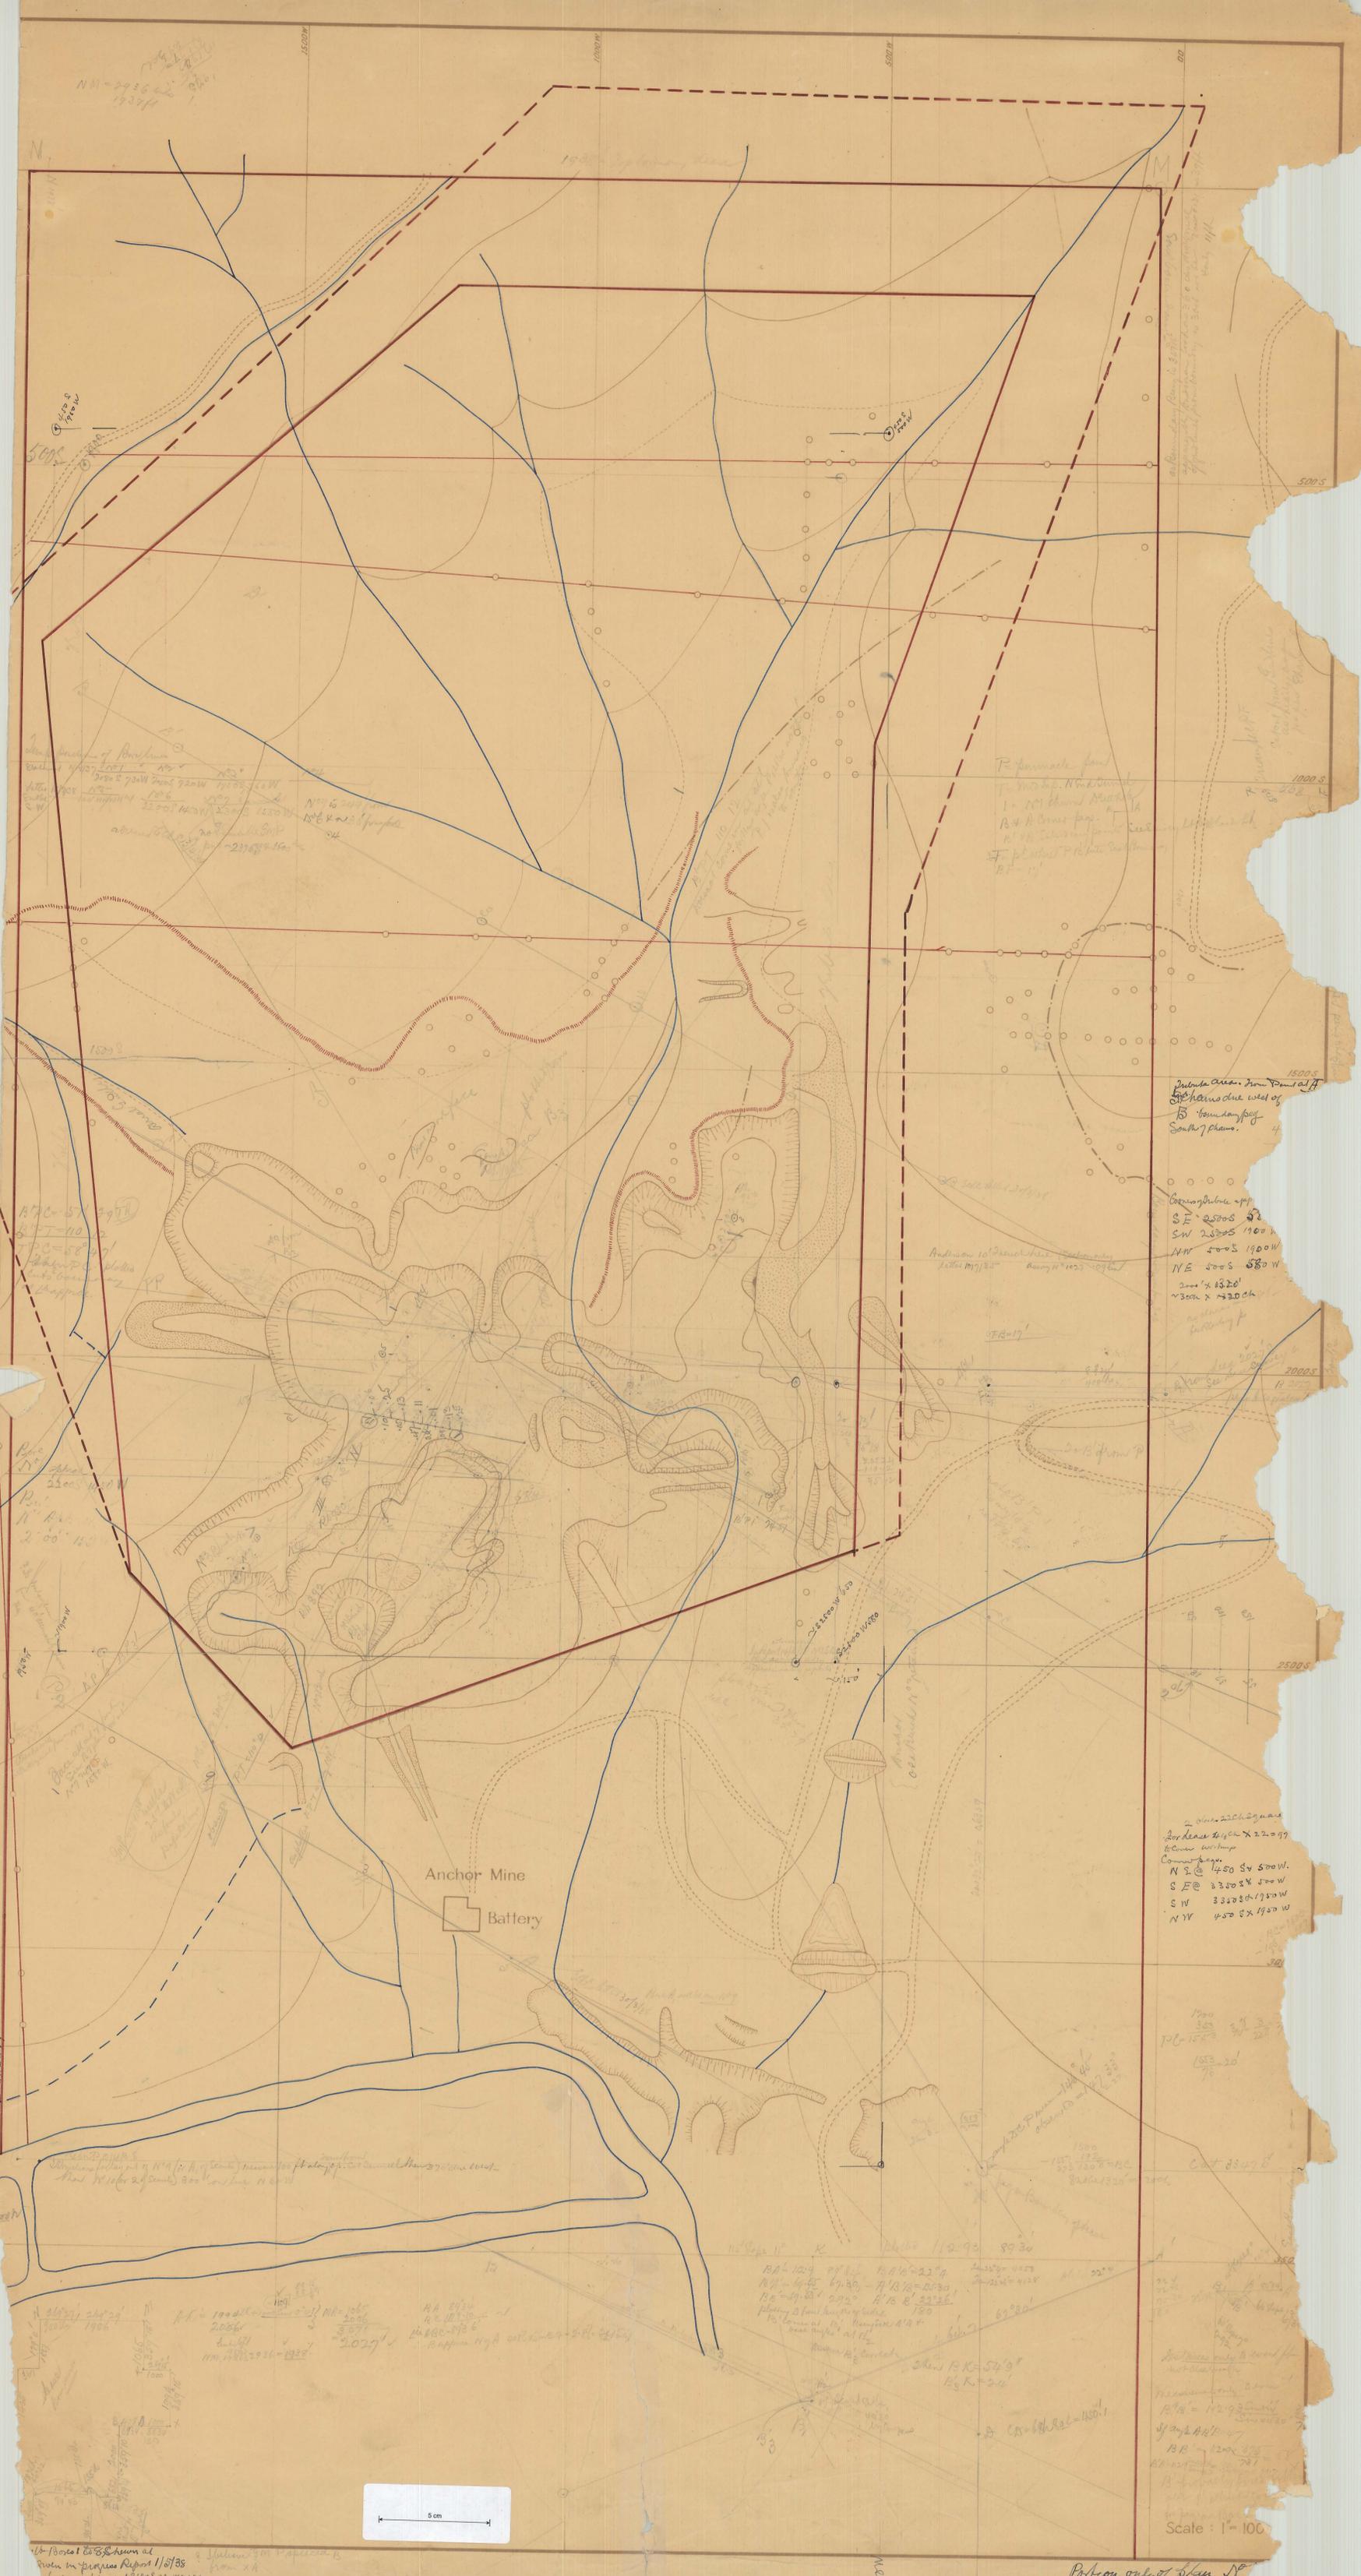

Subdivided from Parcel A
SE 1/4 due west of
B boundary of
South of Pheno.

Corner of
SE 2500 S 2
SW 2500 1900 W
NW 500 S 1900 W
NE 500 S 580 W
200 x 1320
2300 x 1320 ch

Corner of
SE 2500 S 2
SW 2500 1900 W
NW 500 S 1900 W
NE 500 S 580 W
200 x 1320
2300 x 1320 ch

Corner of
SE 2500 S 2
SW 2500 1900 W
NW 500 S 1900 W
NE 500 S 580 W
200 x 1320
2300 x 1320 ch

Corner of
SE 2500 S 2
SW 2500 1900 W
NW 500 S 1900 W
NE 500 S 580 W
200 x 1320
2300 x 1320 ch

Corner of
SE 2500 S 2
SW 2500 1900 W
NW 500 S 1900 W
NE 500 S 580 W
200 x 1320
2300 x 1320 ch

Scale: 1" = 100'

Bottom only of Plan N

U.S. Forest Service
Bureau of Land Management
Washington, D.C.