


247-01

247-01

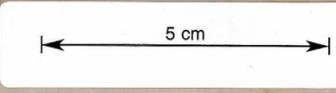


Ophir Mine.

1633 10 acres
93 G Ophir J. M. Lawson

1630
93 G Ophir
10 ac.
J. M. Lawson

1631
93 G Ophir
8 acres
J. M. Lawson

Old Main Shaft 121 ft

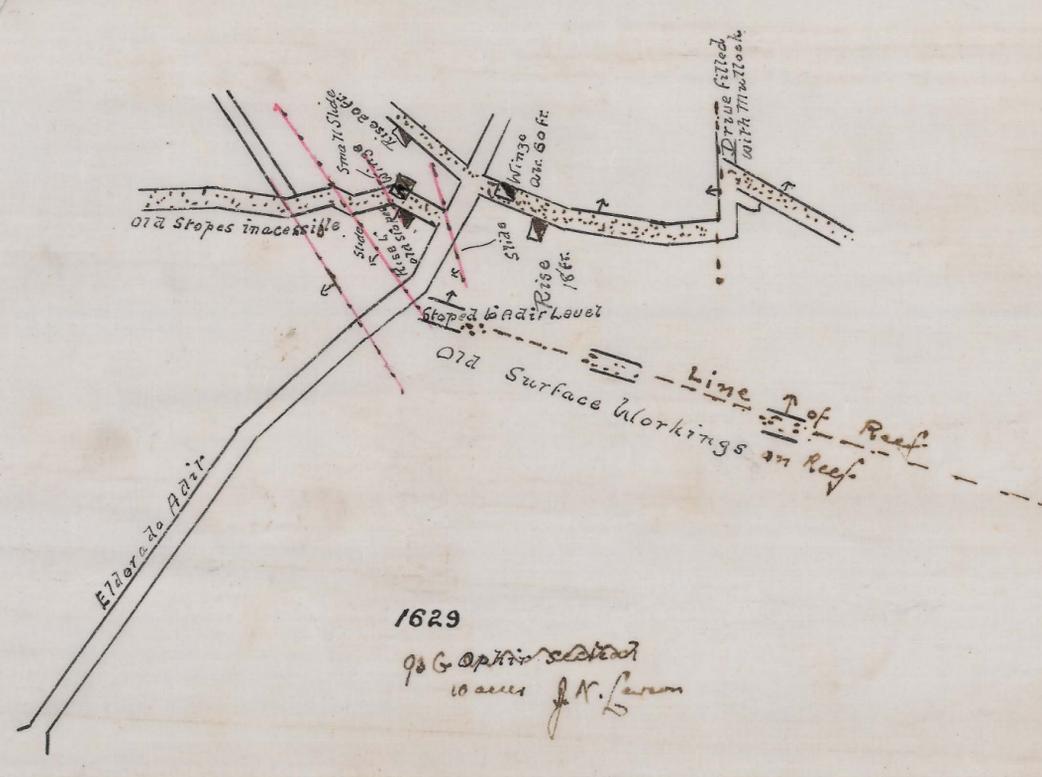


1629
93 G Ophir 10 acres
J. M. Lawson

1632
93 G
7 ac
Ophir
J. M. Lawson


Ophir Mine

Plan of

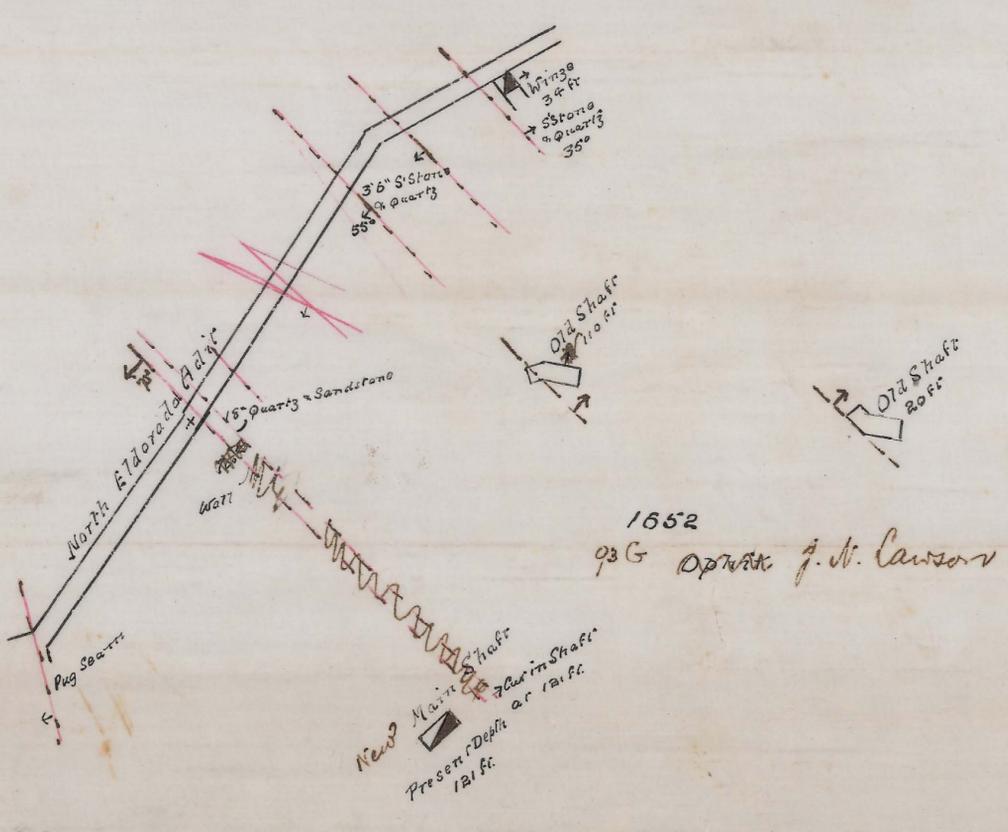

1652
93 G Ophir J. M. Lawson

349
G
10 ac
J. F. O'Kelly

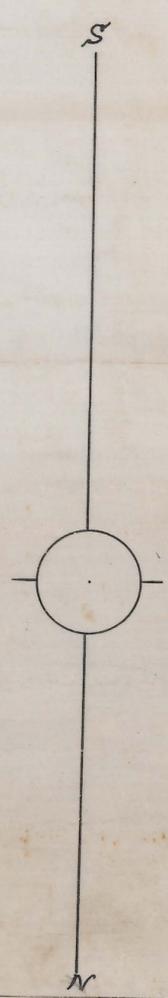

816
295
New Golden Gate
10 ac

185 87 G New Golden Gate
3 ac G. M. Co. N. L.

536 10 ac
H. L. H. H. H.

351
O'Kelly