



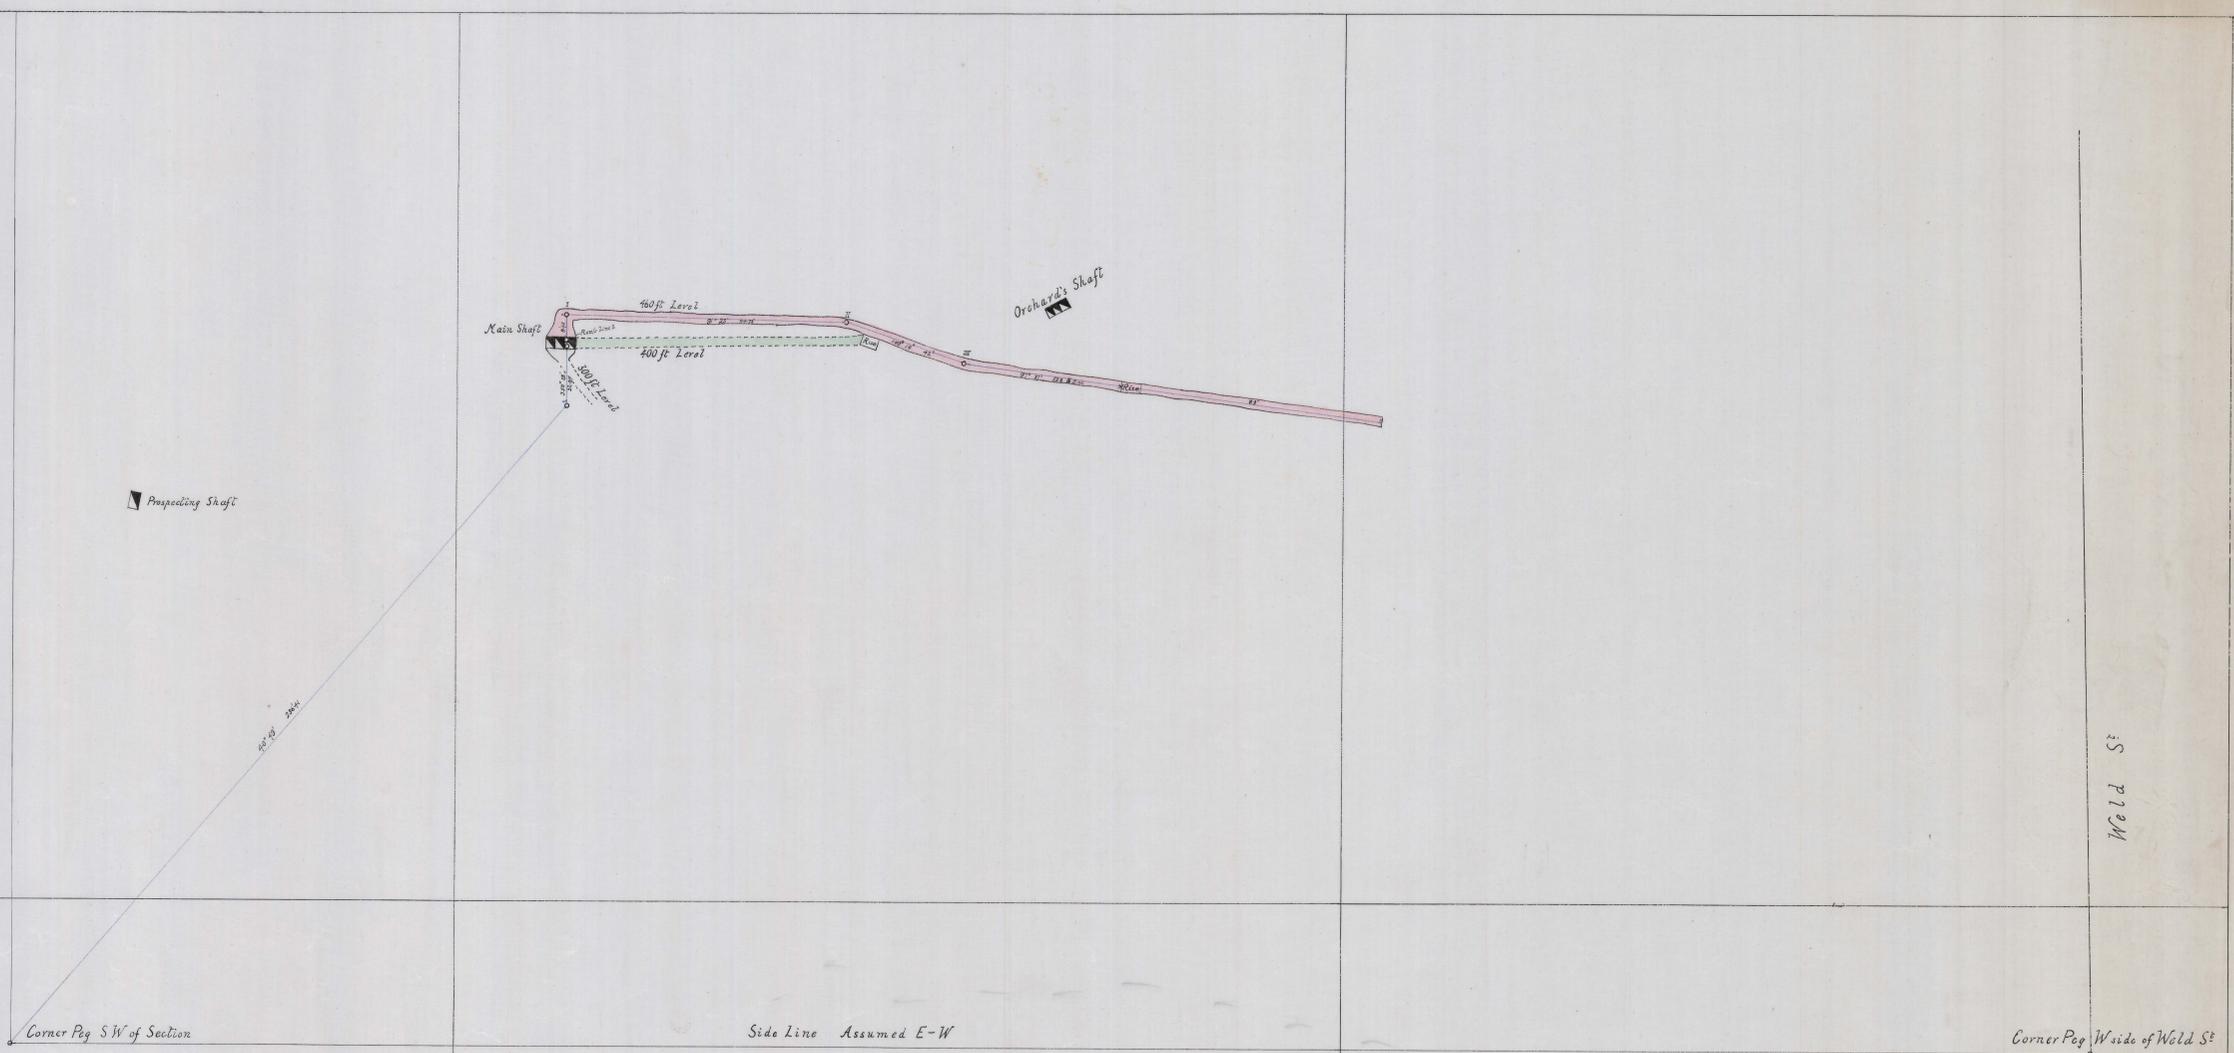

217-02

217-02

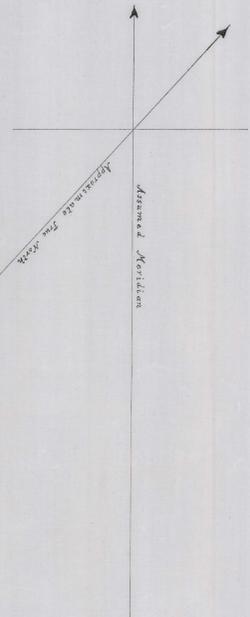


Tasman Ophir Mine
Plan
Scale 1 in = 25 ft

Harlowell Conder ARSM
Aug 1903



Ballarat Shaft

Prospecting Shaft

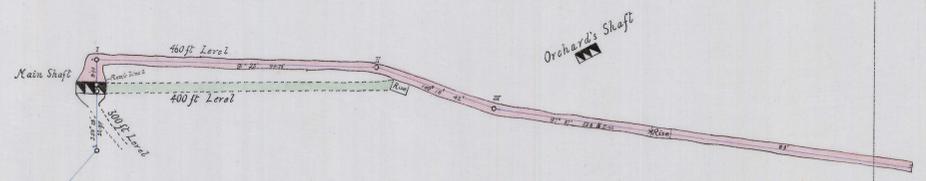

Corner Peg SW of Section

Side Line Assumed E-W

Corner Peg W side of Wold St

Wold St