



1
5m

Tasman Ophir Mine

Sections

W-E

S-N

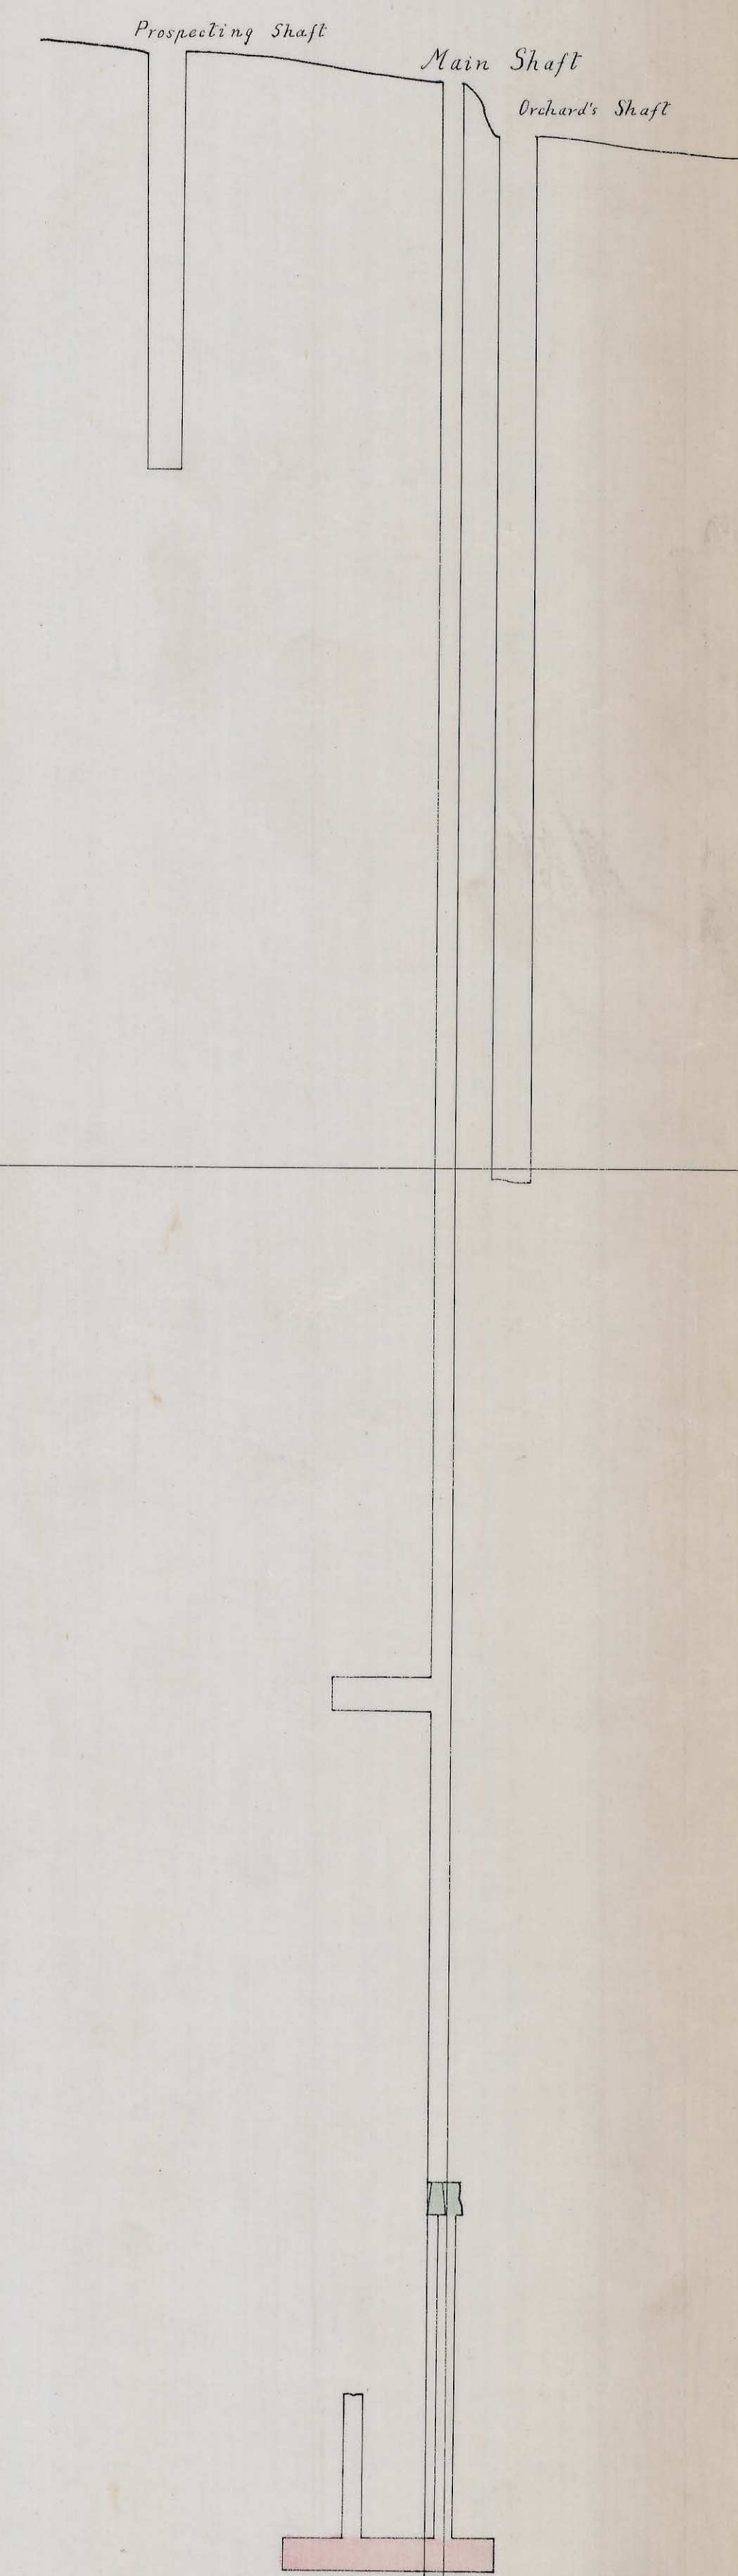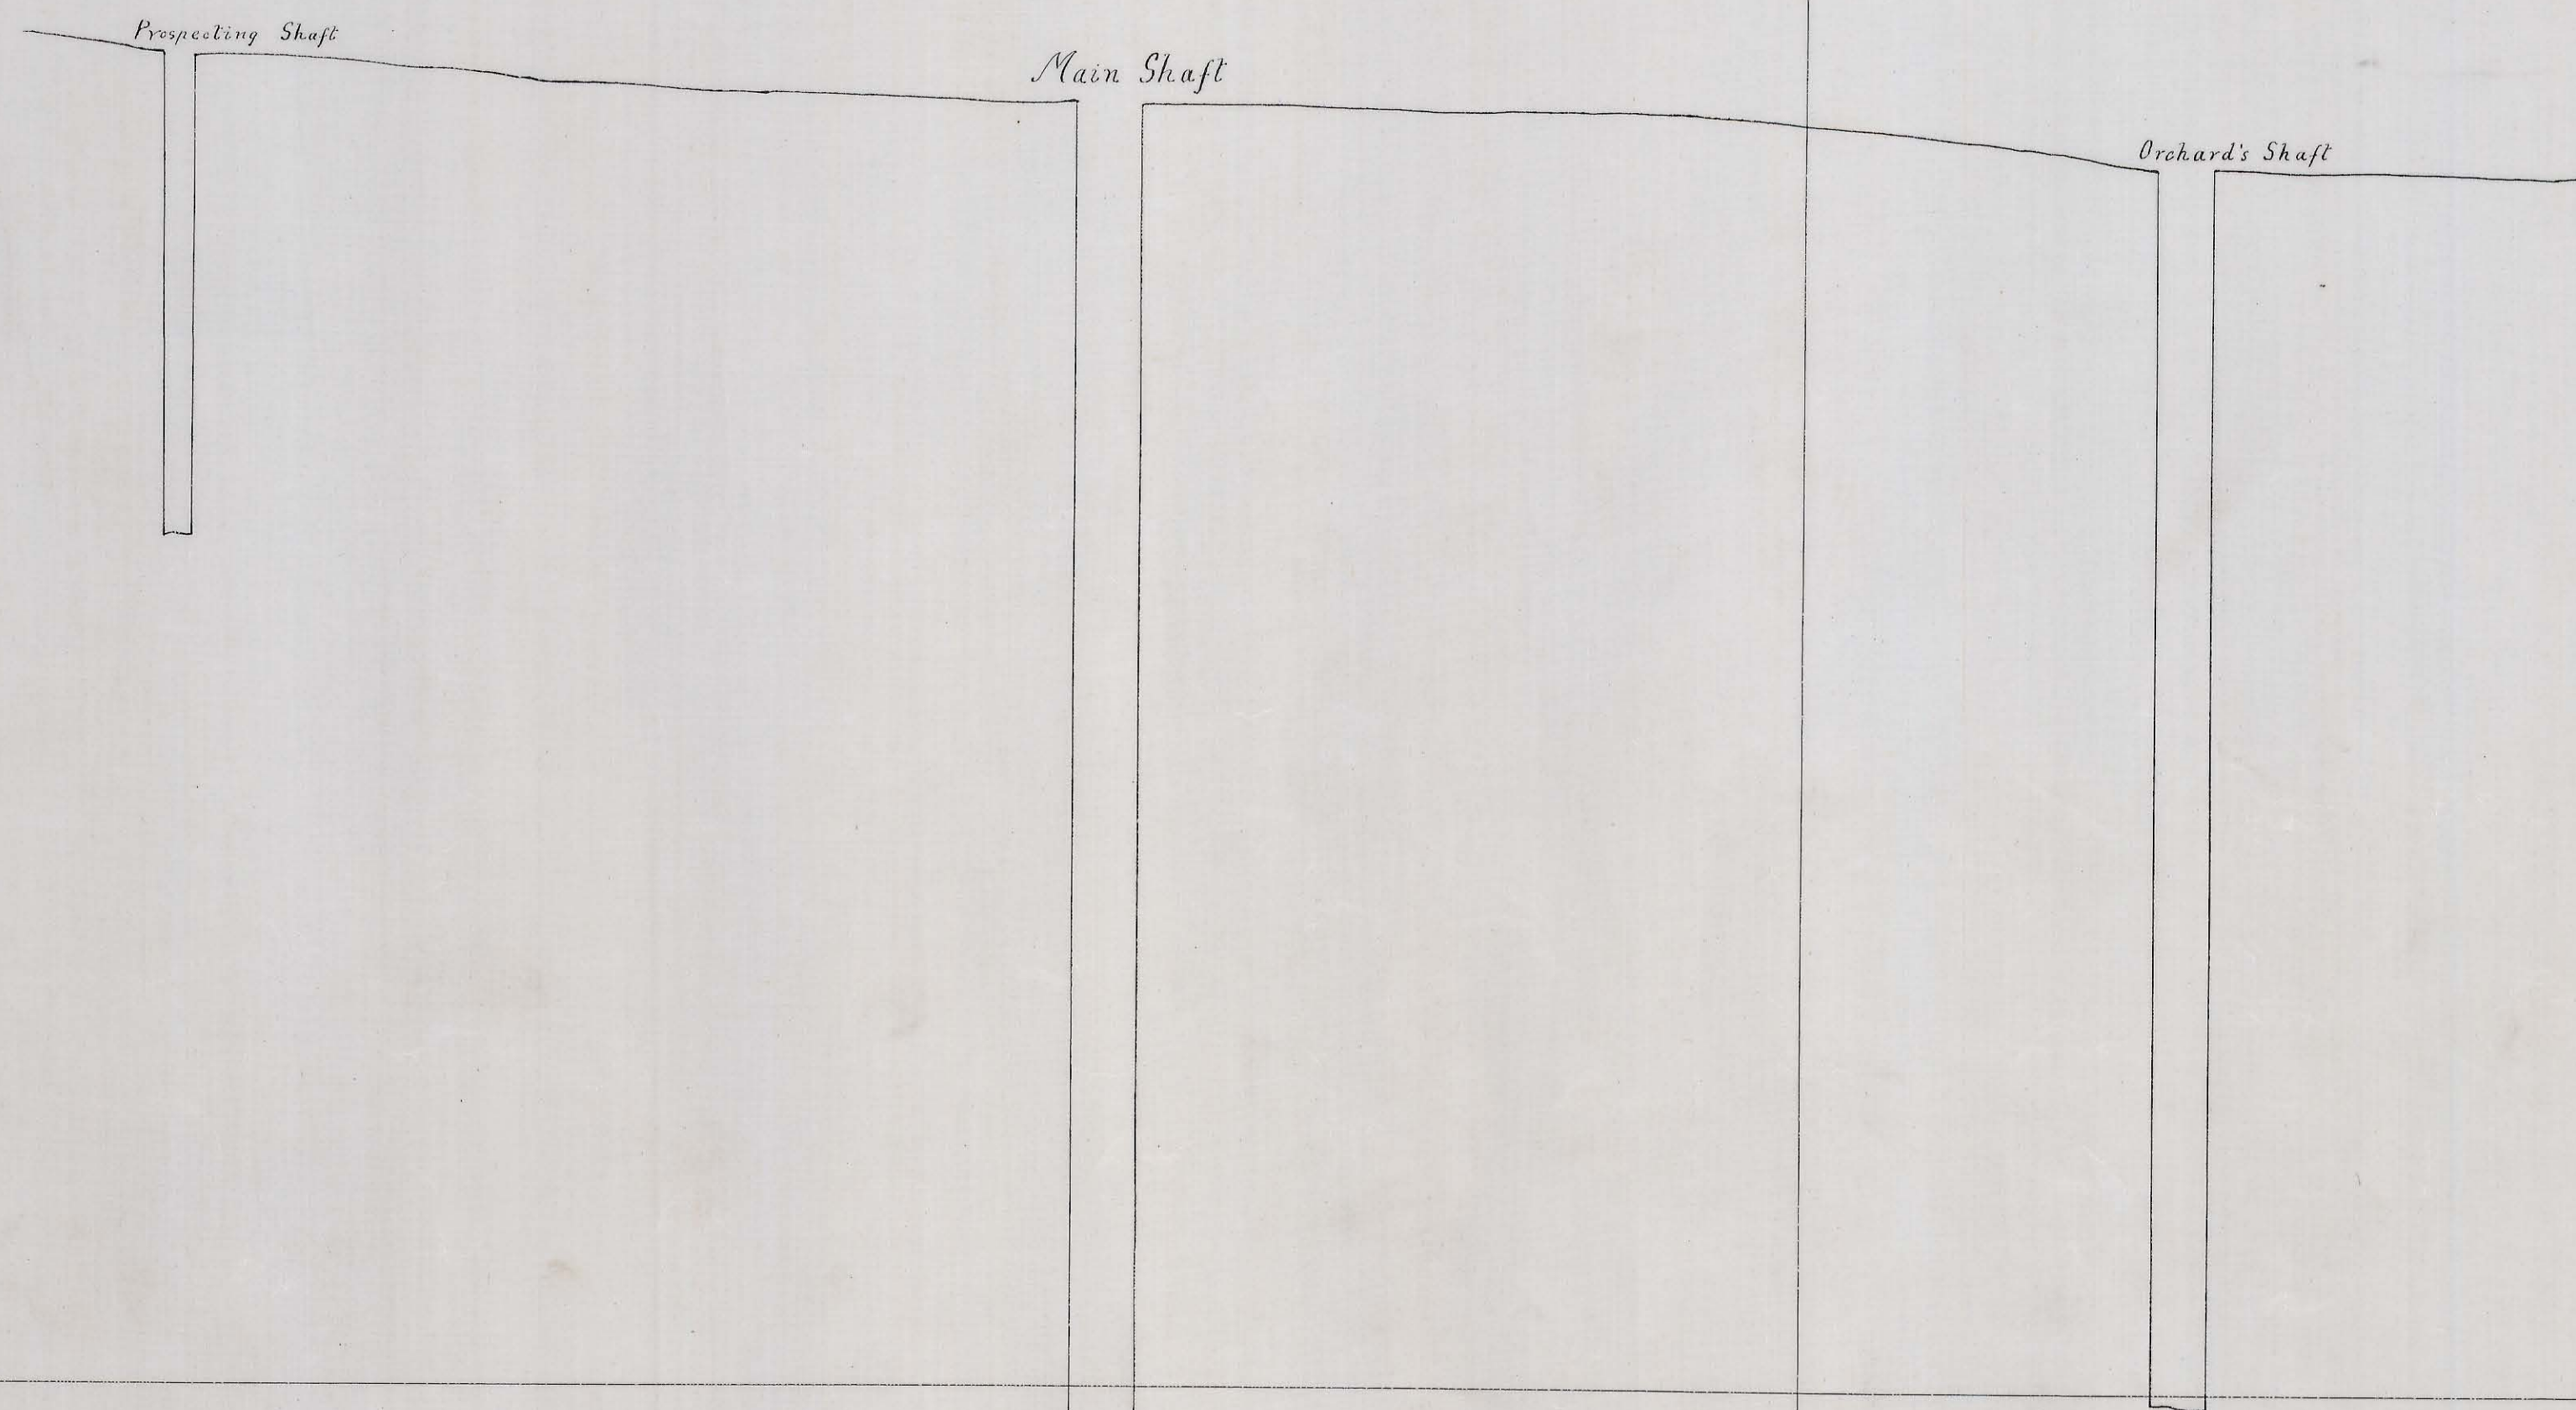

Scale 1 in = 25 ft



Harwell Corder Aug 1863

247-03

247-03