


11th April 1885

BROTHERS HOME T. M. C^o

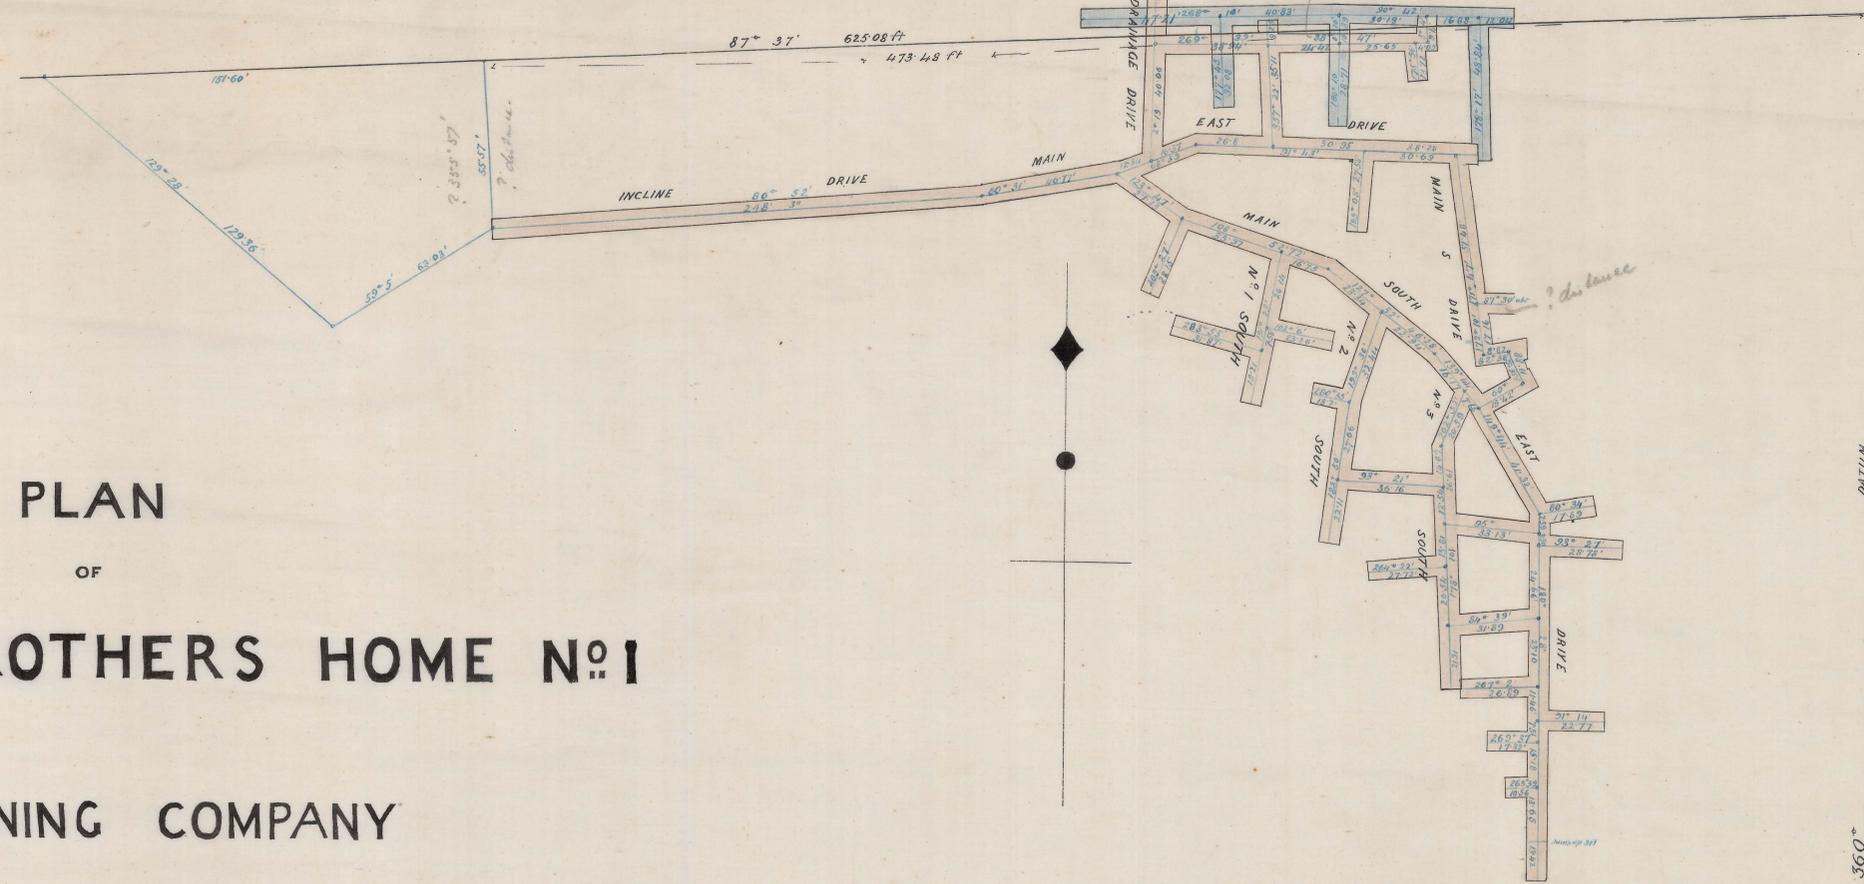

PLAN


OF

NEW BROTHERS HOME N^o 1

TIN MINING COMPANY

N^o 4 LEVEL

BRISEIS.T.M.C^o

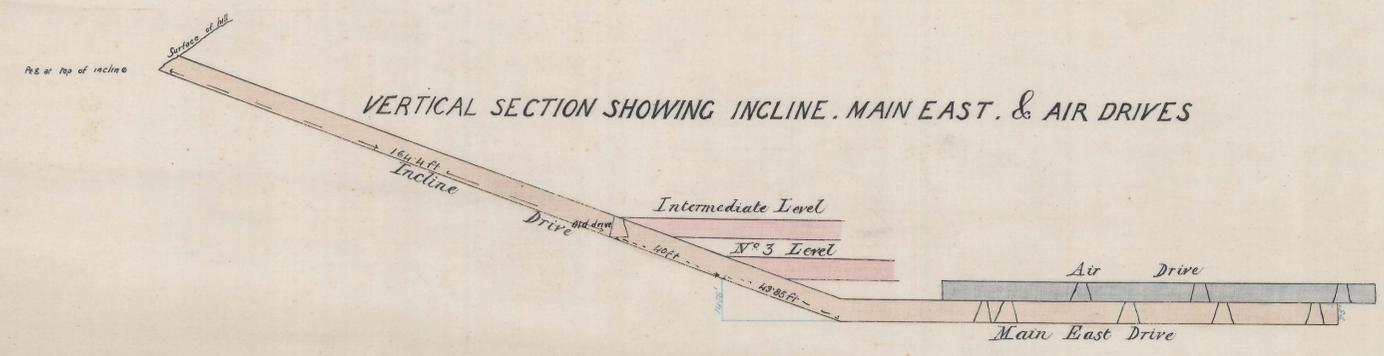

VERTICAL SECTION SHOWING INCLINE, MAIN EAST, & AIR DRIVES

- Drives at present open
- Air drives
- Abandoned workings

Scale 30 feet to an inch
 Tracing from original plan. H. F. Miles.
 Authorized Surveyor
 Swerway 14/3/93