
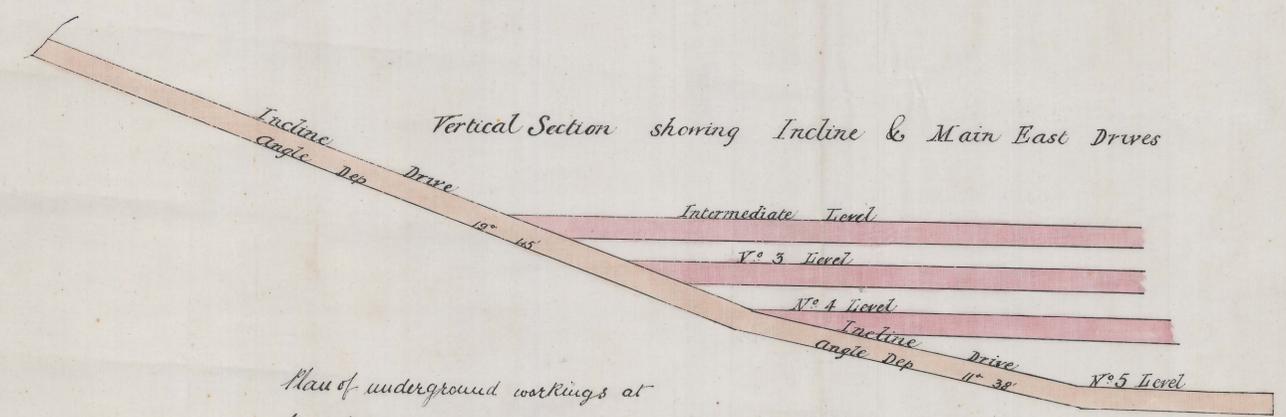


248-02

5 cm

248-02

INSPECTOR OF MINES DIVISION  
27/2/1894  
LONDON

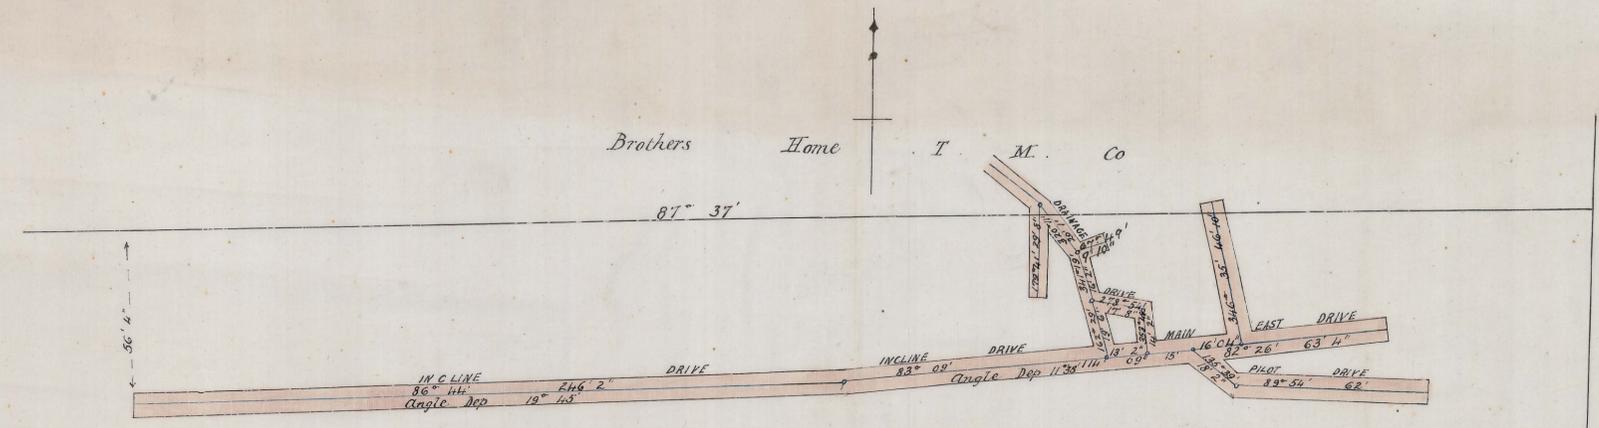

Brisels T. M. Co.

Vertical Section showing Incline & Main East Drives

Plan of underground workings at  
New Brokers Home No 1. T. M. Co.

No 5 Level. Scale 30 ft to an inch.

A. J. Miles.  
Cust. Surveyor.

11<sup>th</sup> Jan. '94

This survey was made with a six inch  
V. theodolite and steel band chain in correct adjustment.  
and shows drives open on the 8<sup>th</sup> July 1894.

2/1/94