


Briseis Co.



Scale 20 feet to 1 Inch

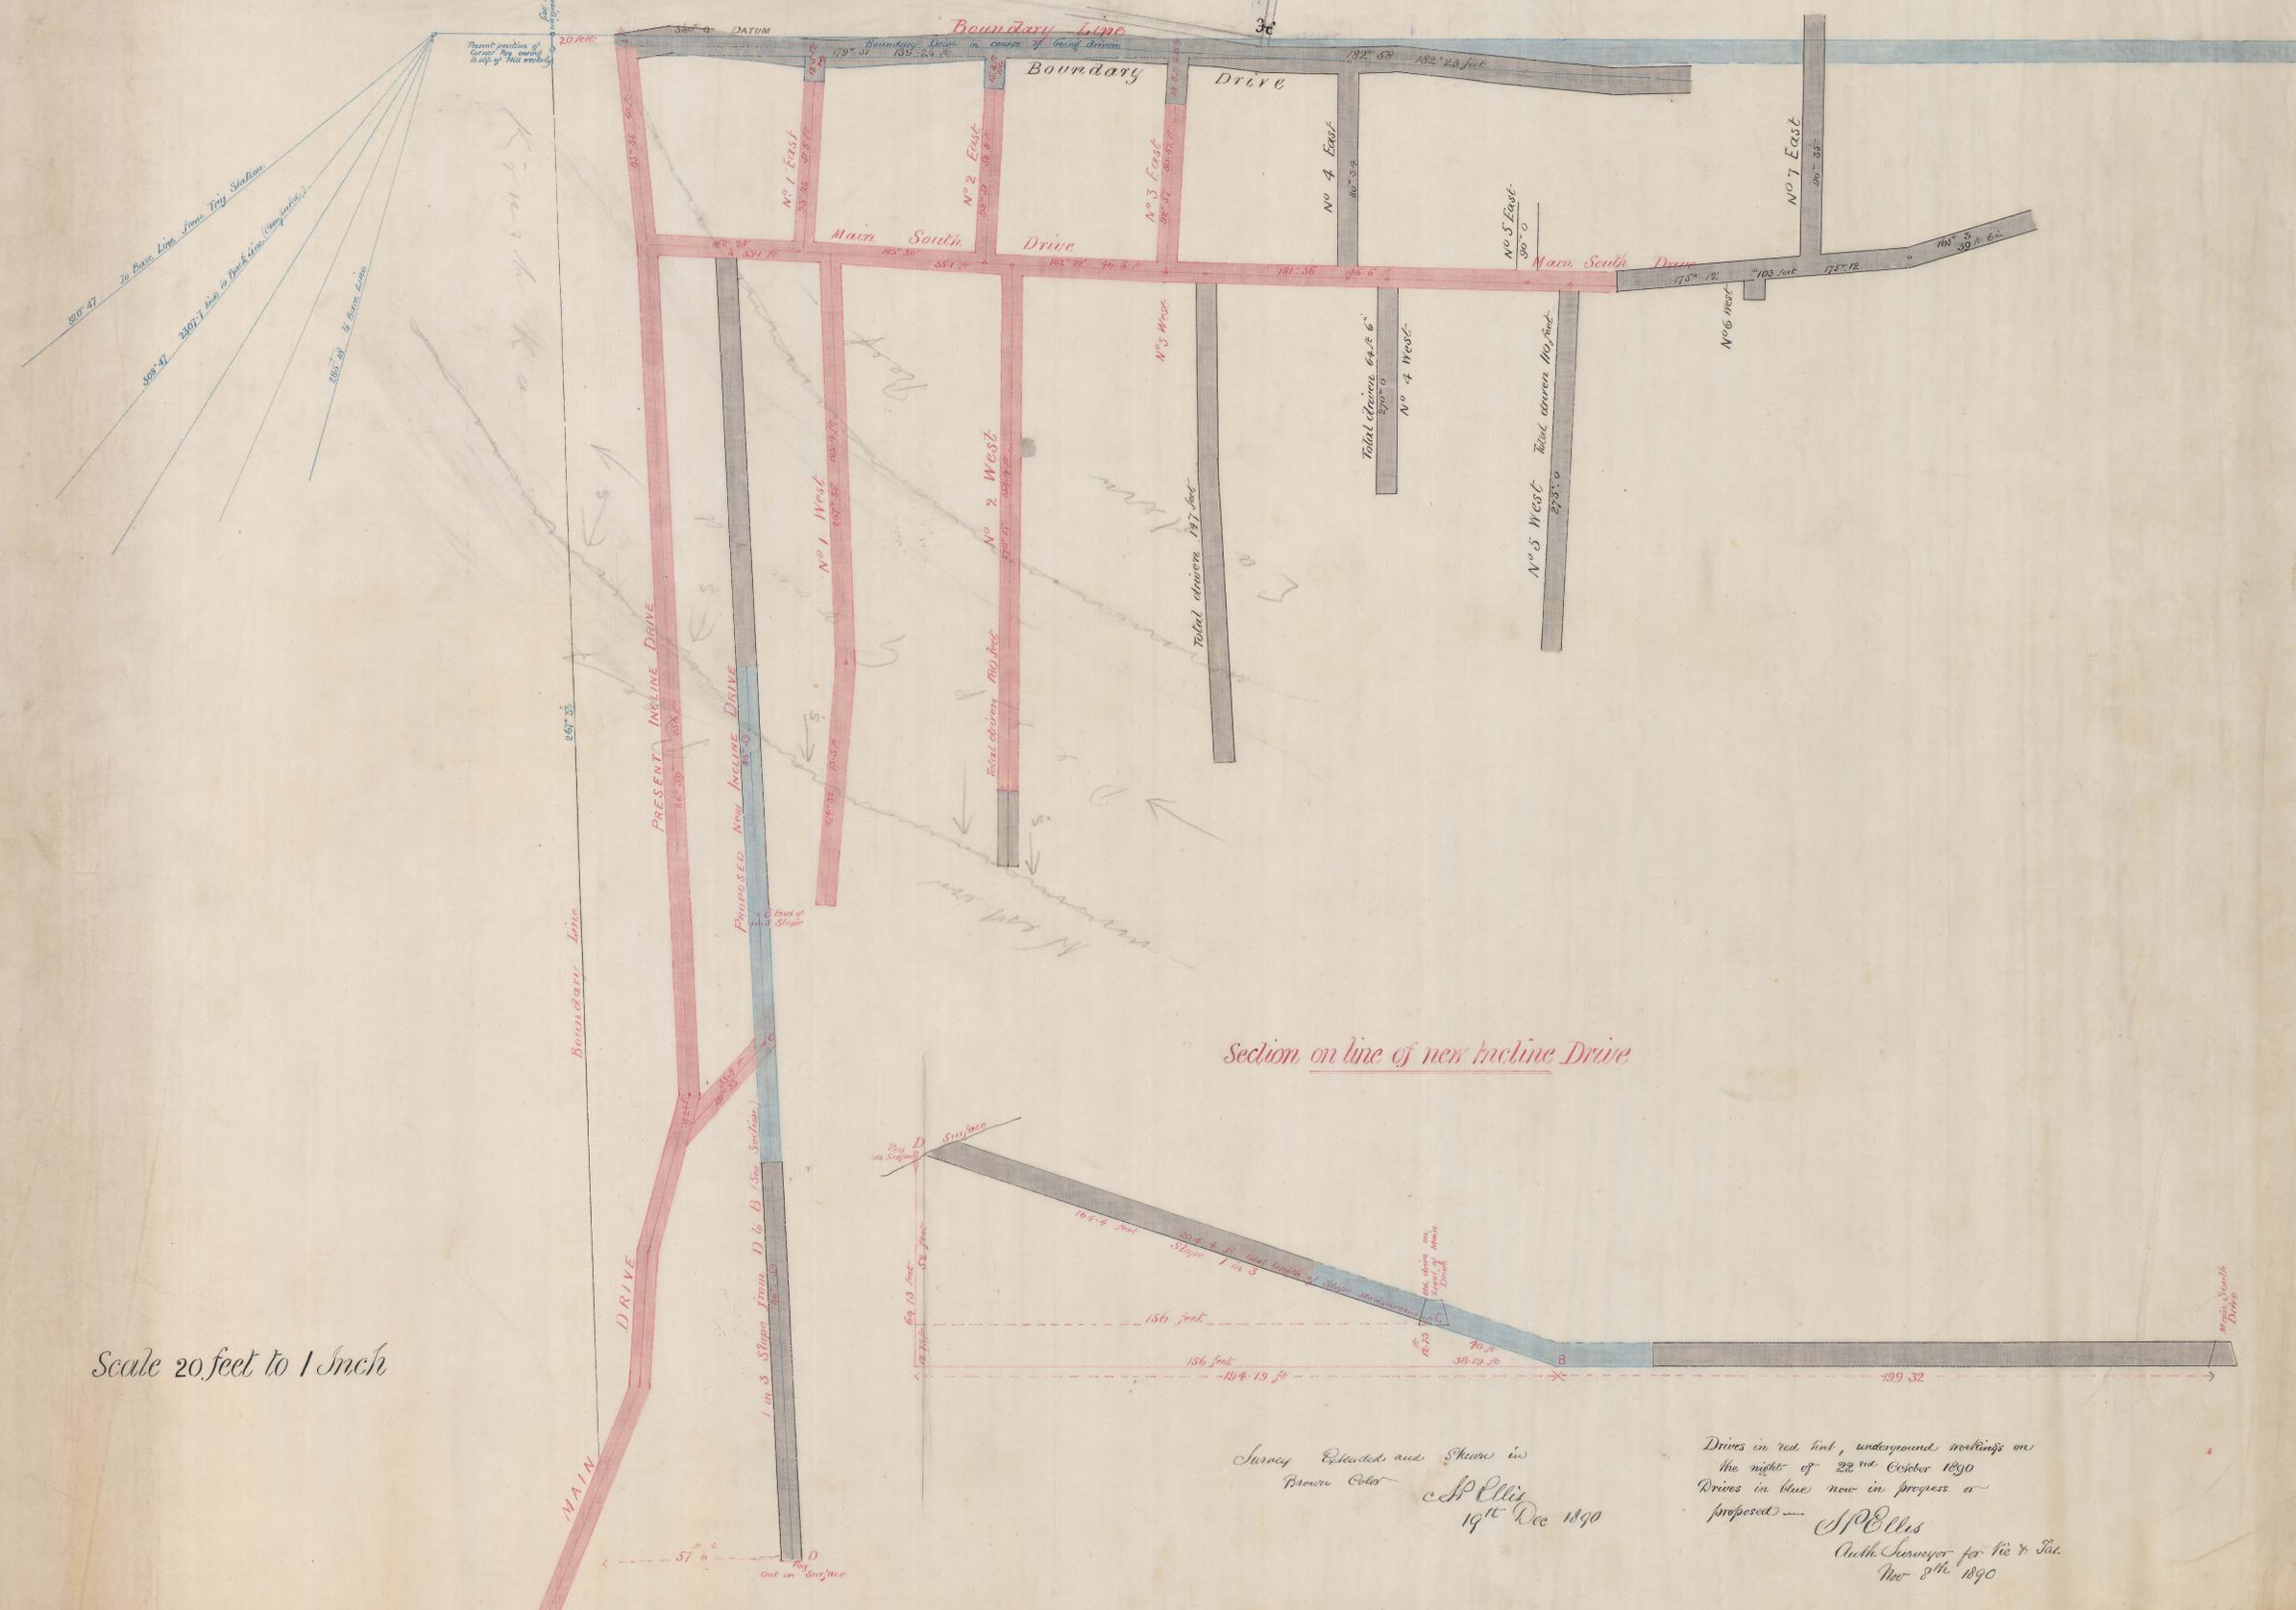

Survey Planned and Shown in
Brown Color
J.P. Ellis
19th Dec 1890

Drives in red tint, underground workings on
the night of 22nd Oct 1890
Drives in blue now in progress or
proposed
J.P. Ellis
Auth. Surveyor for Vic & Tas.
Nov 8th 1890

248-04

248-04

248-04