


No 236
93M 80 AC:

No 239
93M
60 AC:

No 216
93M
68 AC:

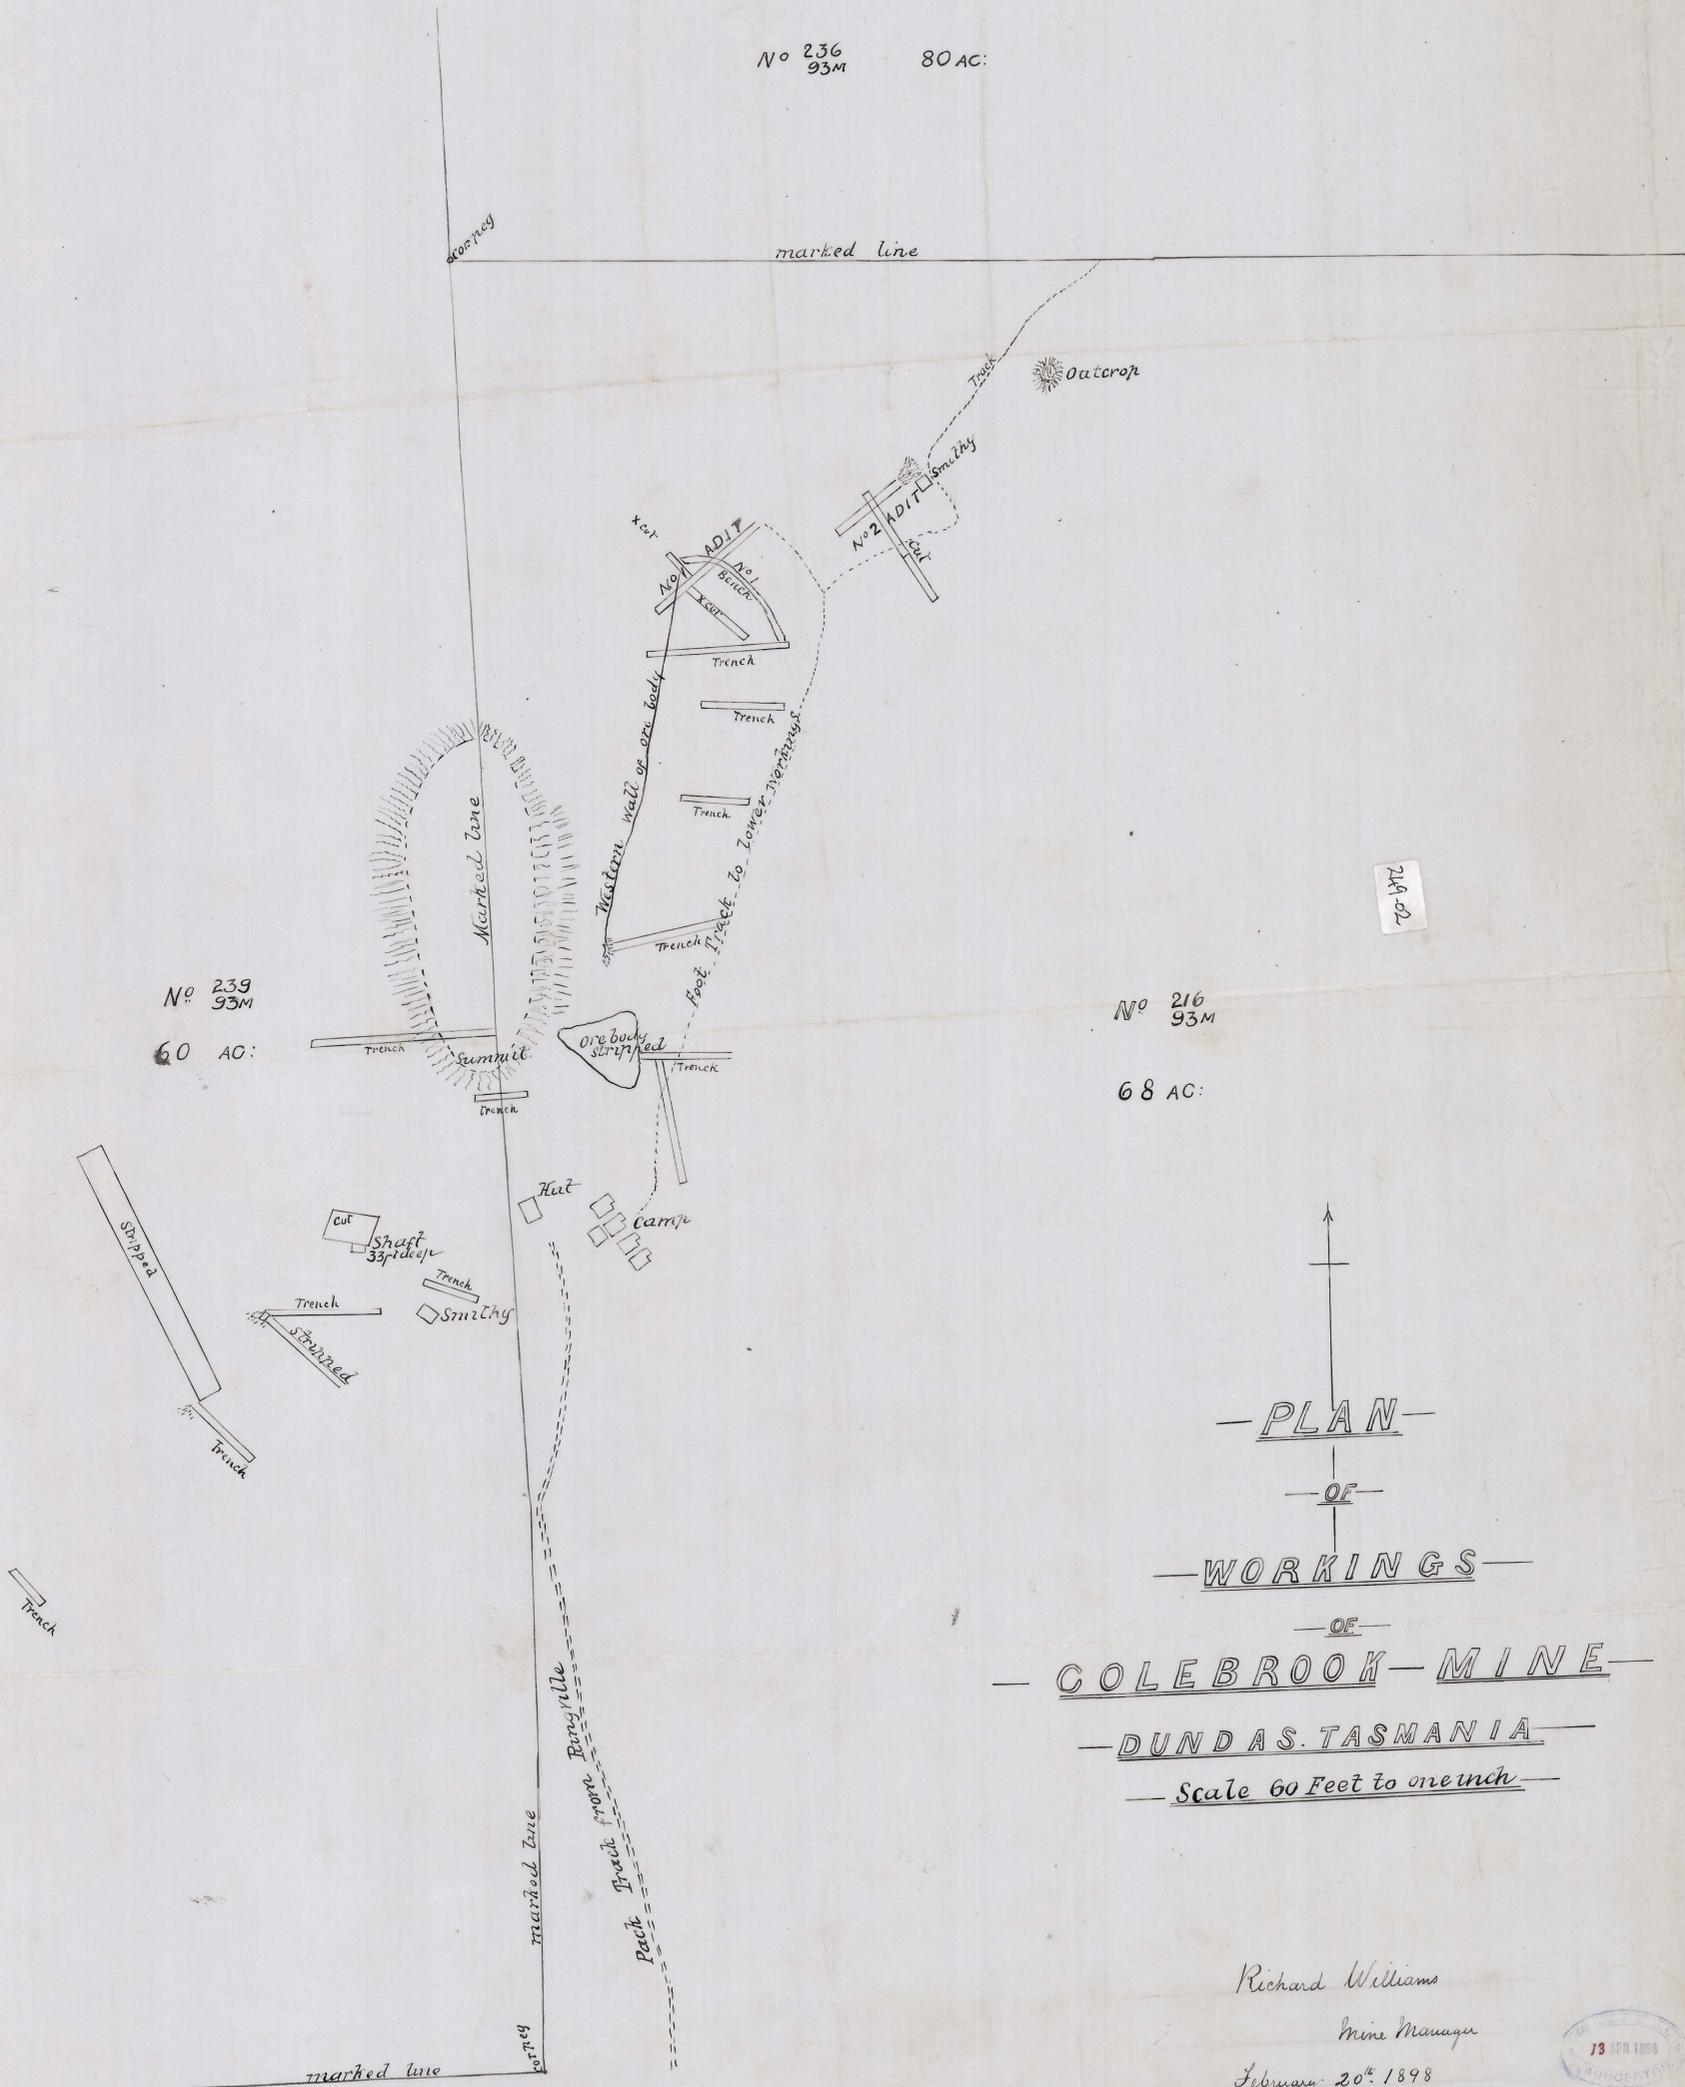

— PLAN —
 — OF —
 — WORKINGS —
 — OF —
 — COLEBROOK — MINE —
 — DUNDAS, TASMANIA —
 — Scale 60 Feet to one inch —

Richard Williams
 Mine Manager
 February 20th 1898



249-02