


MOUNT BLACK PROPRIETARY MINING COMPANY No LIA


59
93M

—Scale 30 Feet to 1 inch—


—PLAN—

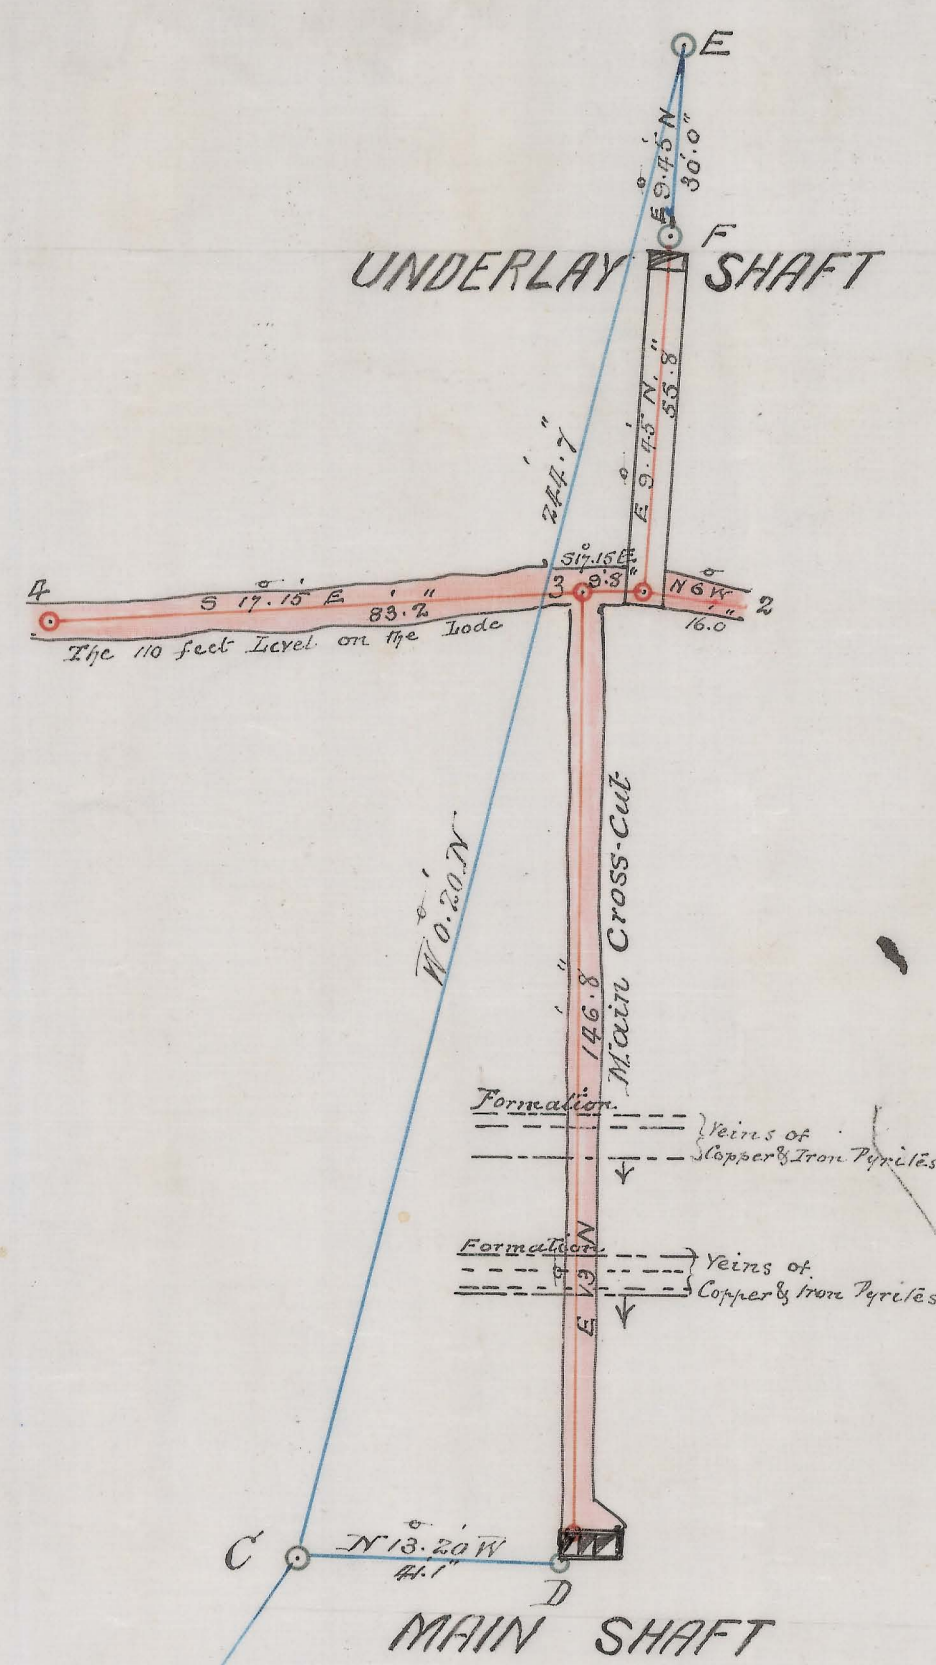

—TRANSVERSE SECTION—

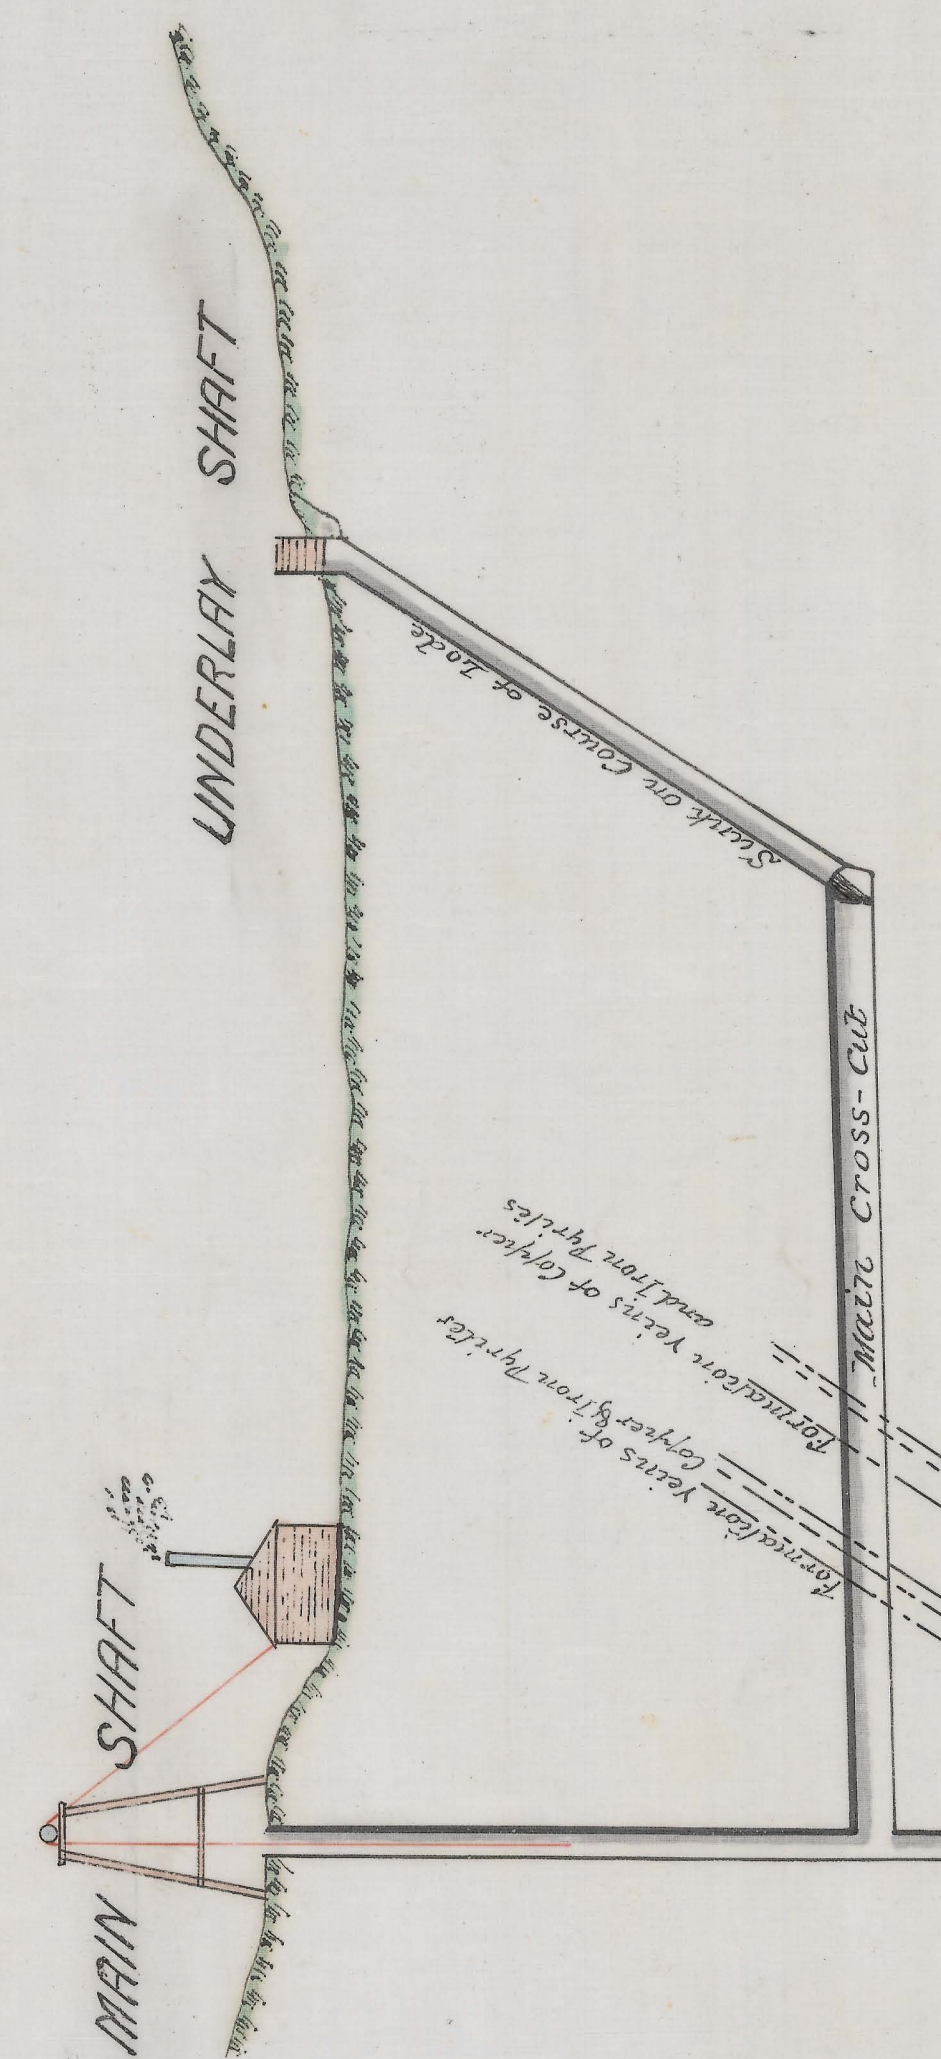

—LONGITUDINAL SECTION—

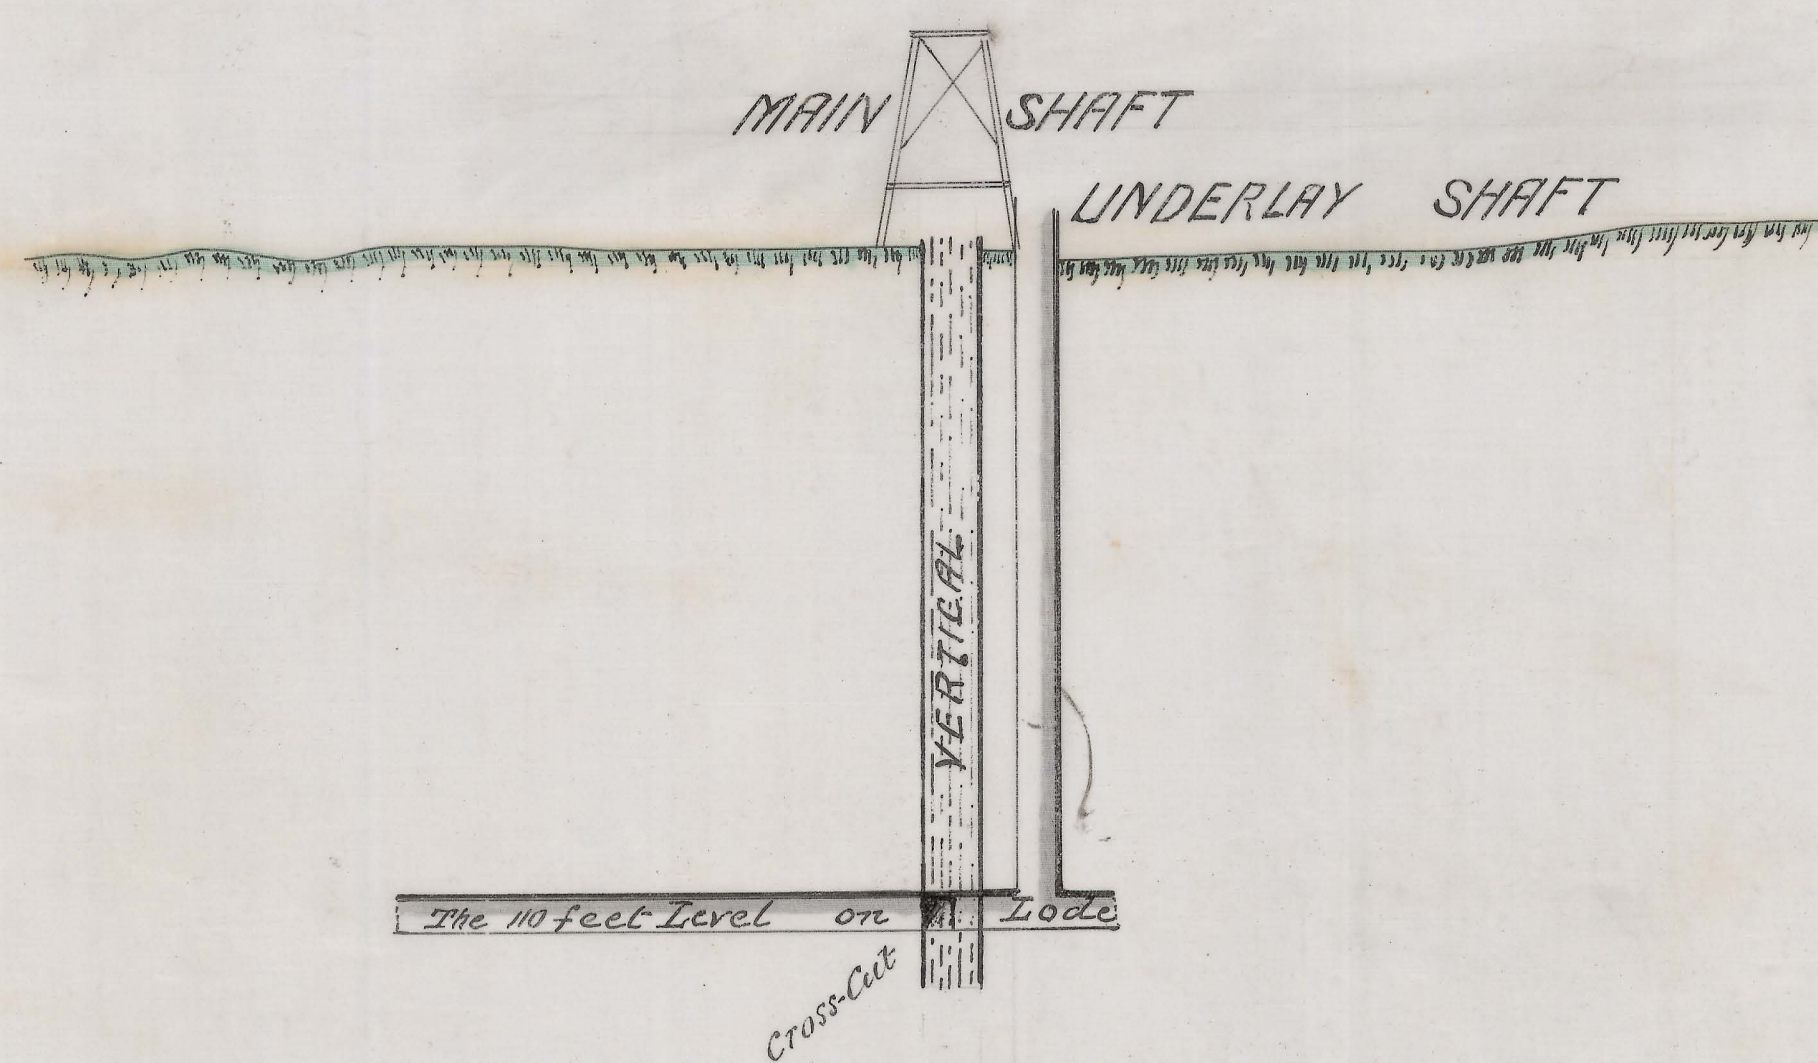

W. H. Wesley Sonr.
28th February 1900

