



256-01

256-01

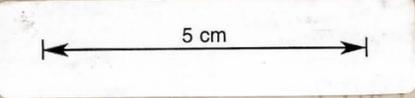

Mount Cygnet Coal Company
Gardners Bay Port Cygnet.
Scale One chain to an Inch.

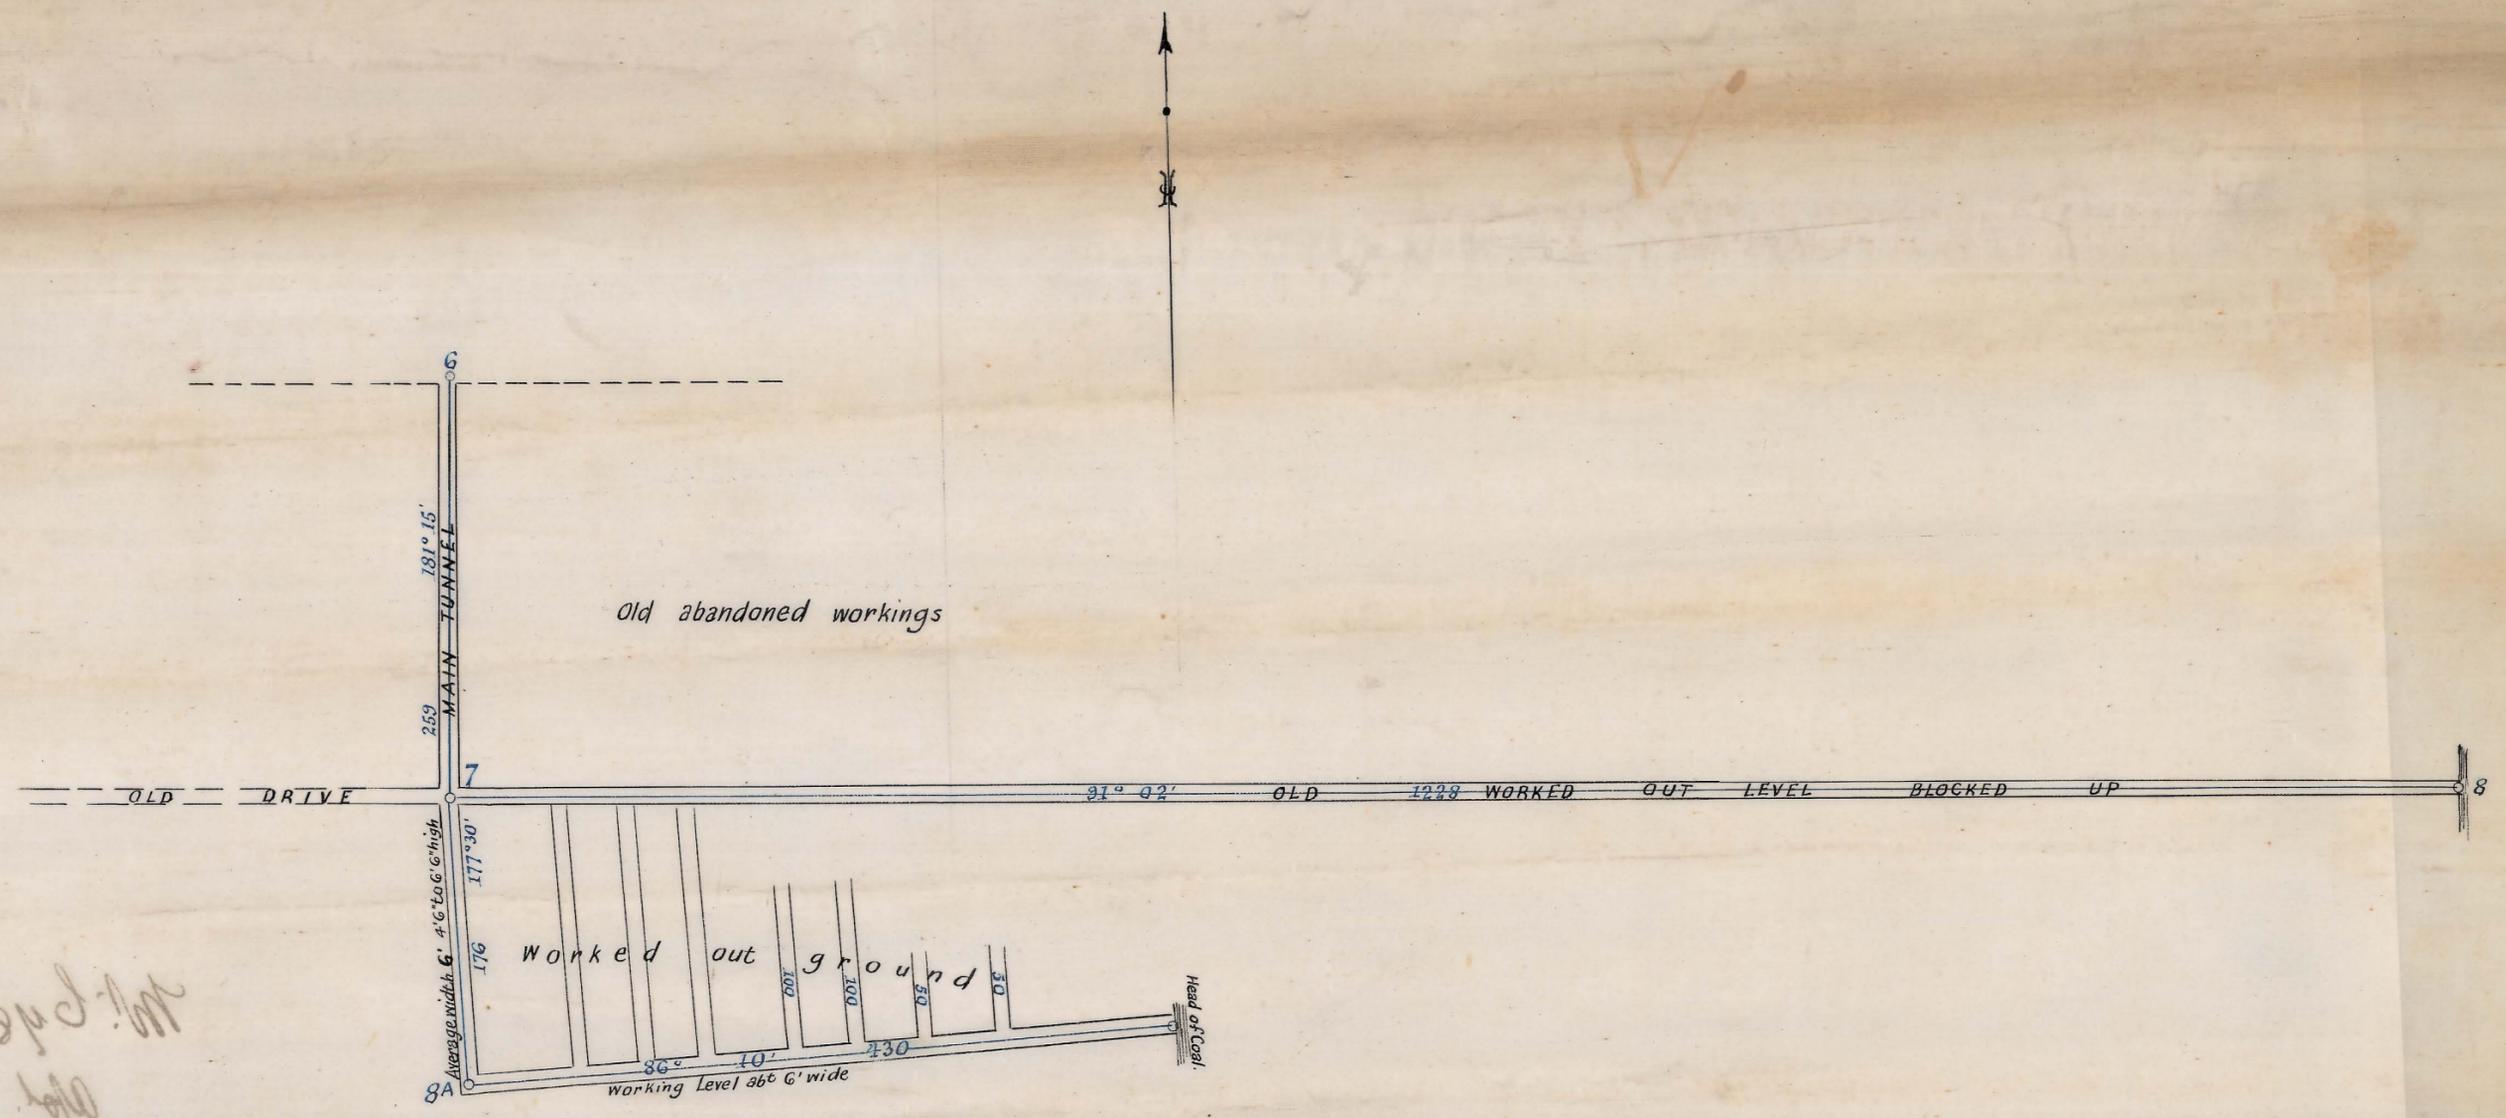

Mr. Phoebe Col
Apr 1805



Elphinstone

District Surveyor
March 1902.

102

105