


5 cm

256-02

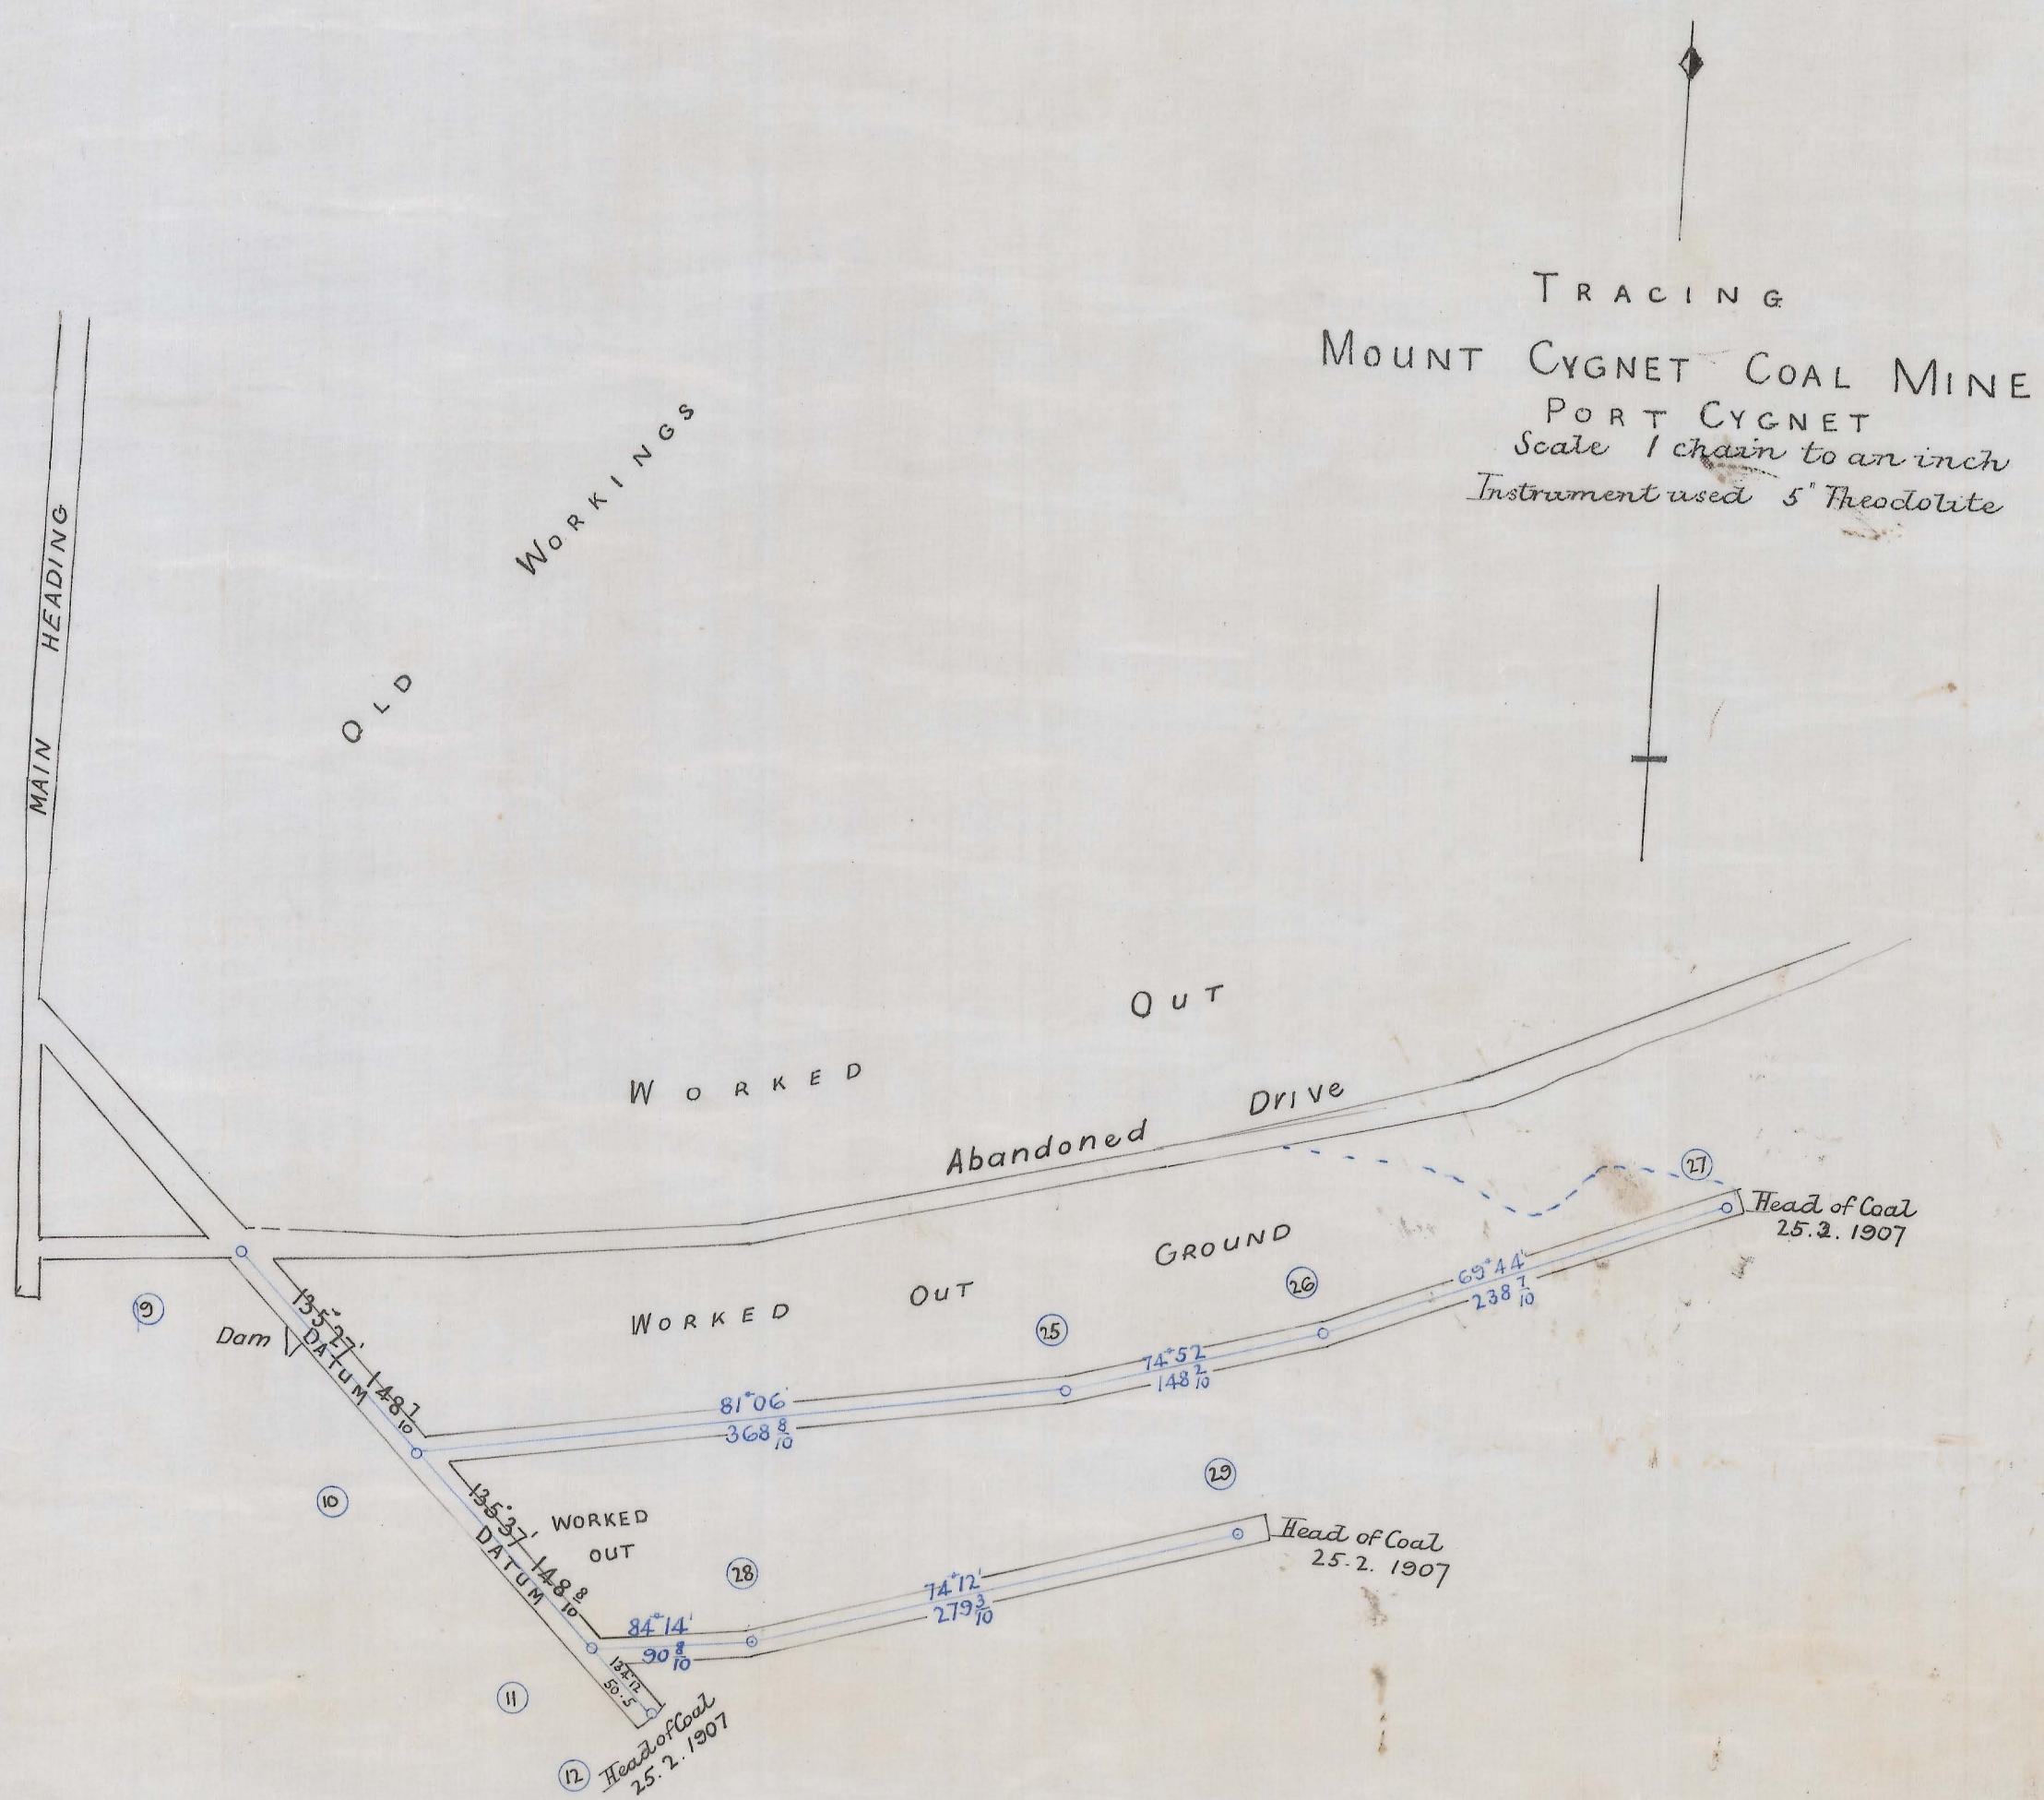

I hereby certify that this tracing
is a copy of plan of Mt Cygnet Coal Mine

B. R. R. R. R.

And Surveyor

Date. Surveyed. 25. 2. 1907

