

256-03


5 cm

256-03

Mount Cygnet Coal Company
Gardners Bay - Port Cygnet.

Extension of workings

Scale One Chain to an Inch.

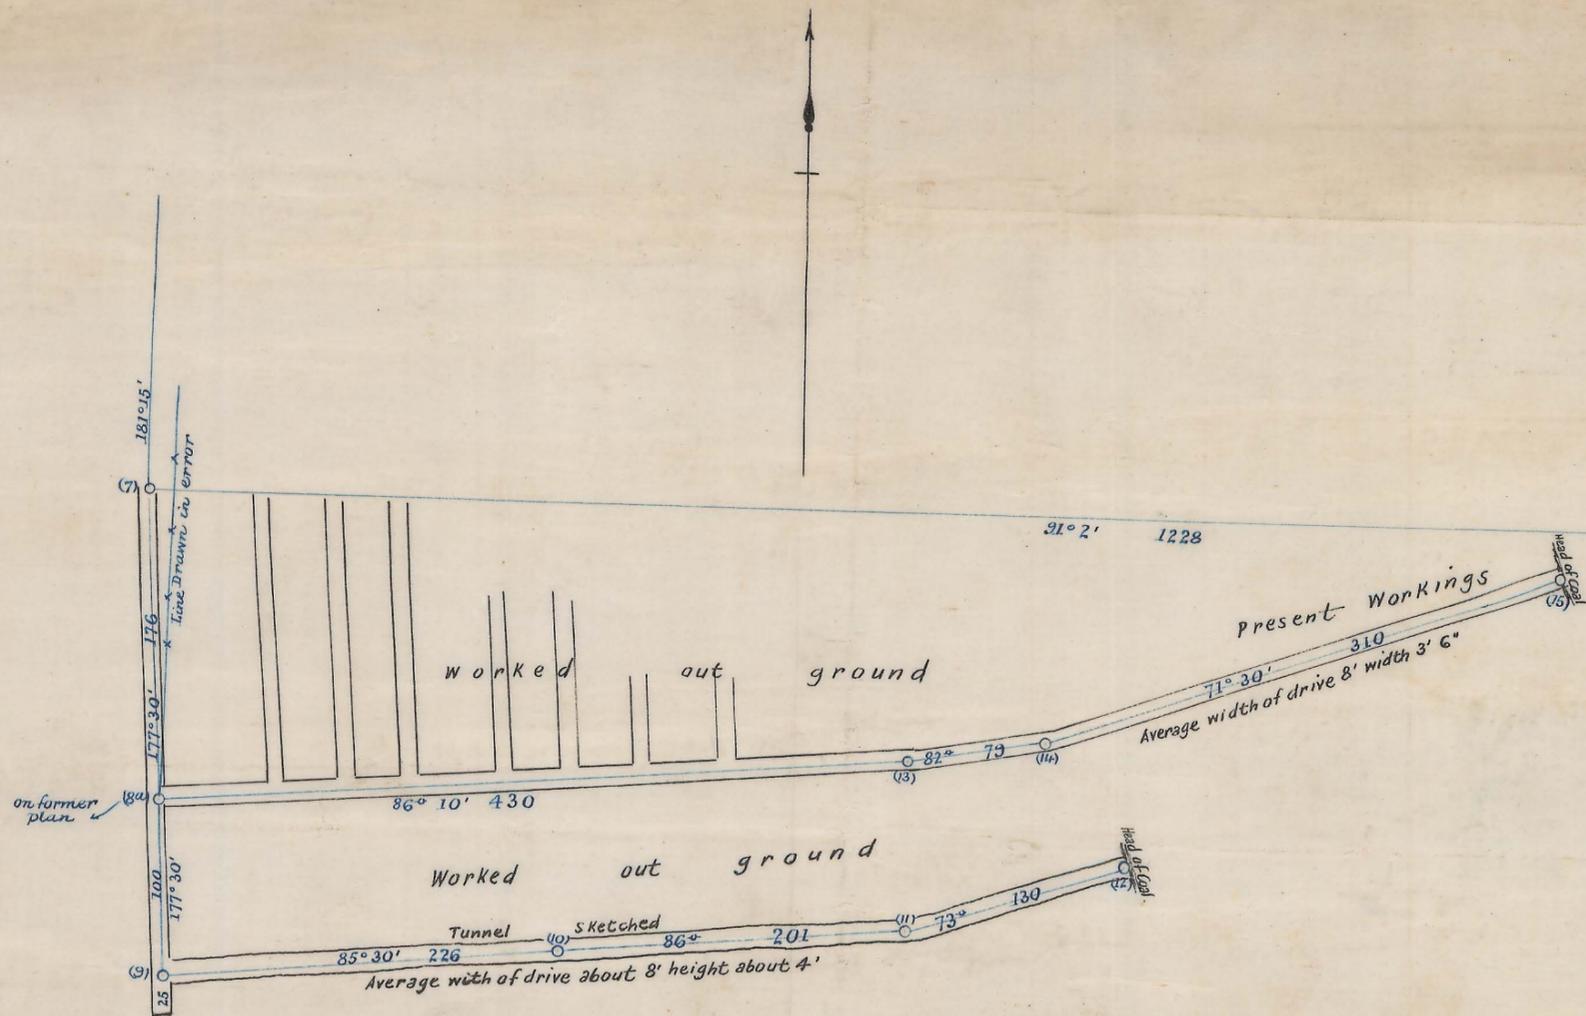

Inspector. Mines Dept.



Elymore

Mining Surveyor.

Oct. 1903.