


256-04

256-04
W. J. ...
20th Nov 1905

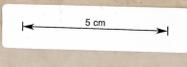



MOUNT CYGNET COAL MINE

PORT CYGNET

SCALE 1 CHAIN TO AN INCH

Instrument used "Theodolite"

Frank K. Pitt
31/7/05

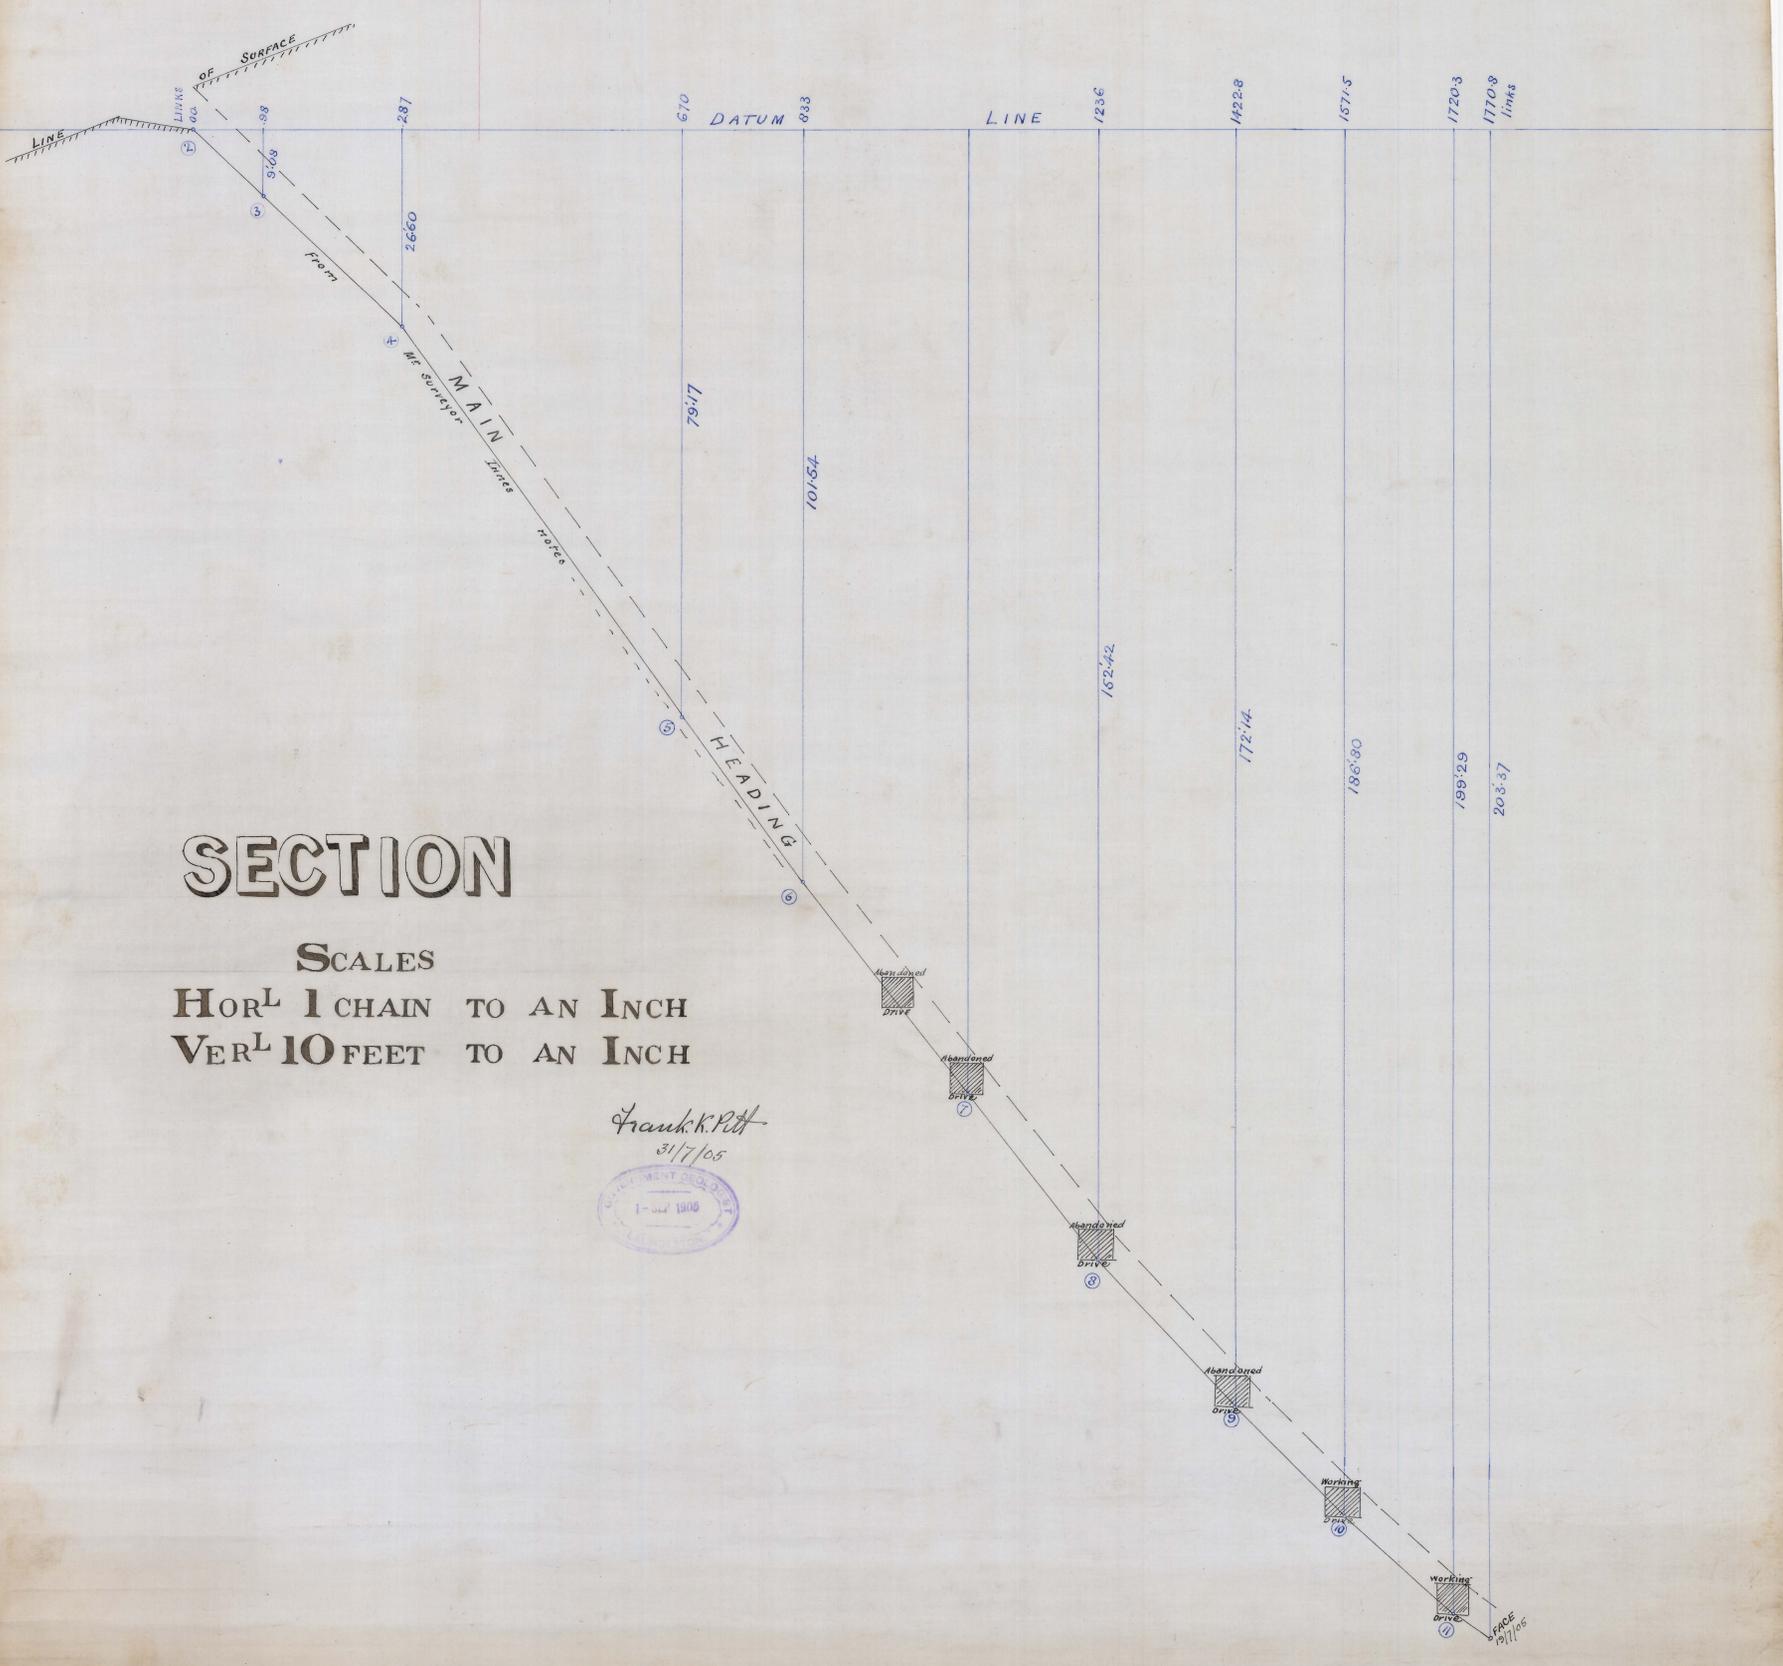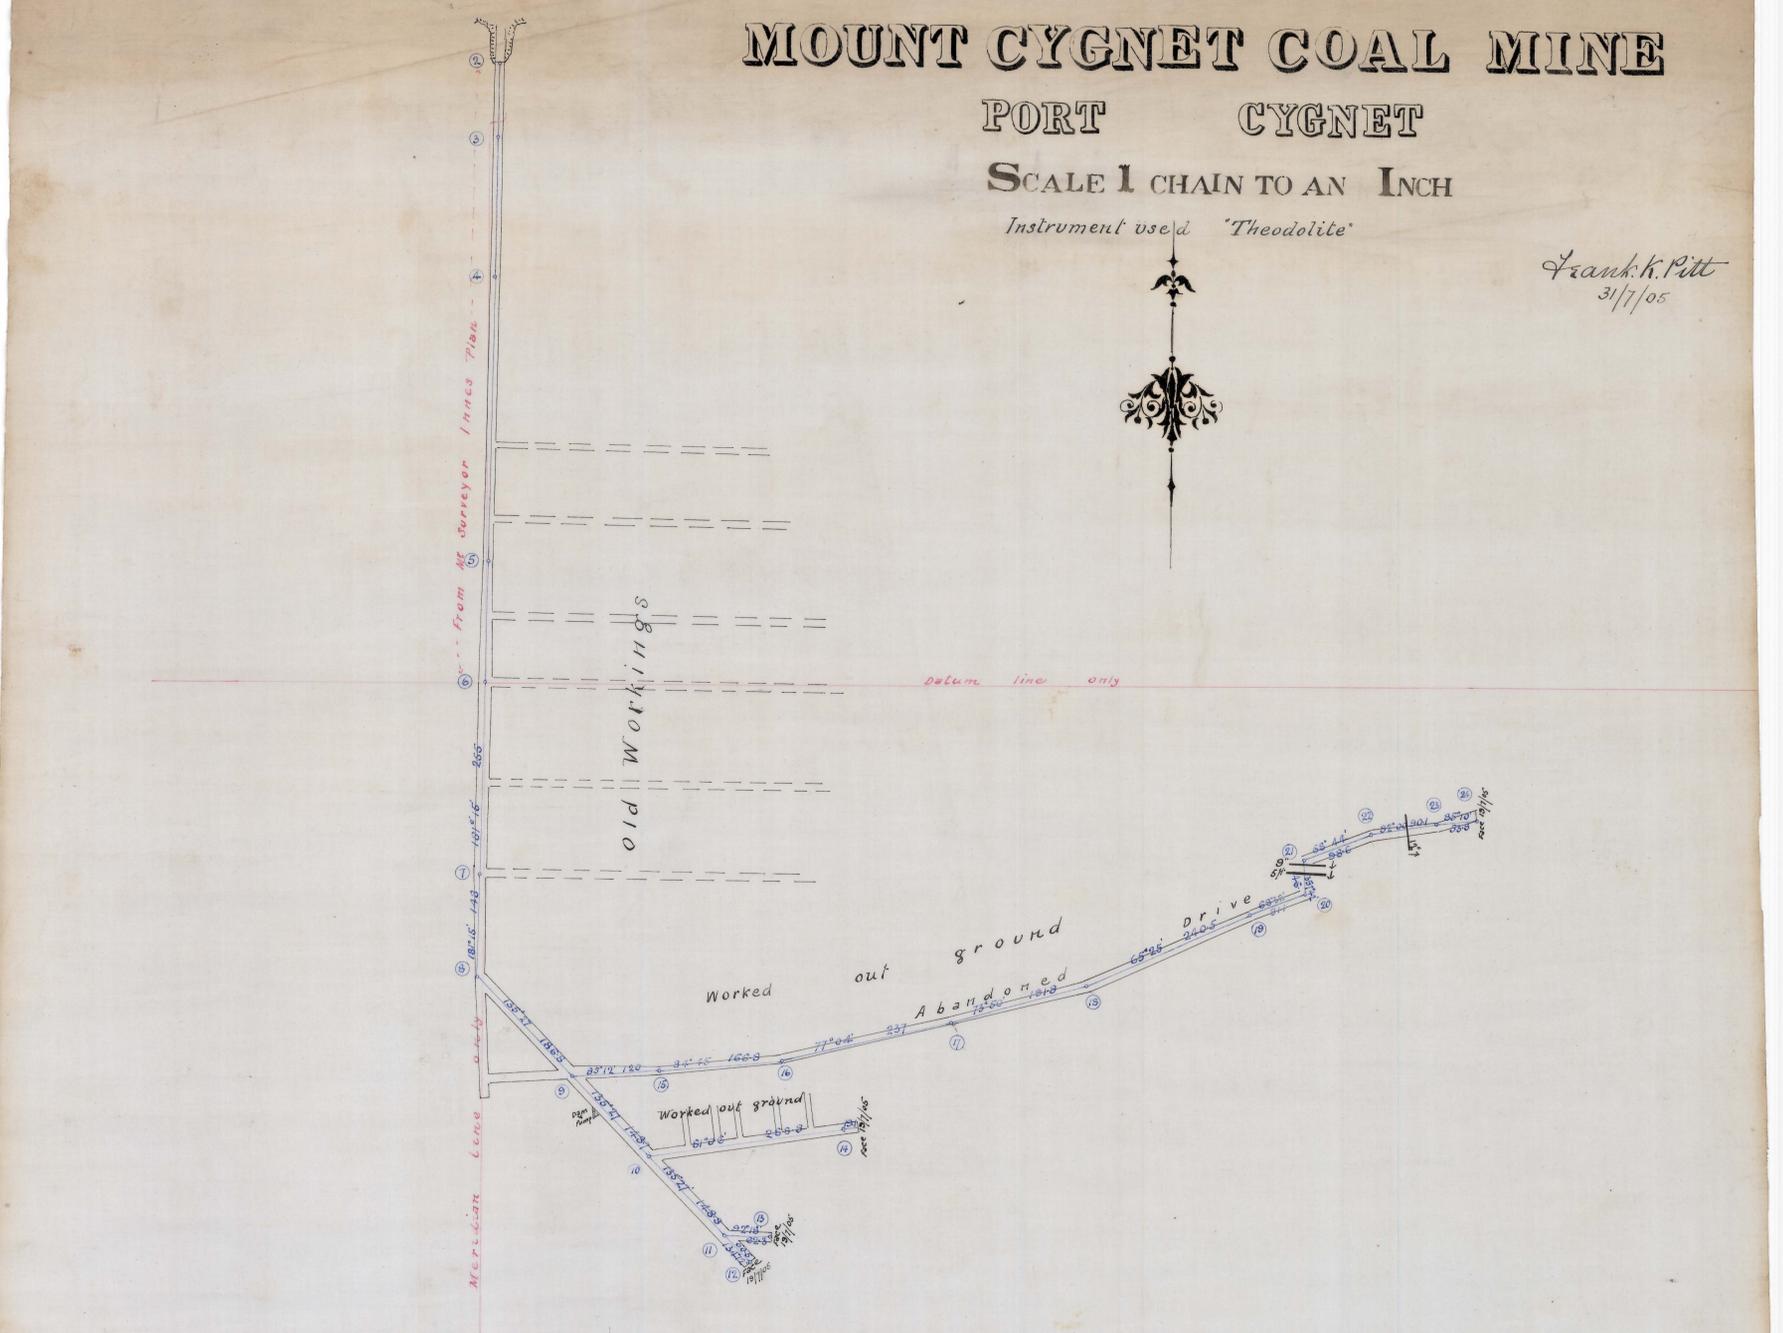

SECTION

SCALES
HOR^L 1 CHAIN TO AN INCH
VER^L 10 FEET TO AN INCH

Frank K. Pitt
31/7/05

