


SPREYTON COLLIERY

Scale 40 ft to 1 inch



343°
415' 10"

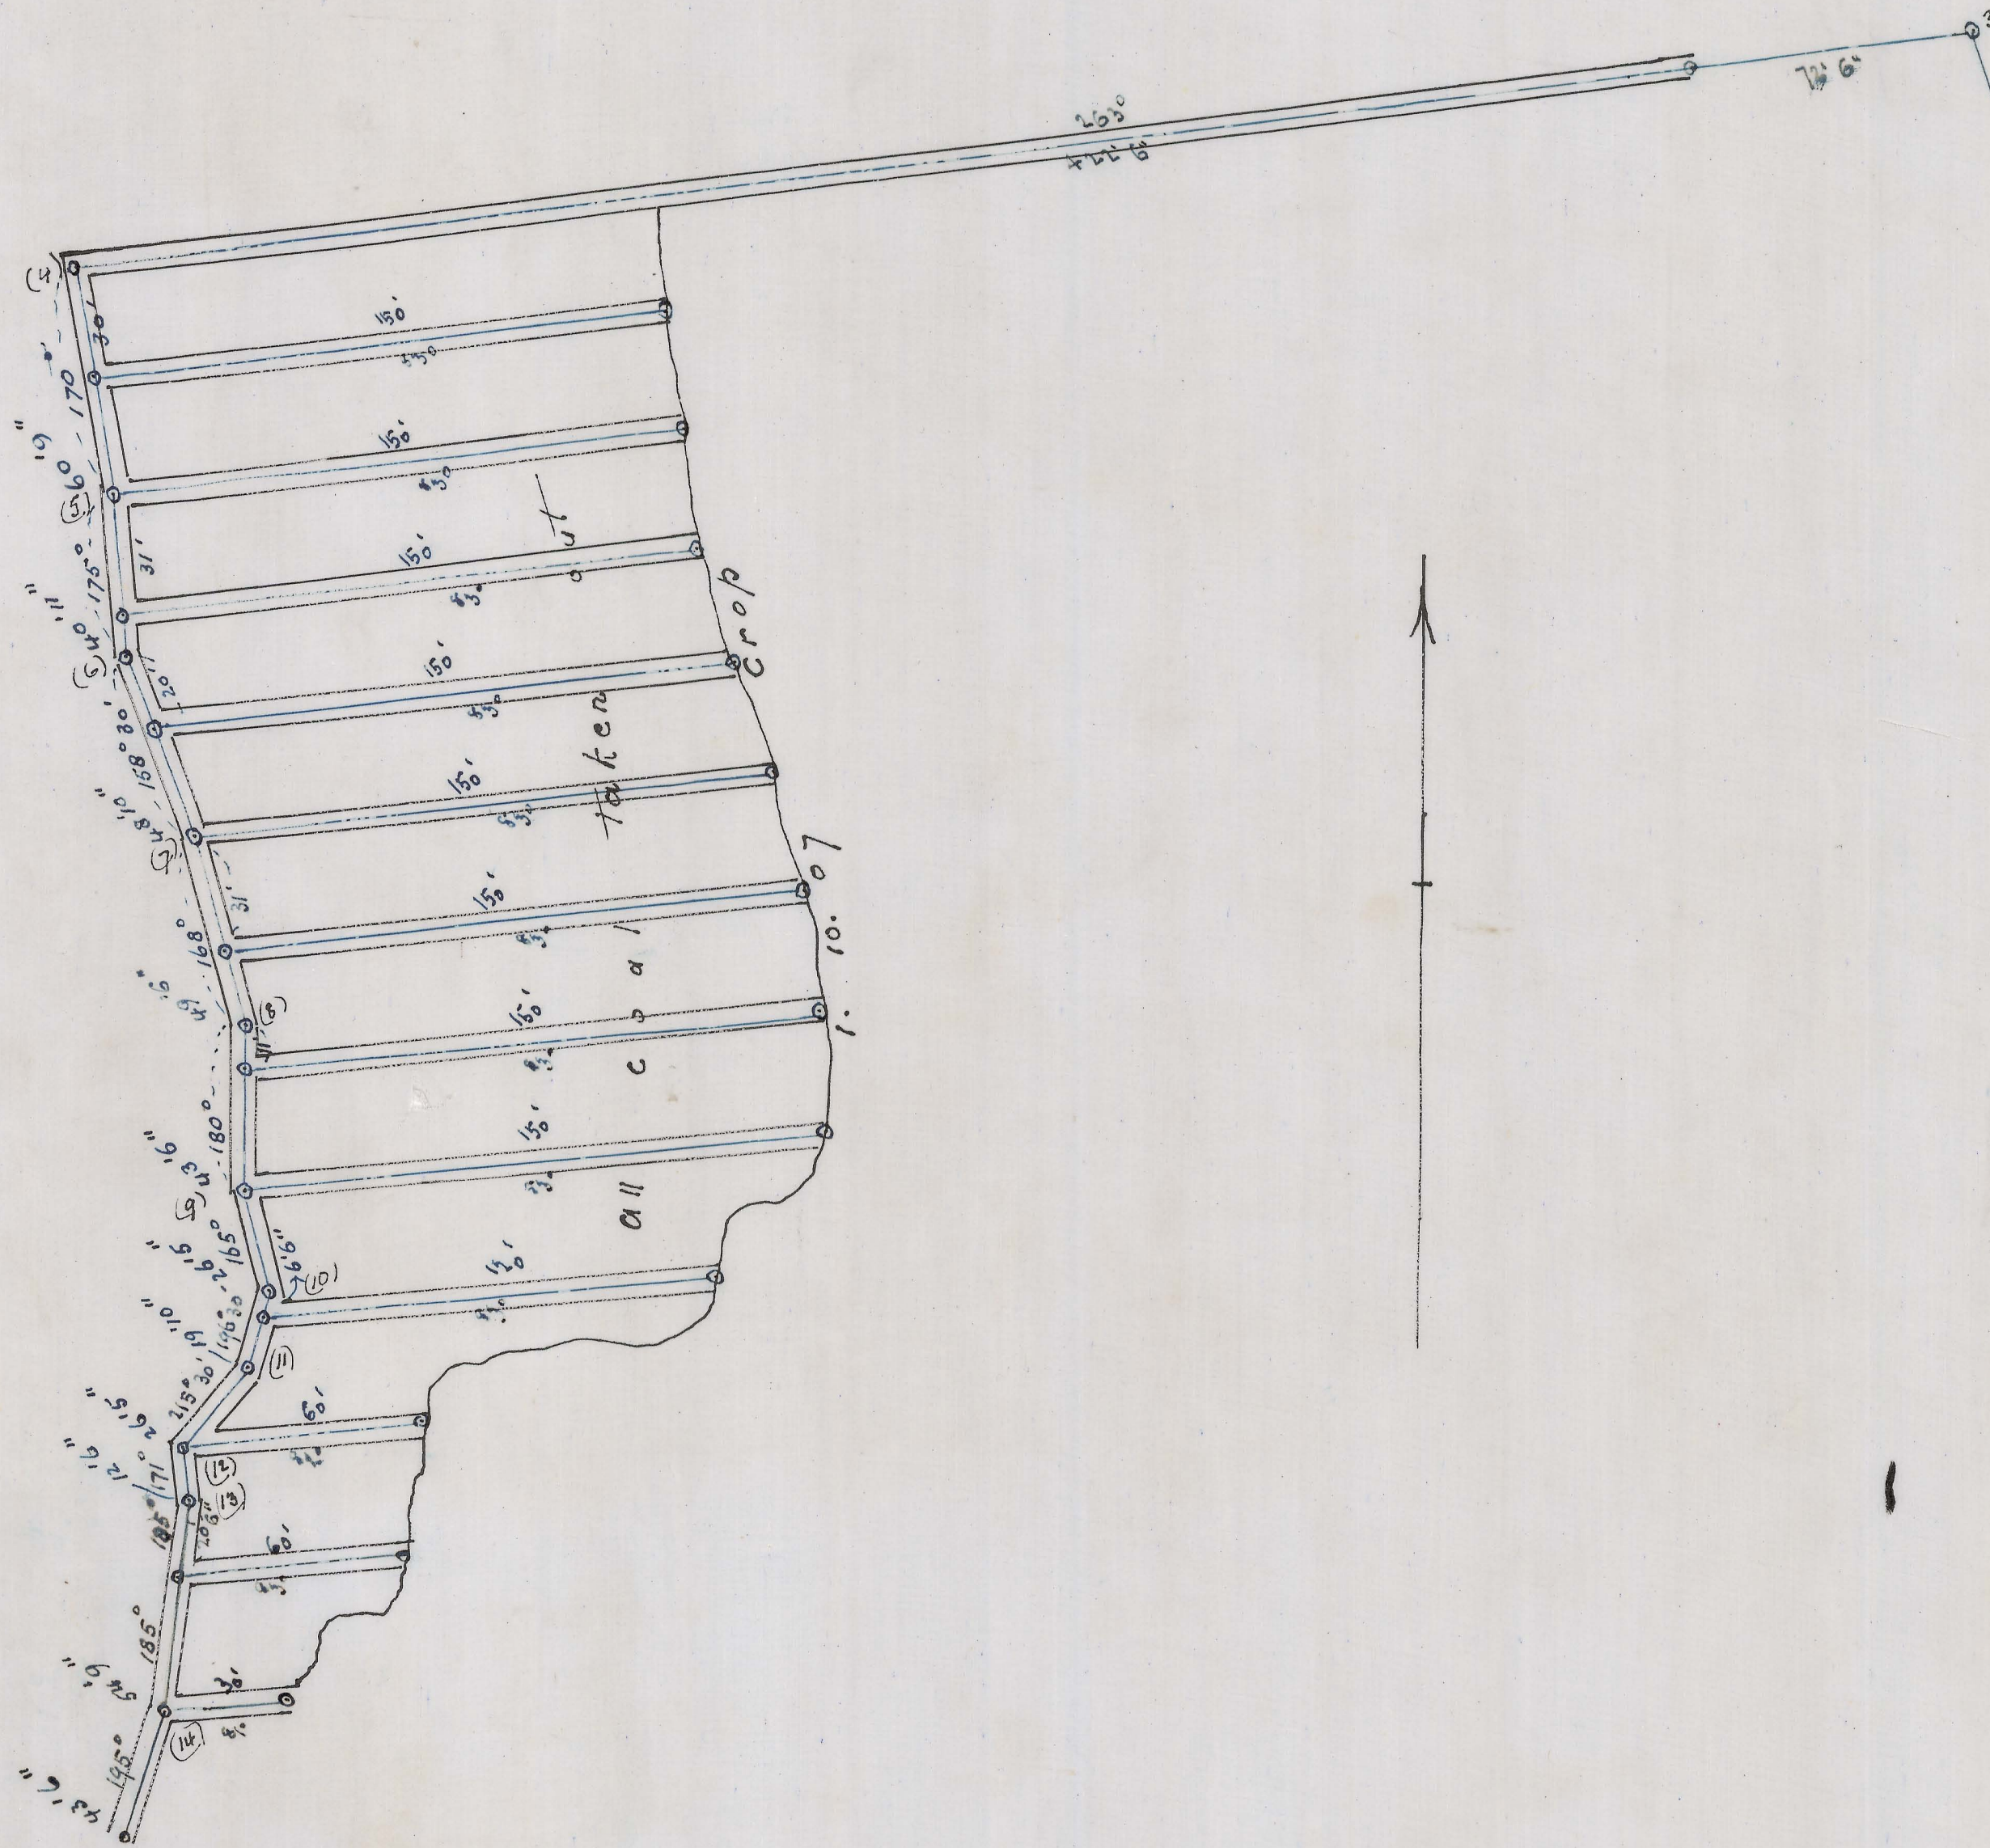

BYE ROAD

Centre of MAIN ROAD to Latrobe

Survey of mine with Prismatic Compass
impossible to get theodolite underground
Angles taken with compass & reduced to meridian
of road
C. J. Smith
1. 10. 07

257-02

5 cm

257-02

181
Spreyton Colliery