


5 cm


W. A. Miller
Buller's Creek
Oct. 1907
9. 10. 1907

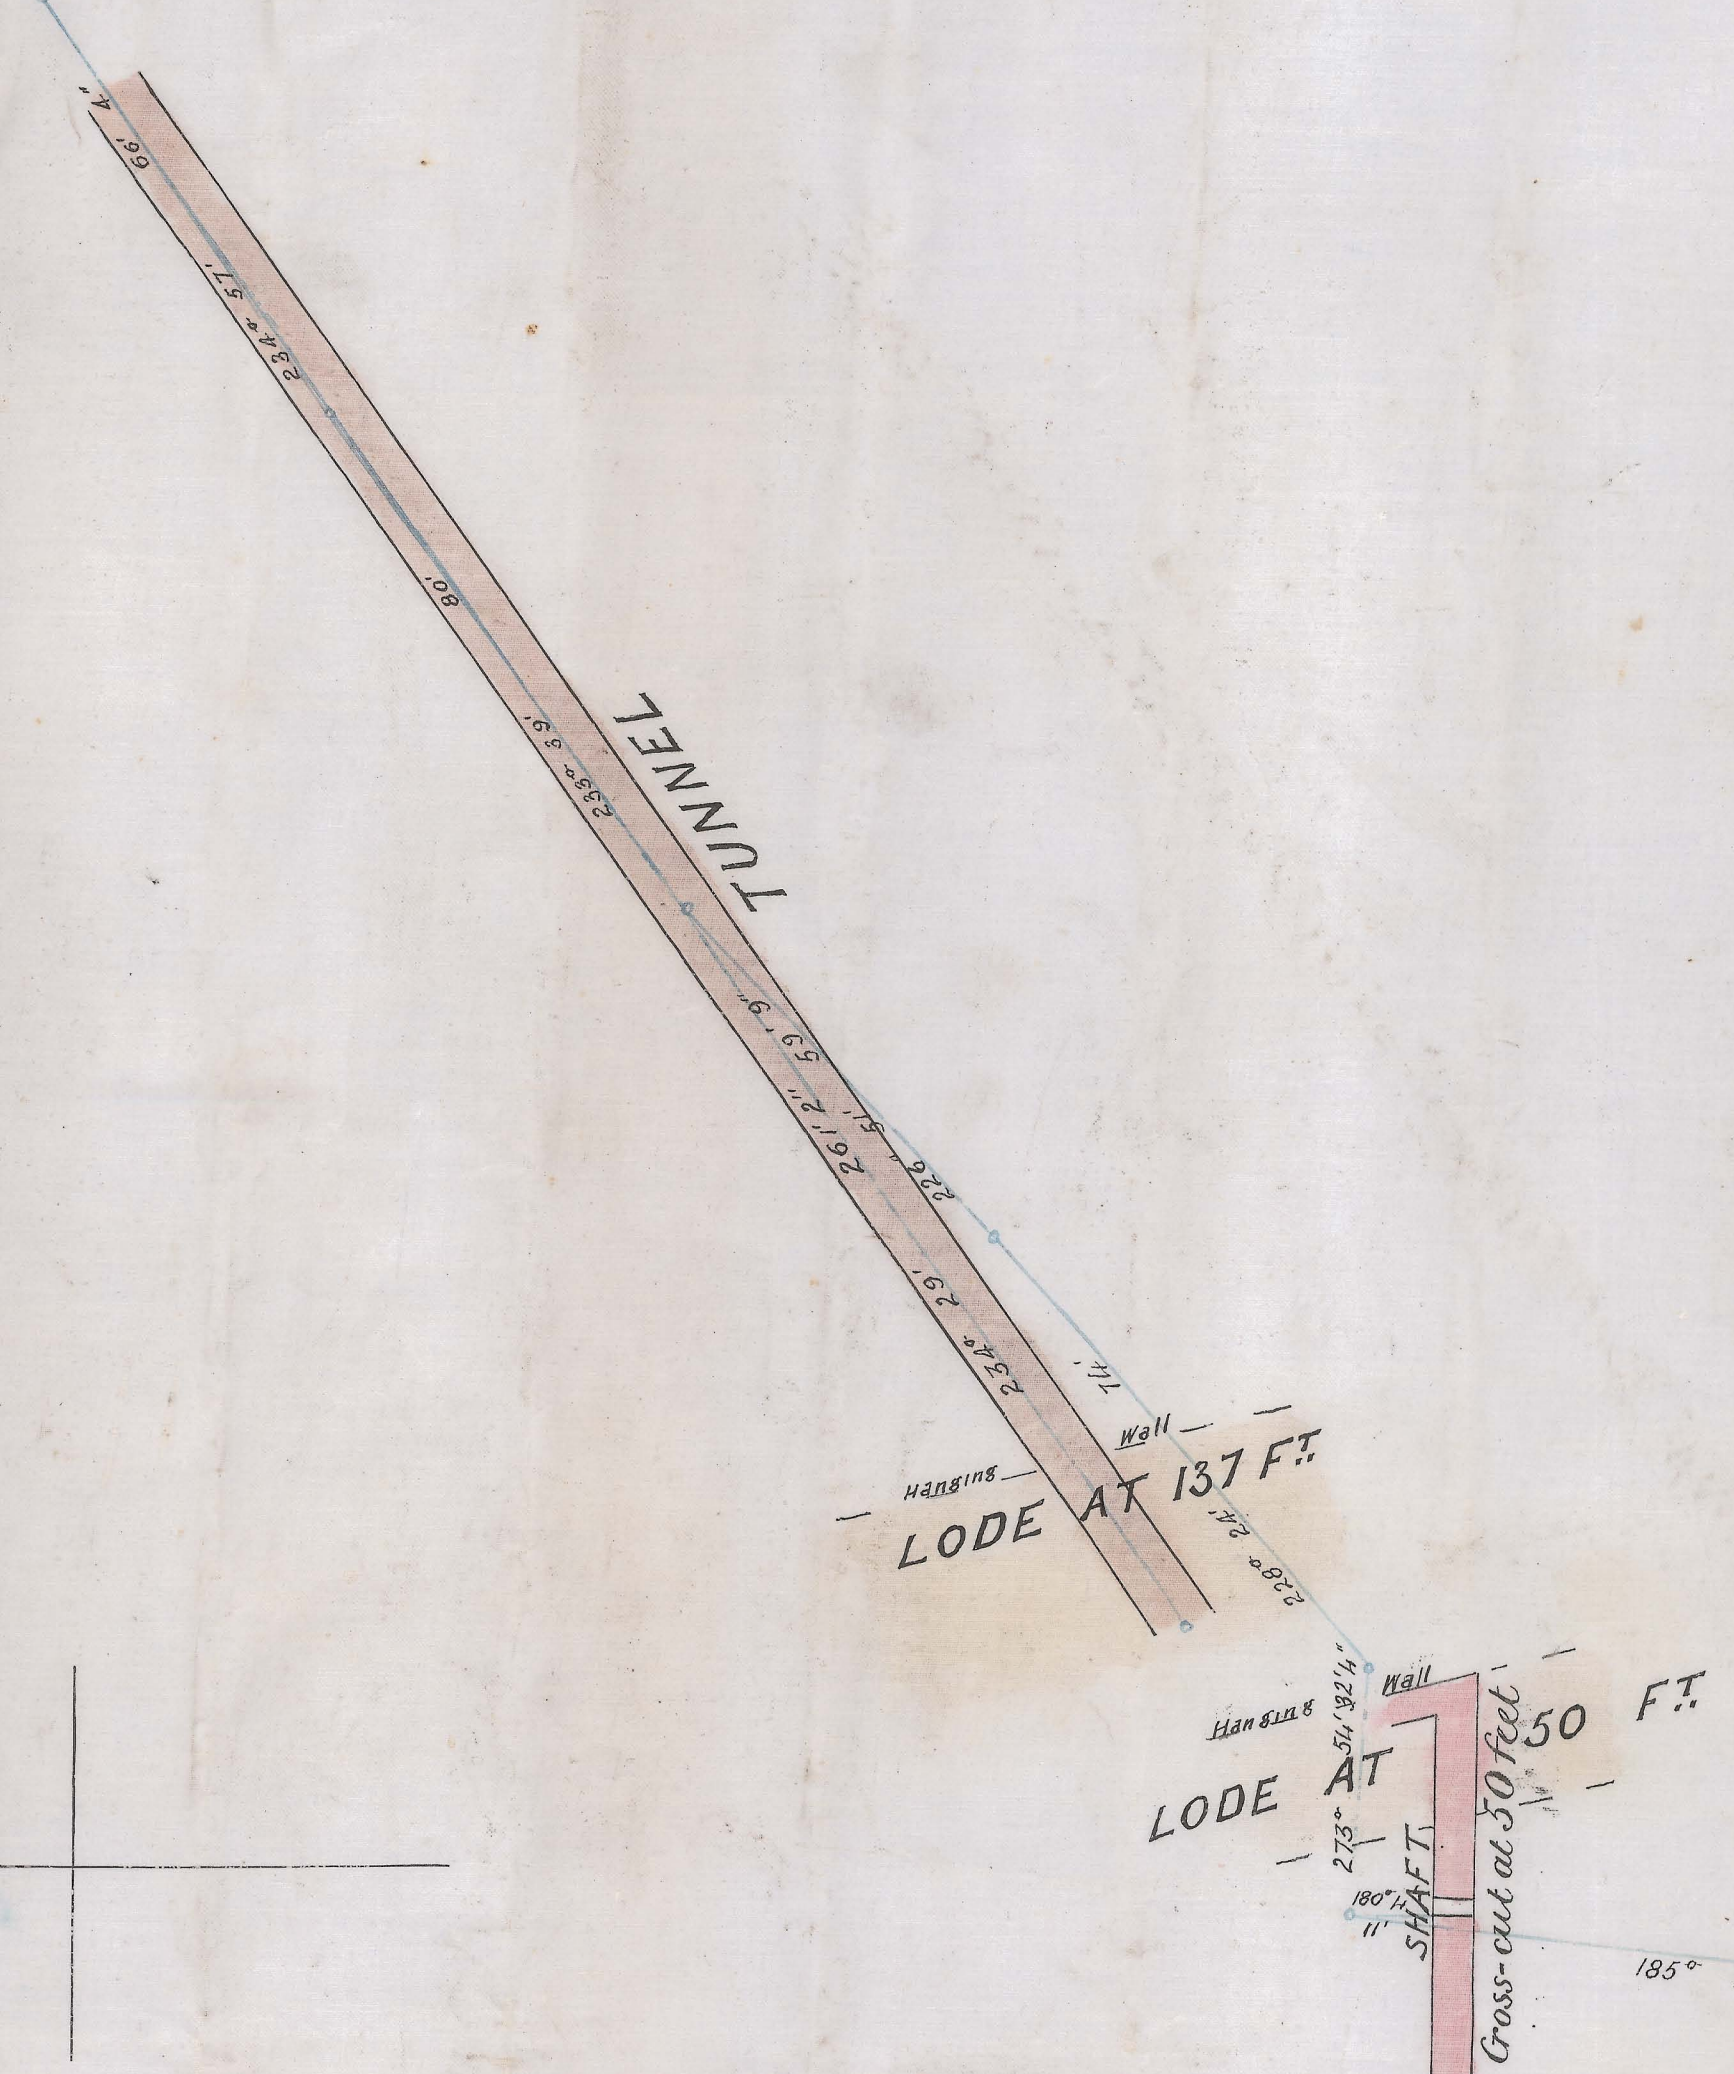

258-a

RING P. A. N. L.

Scale 25 feet to an inch

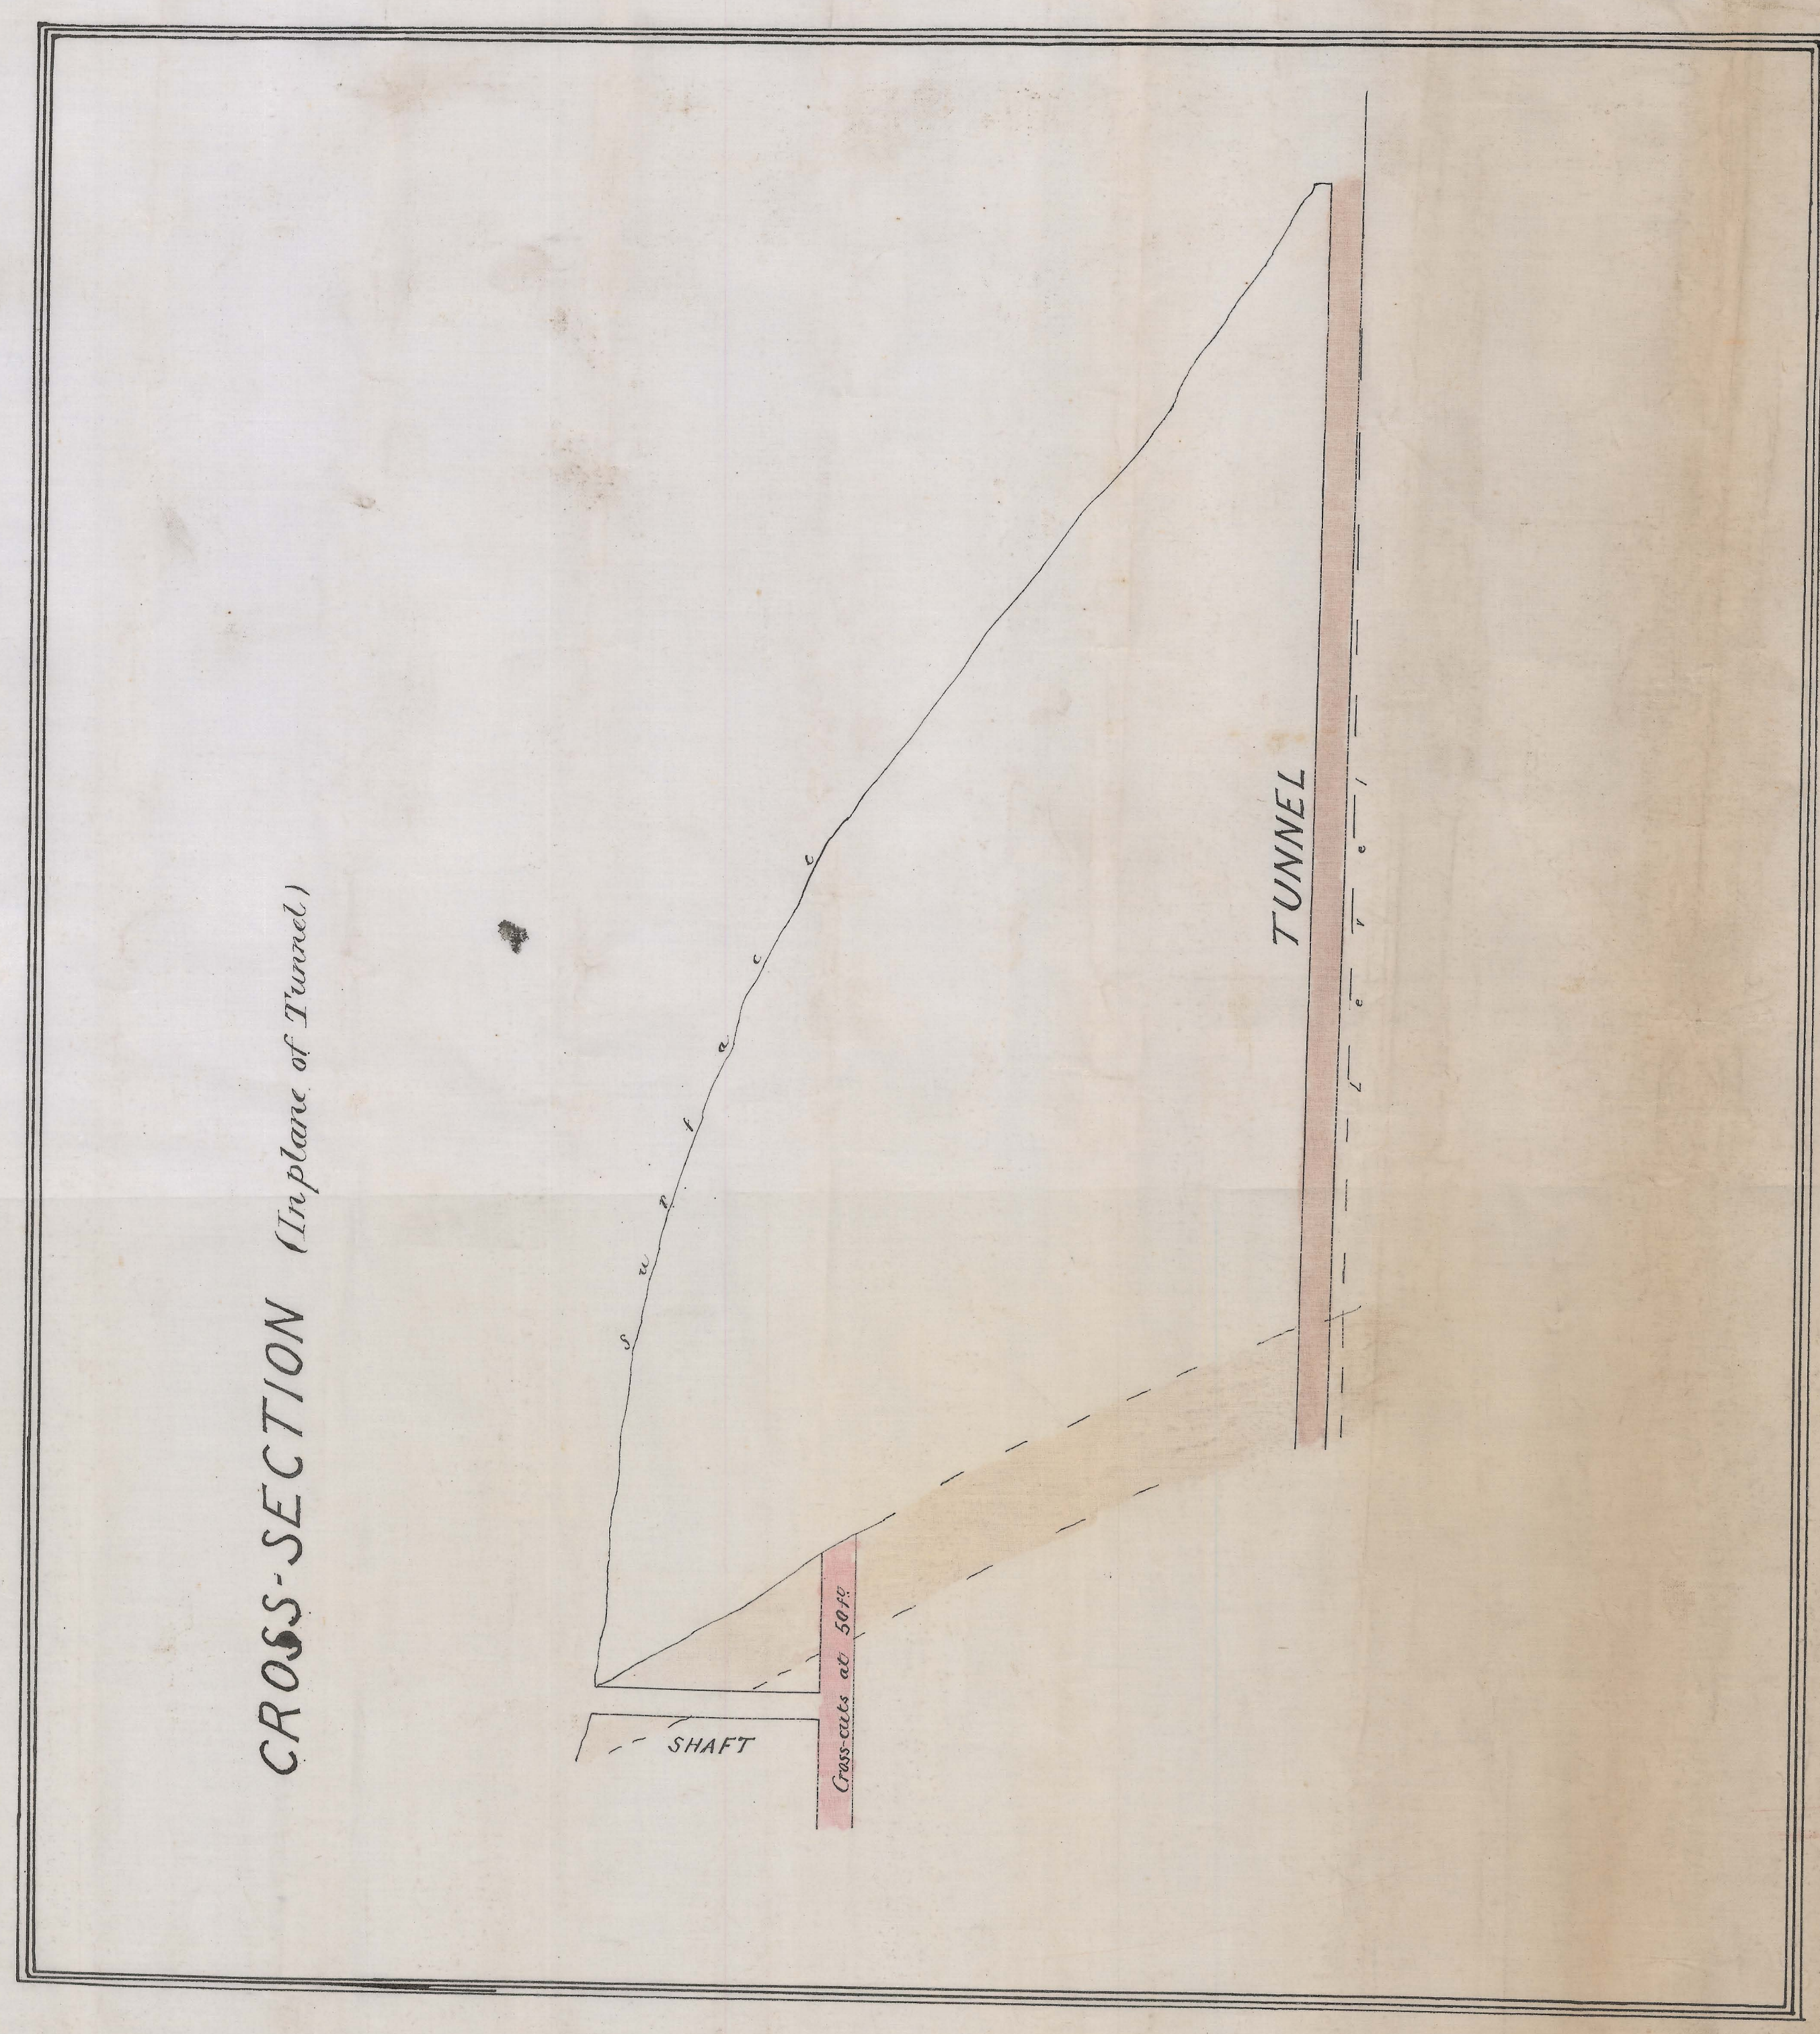

499' 2.70' Datum