


20th Feb. 1896


Plan of Patena Coal Company Mine
 Scale 2 Chains to 1 inch
 1896

Bearings taken with Miner's Dial

Land belonging to Henry Mason

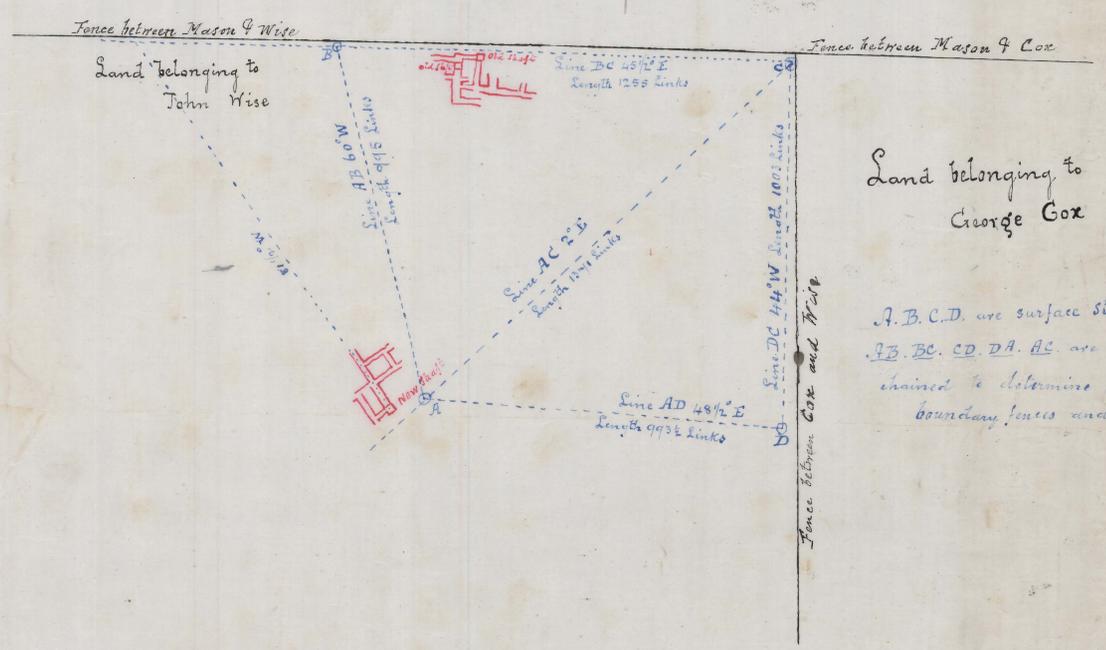

A, B, C, D, are surface Stations
 AB, BC, CD, DA, AC, are surface lines
 chained to determine position of
 boundary fences and shaft.

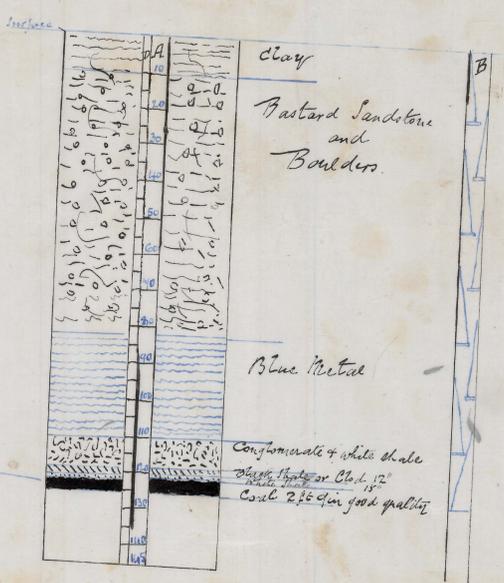

Plan and Section of Shaft 6ft x 6ft
 Scale 20ft to 1 inch
 B. Shows position of Ladders in shaft
 A. Shows width of Shaft for winding
 D. Shows position of Ladders
 Winding Shaft 6ft x 4ft
 Ladder Shaft 6ft x 2ft.

259-02

259-02

8 cm

Patena Coal