
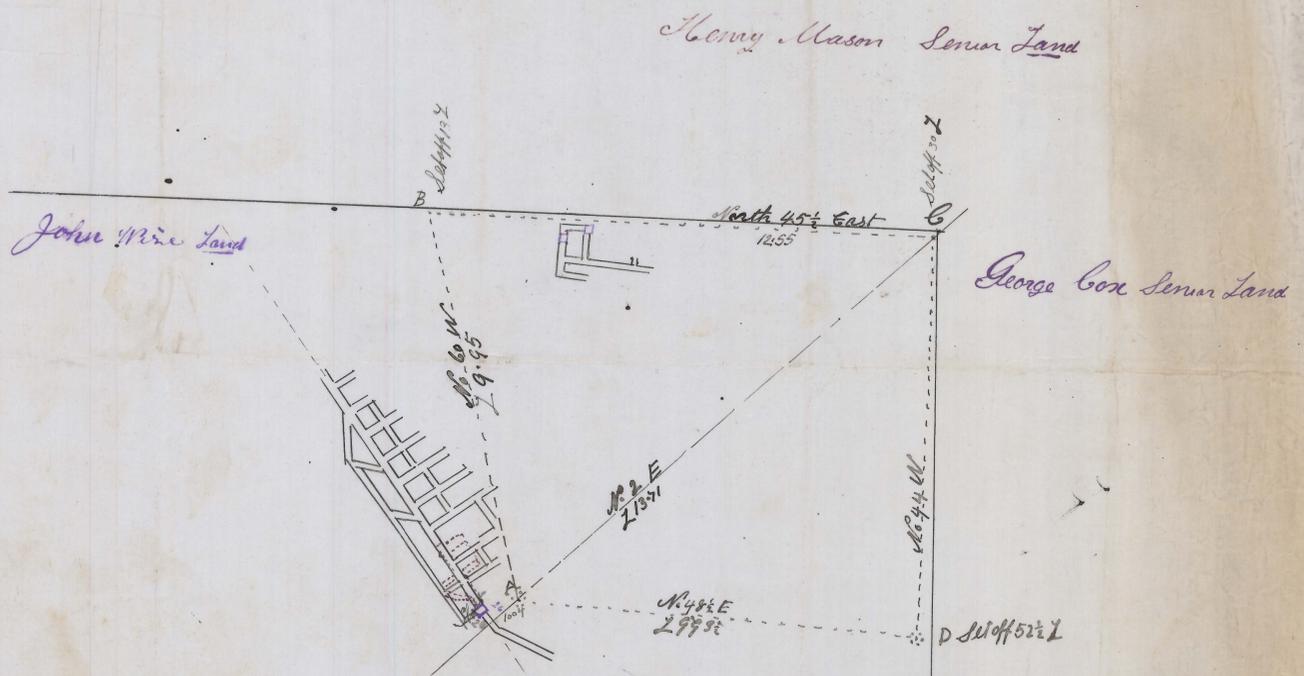
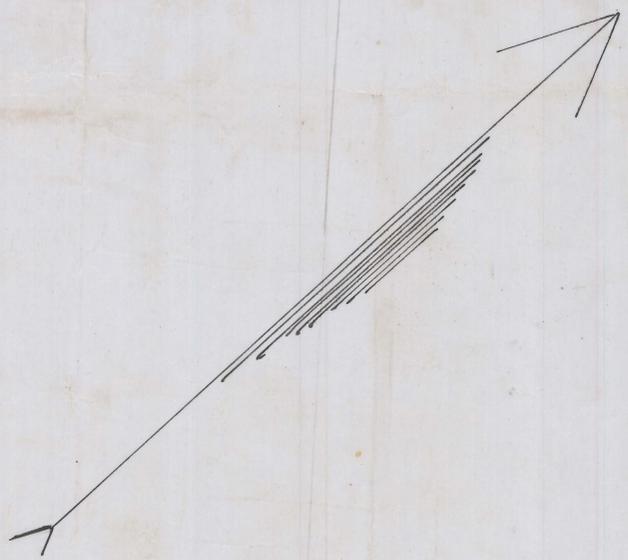


Plan of  
Tateona Coal Company  
 Mine Scale 7 Chains - 1. inch

259-03

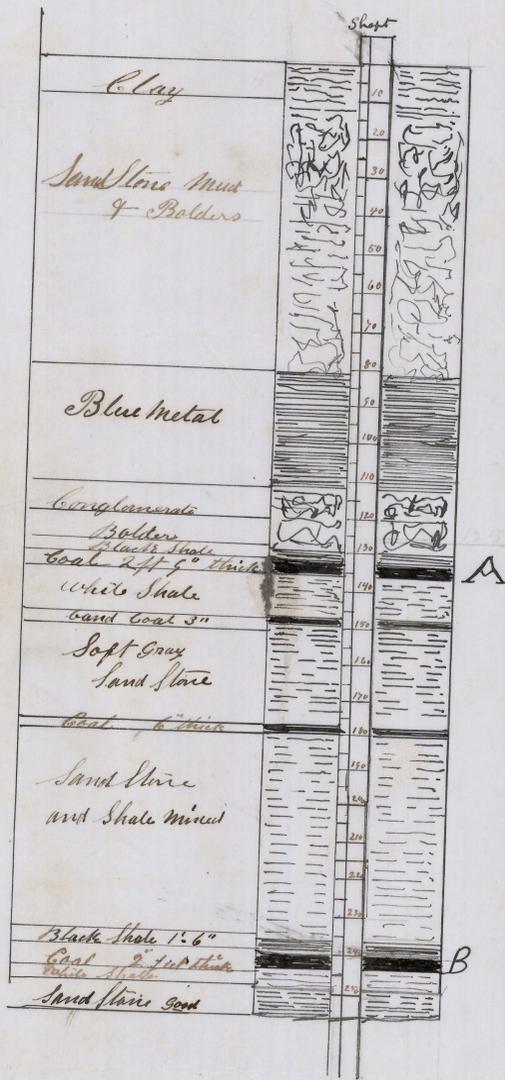

5 cm

259-08

13/11/96

*Thos G. Griffiths*  
 Mine Manager  
 December 24/96

Reference  
 Reference to plan showing  
 Position of shaft on Mr. John Wise's land  
 Scale Two Chains to an inch  
 Also Plan & Section of shaft  
 Scale Twenty (20) feet to an inch  
 B The bottom seam of coal has been  
 worked a distance 1.45 chains  
 from shaft as shown on plan  
 in dotted lines, marked Blue.  
 This plan is made up correct  
 to date of stoppage  
 J.G.S.  
 Dec 24/96