


PLAN
OF
YORK PLAINS COAL MINE

Scale: 40 feet to an inch

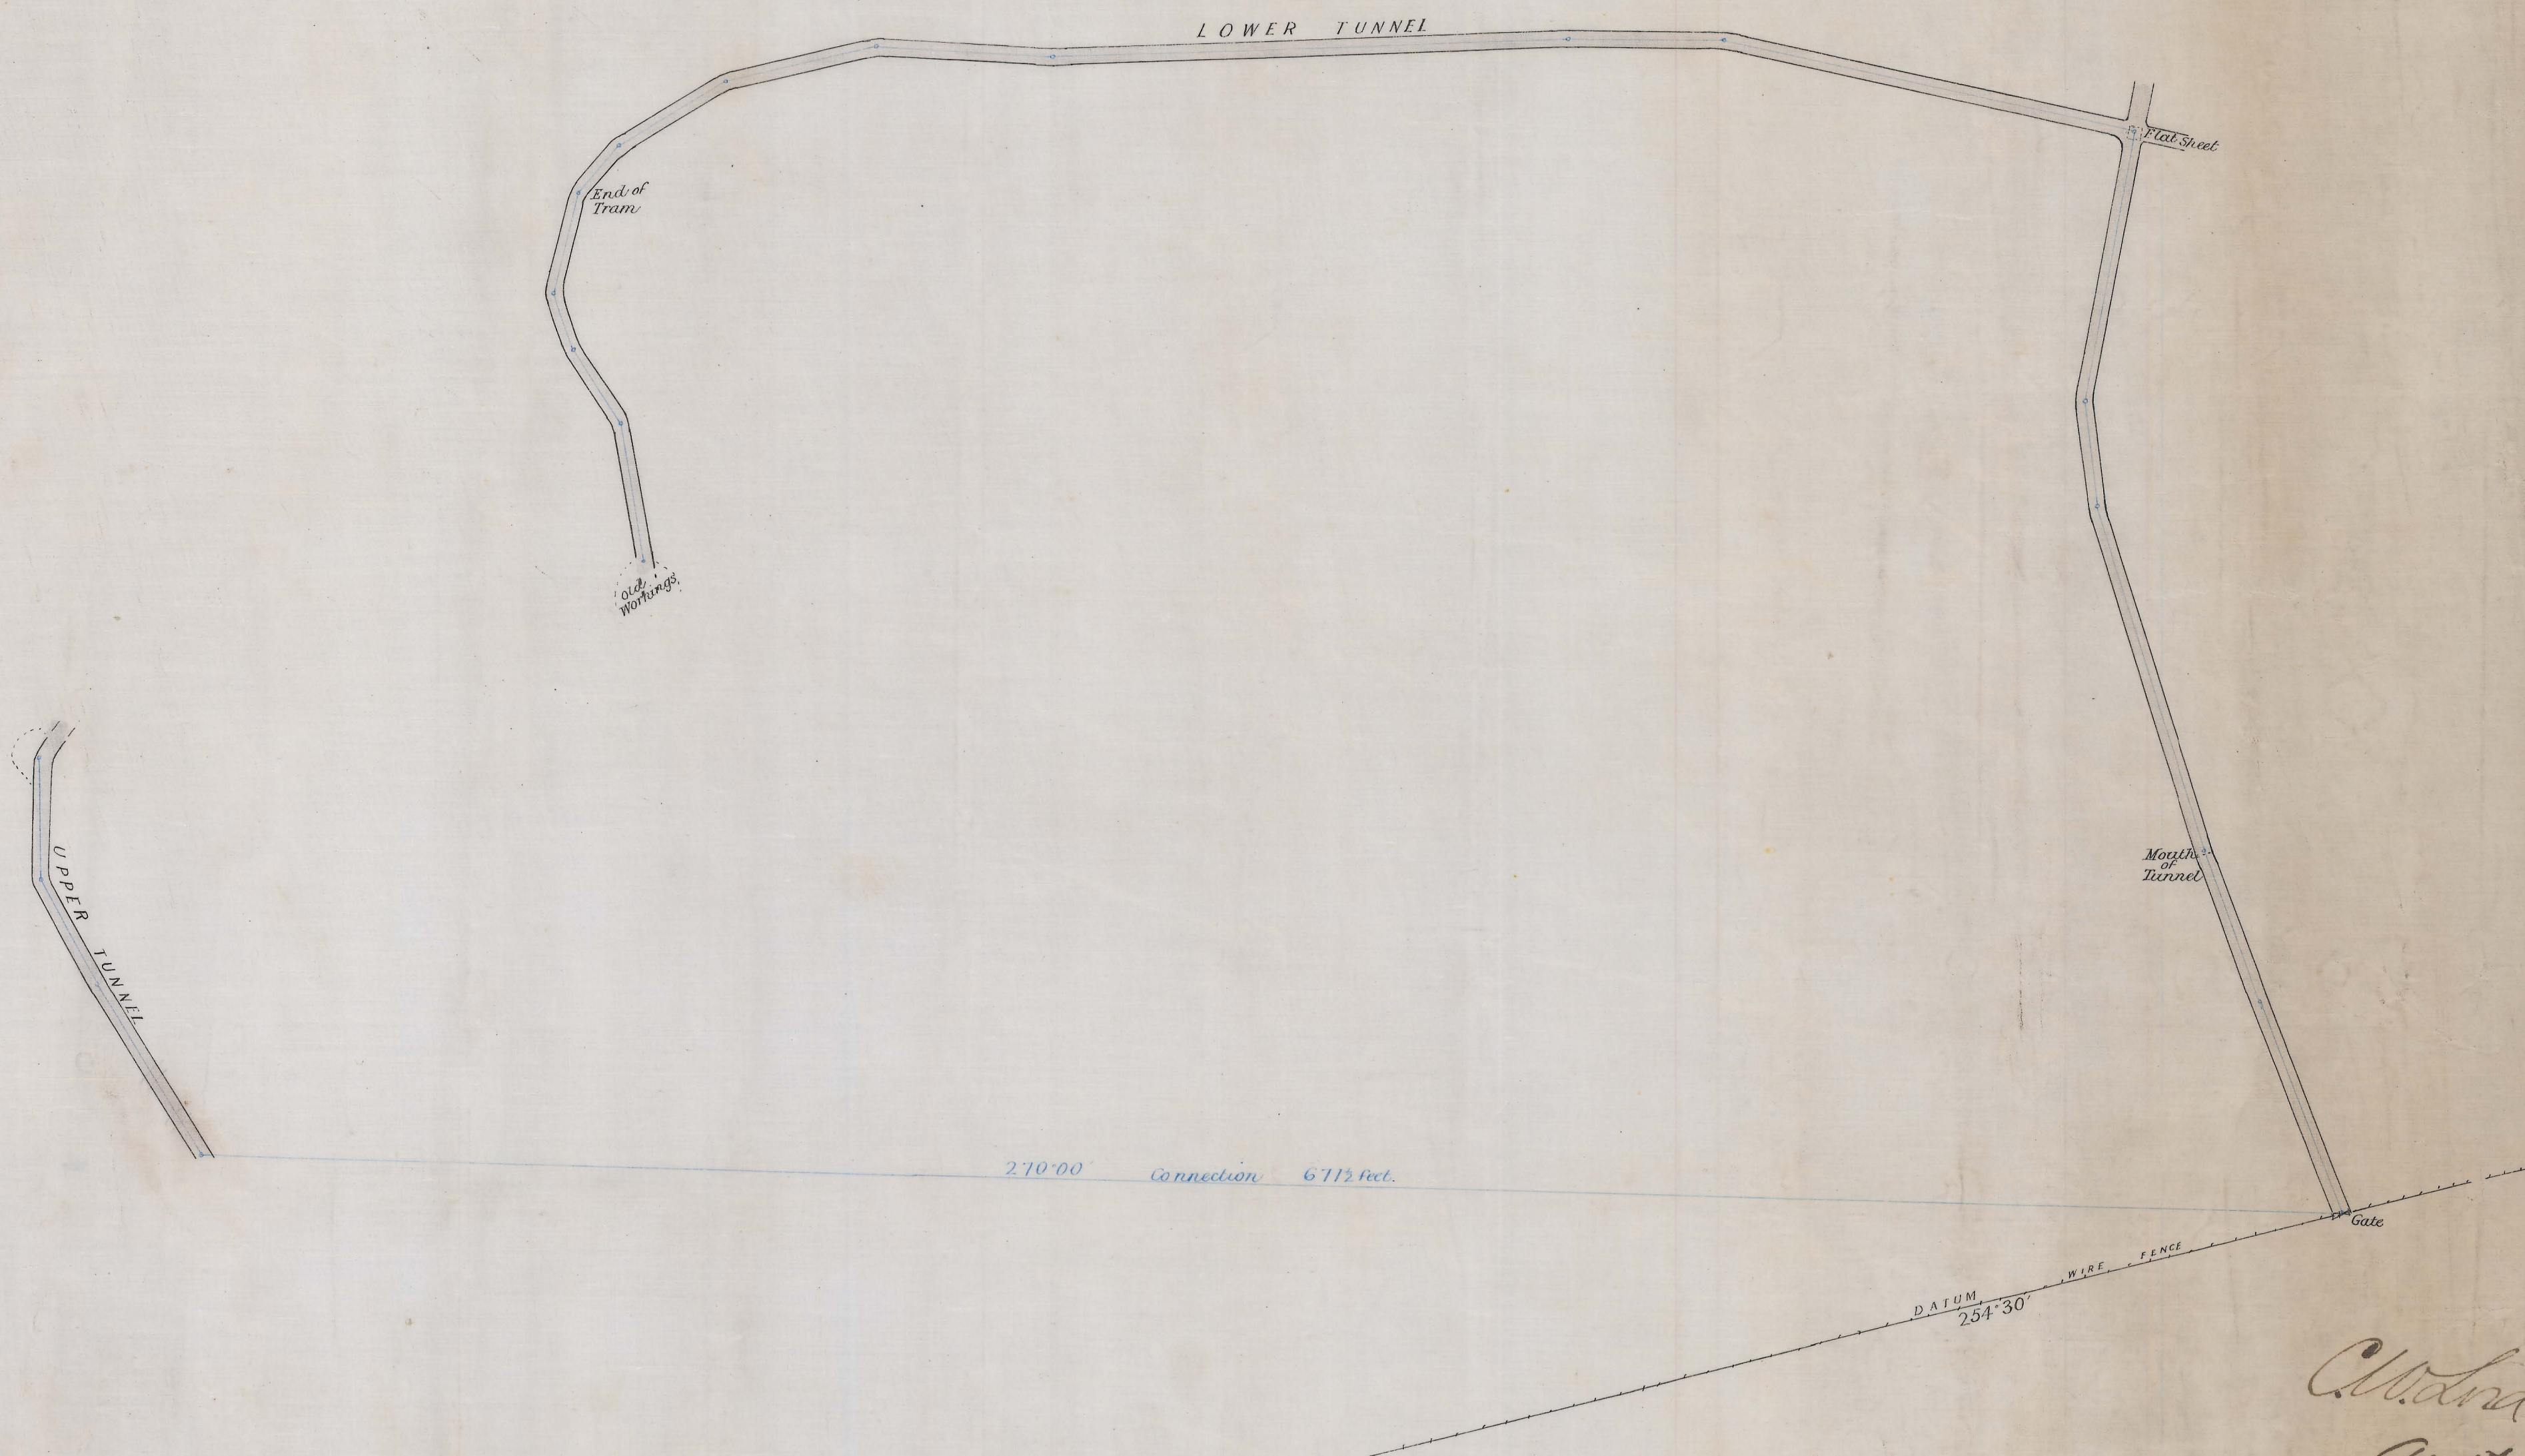

Alford
Authorized Surveyor
19th March 13

2801

260-01

5 cm

801
York Plains Coal Mine
1913