


260-02

260-02

5 cm

YORK PLAINS COLLIERY.

Scale 30 feet to an inch.

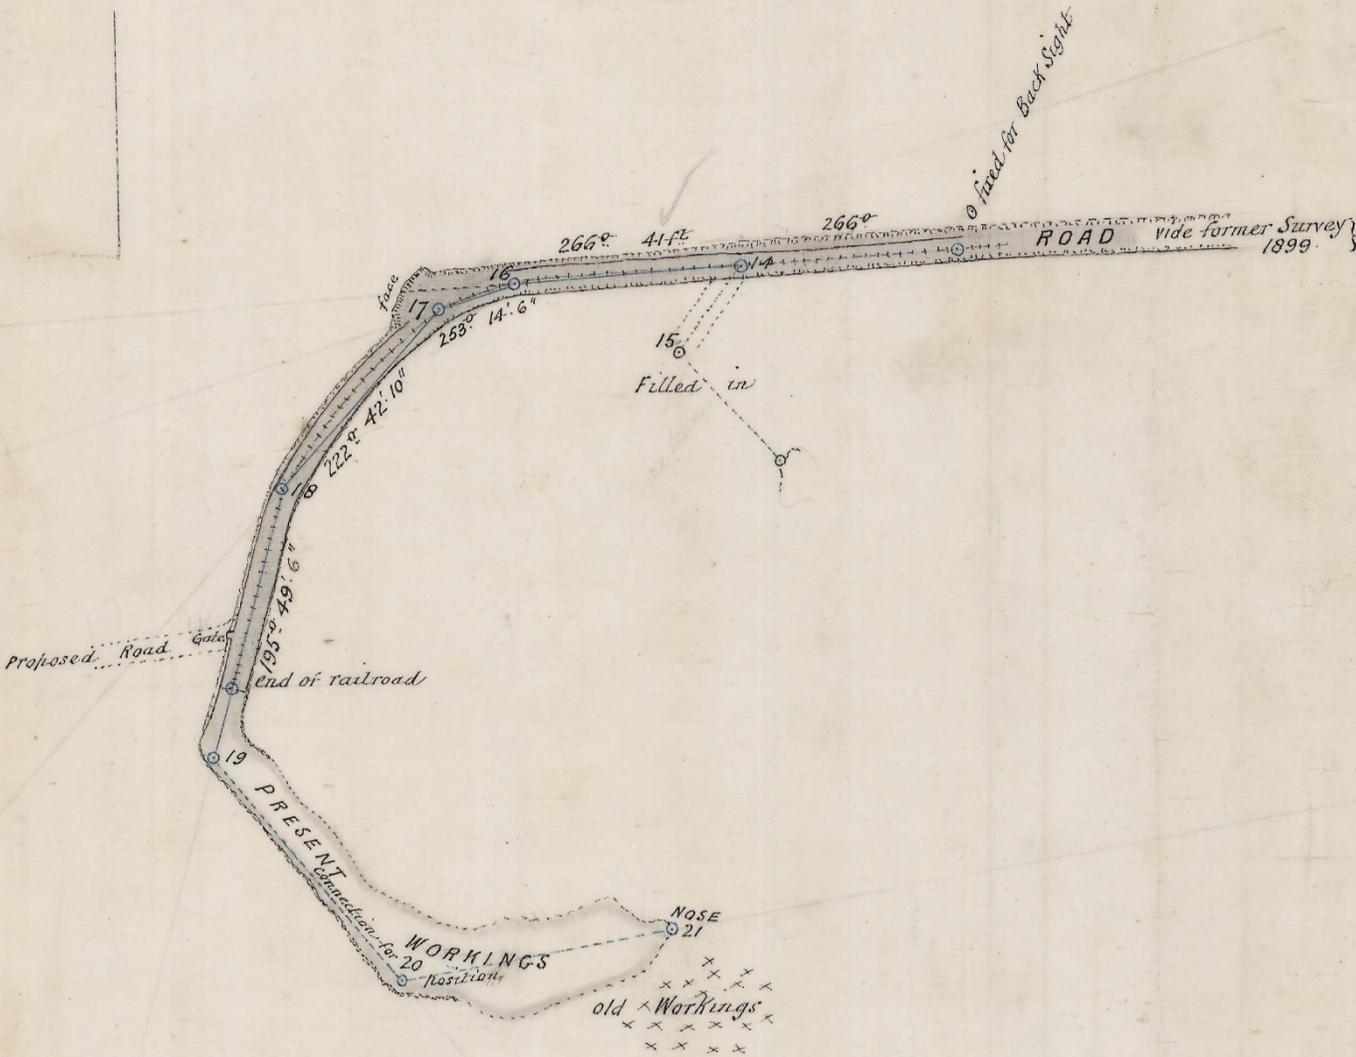

Survey Commenced & Completed 20th Oct. 1900.

Note: Roof being low in places I had to use a Prismatic Compass, observing B and F. Readings.

G. F. Lovell
Oct. 1900.



York
Plan
1000

107

33

33
107