



York Plains
103
11-28-11

YORK PLAINS COAL MINE
Scale 40ft to an inch

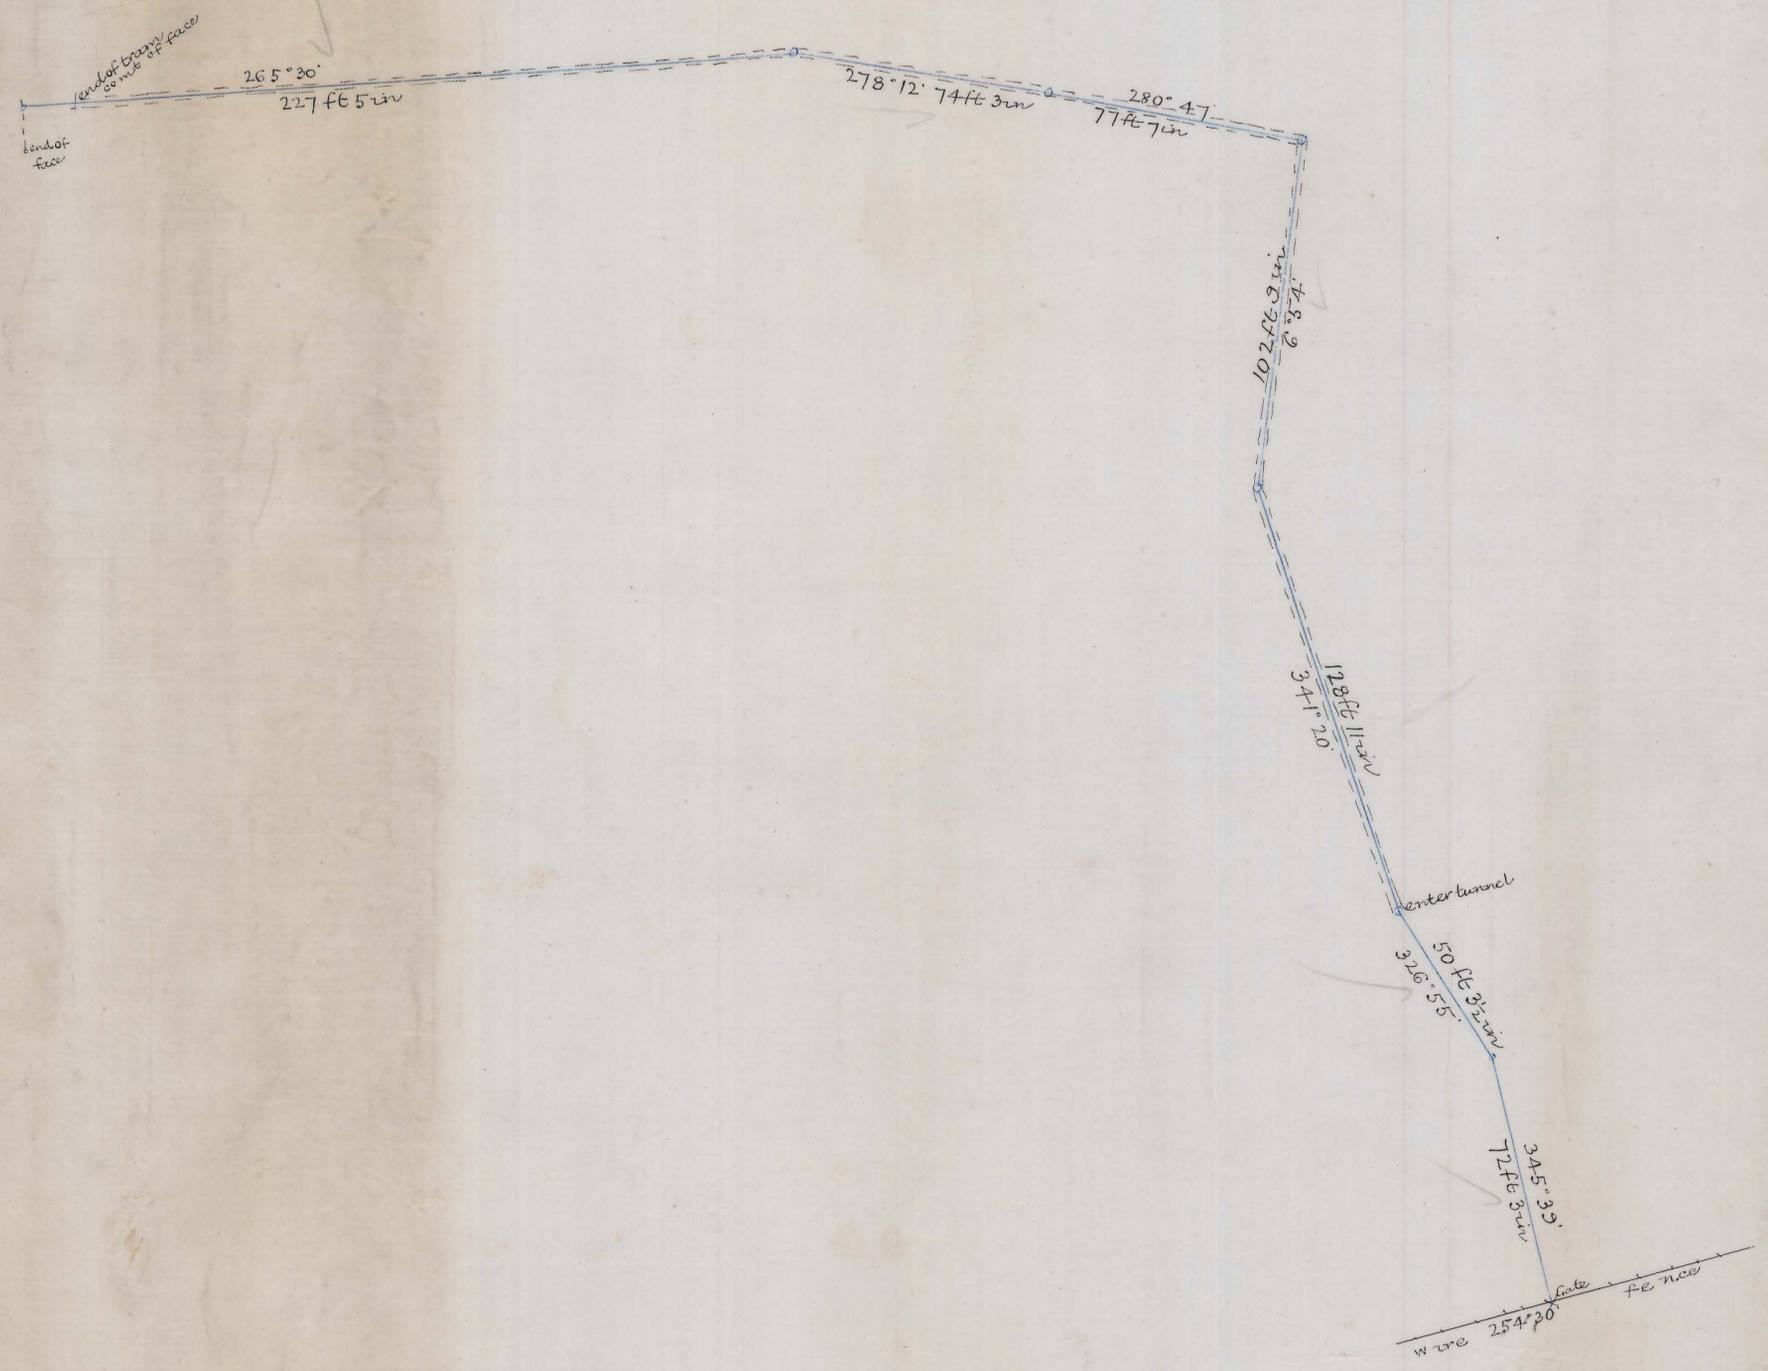

260-03

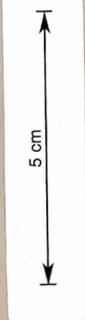

260-03

103
11-28-11

All ground S. of the drive
has been worked.
vide letter No. 6113

Clifford
Mining Surveyor
28/4/11