


COUNTY OF SOMERSET  
VICINITY OF YORK PLAINS

Scale 40 feet to an inch

TRACING OF PLAN OF

SURVEY OF UNDERGROUND WORKINGS OF COAL MINE AT YORK PLAINS JAMES C. GREGG OWNER

Worked out	30.4	3.8
	84° 3'	3.0
	032.5'	3.0
	124° 54'	3.0
End of tram		3.0
	109.4'	2.0
L elev 11'	171°	2.0
	83.6'	2.0
L elev 6'	234° 18'	2.0
	45.8'	3.6
L elev 1'	257° 26'	3.6
	073'	3.6
L elev 1'	273° 56'	3.6
	257.3'	4.0
L elev 2'	267° 38'	3.0
	64.3'	3.0
L elev 3'	269° 56'	3.4
	204.2'	3.4
	281° 56'	4.5
	141'	4.5
	9° 31'	4.4
	204.4'	3.5
	344°	3.1
Mouth of Adit		3.1

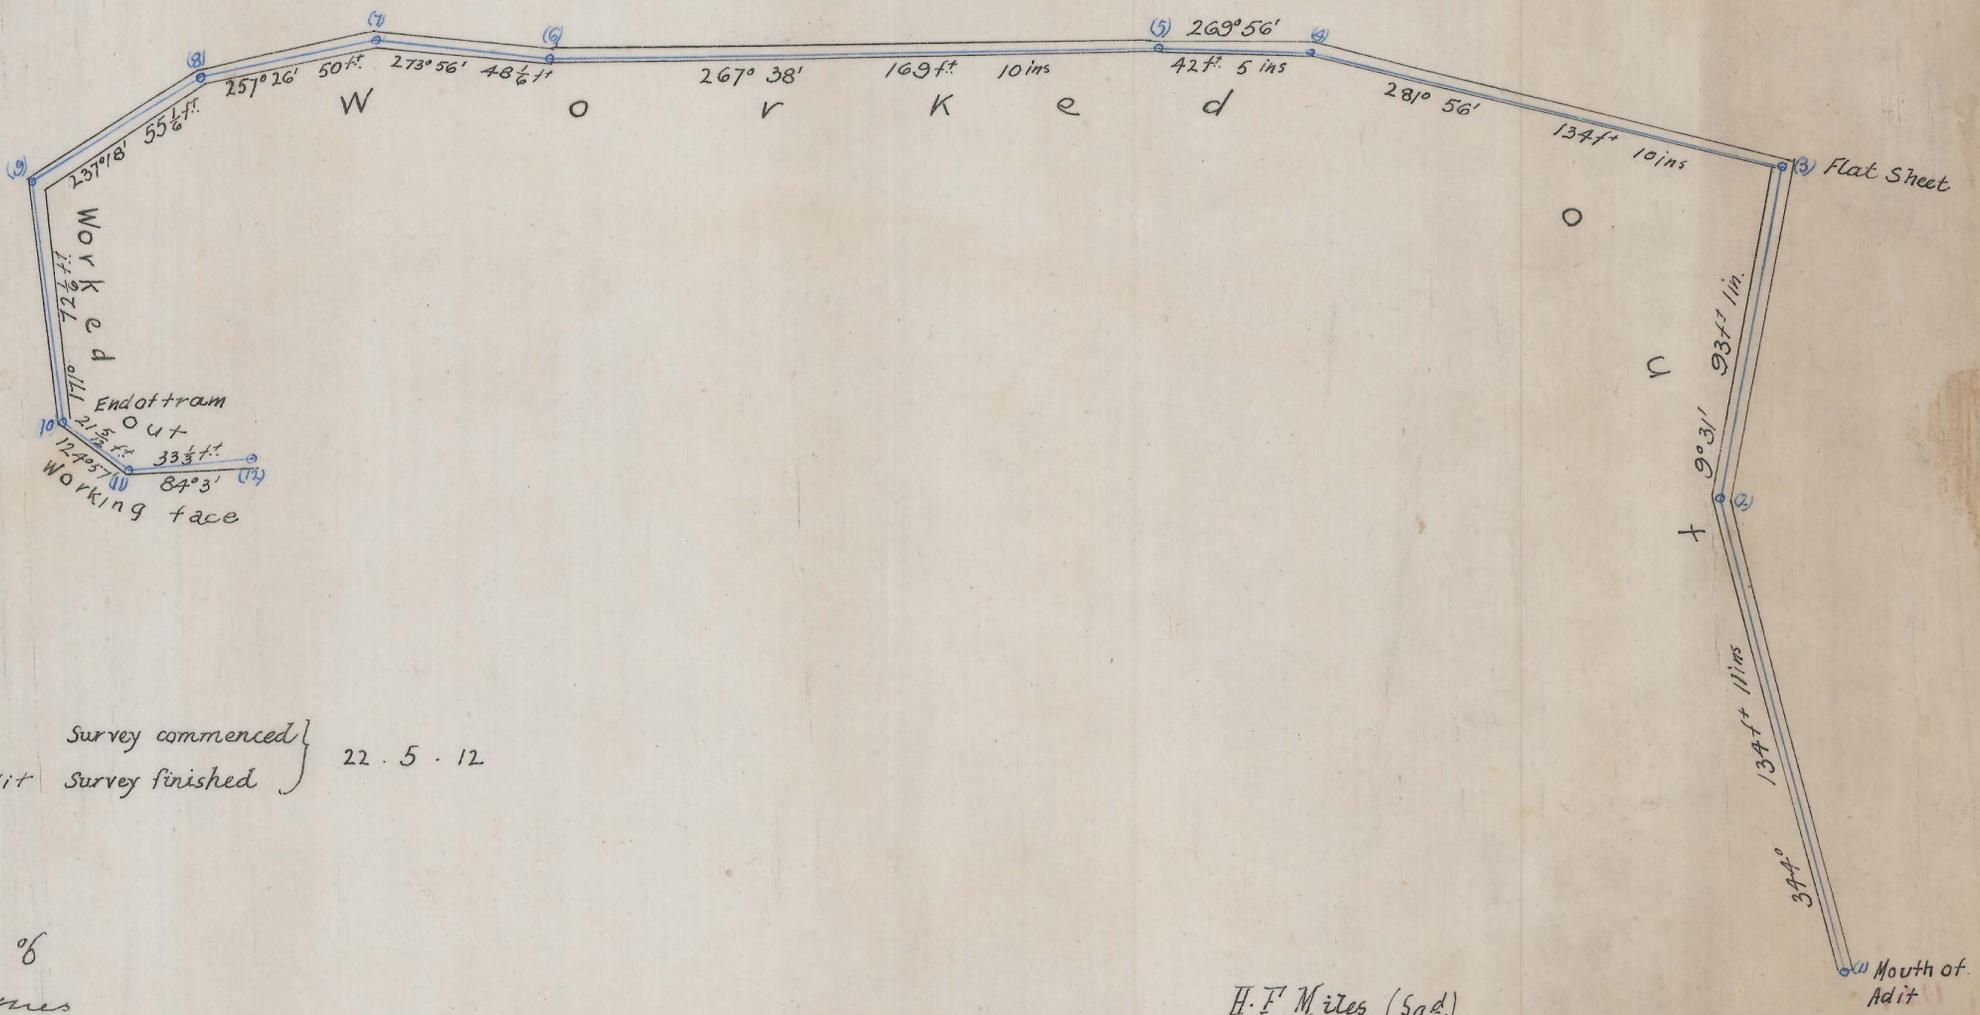

Survey commenced }  
Survey finished } 22.5.12

260-06

5 cm

260-06

incline adit  
C Gregg commencing at the mouth of  
at York Plains the property of James  
Survey of underground workings of Coal mine  
Copy of the field notes of

H. F. Miles (Sgd.)  
Surveyor

York Plains  
103

103