



5 cm

260-08

260-08

PLAN OF YORK PLAINS COAL MINE

Scale 2 chains to an Inch

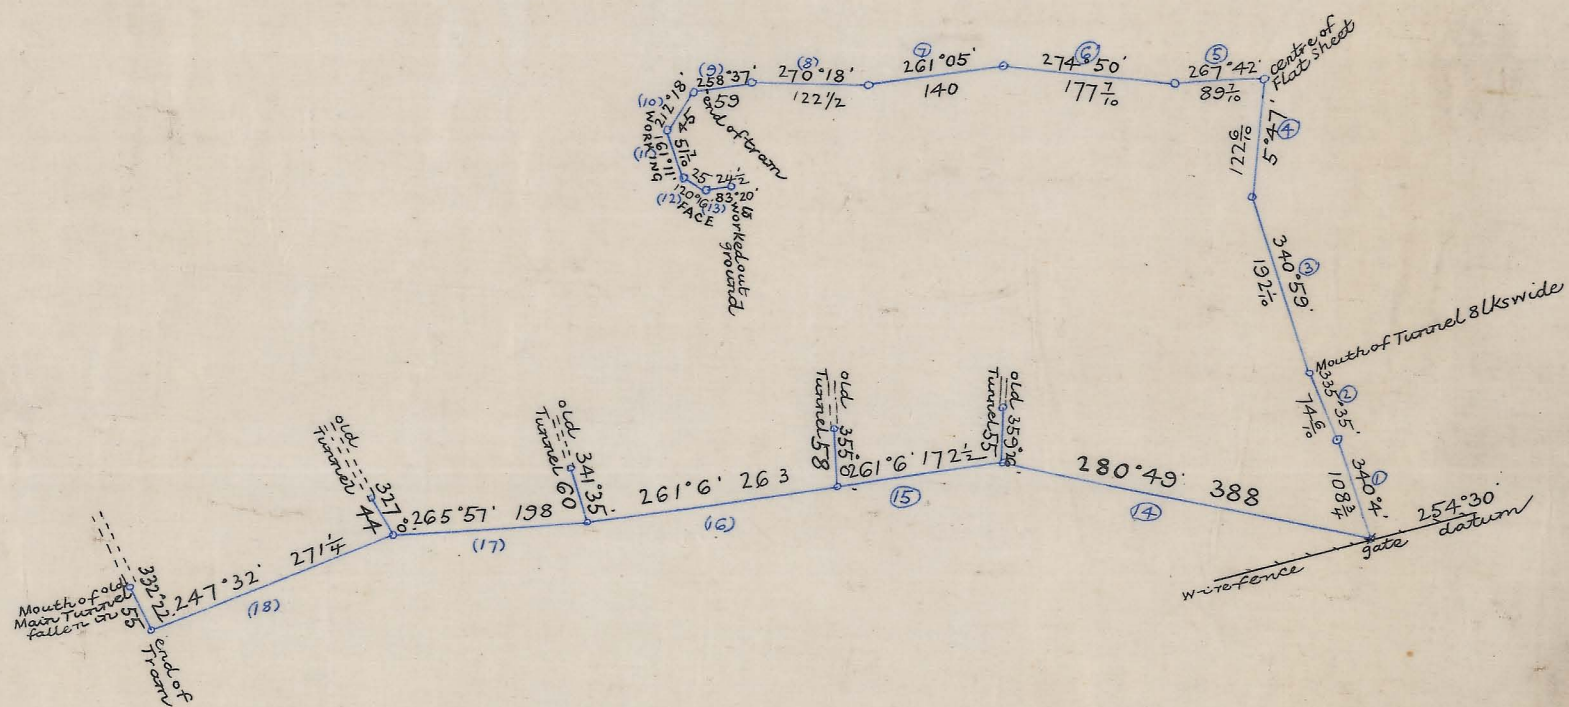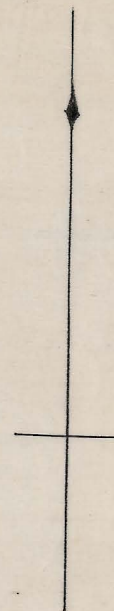

Chad
Authorised Surveyor
3rd April 07



103