


# MR C. J. C. LORDS COLLIERY

## YORK PLAINS



Scale. 30 feet to an inch

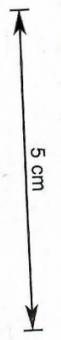

5 p 81 Road

210-09

210-09

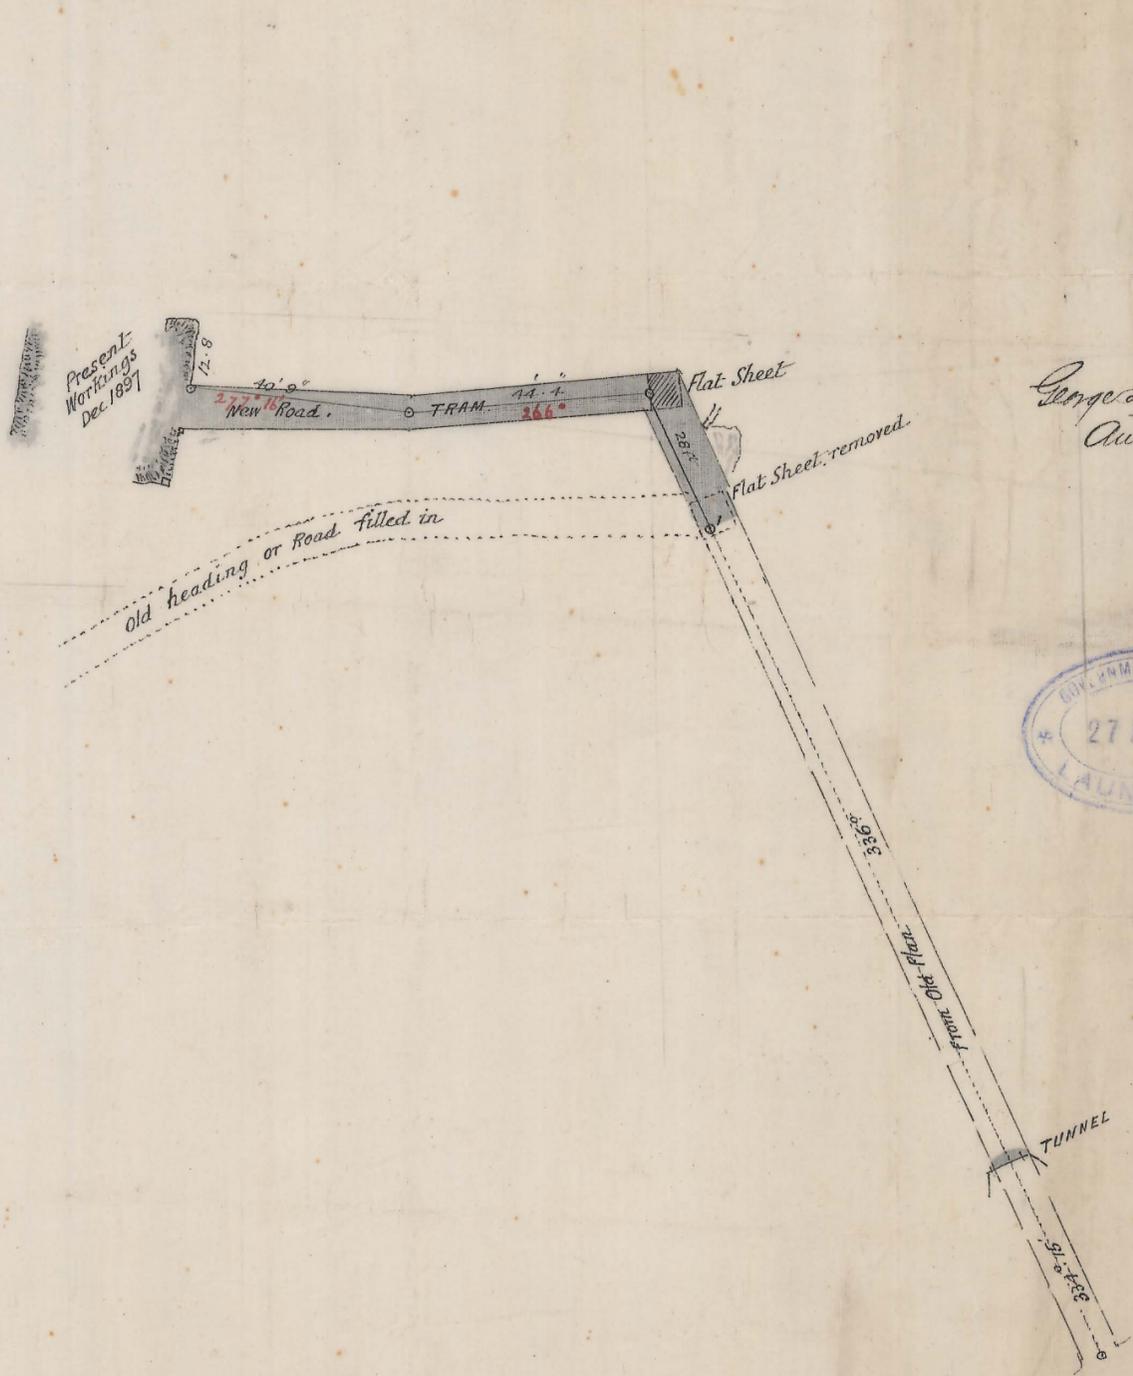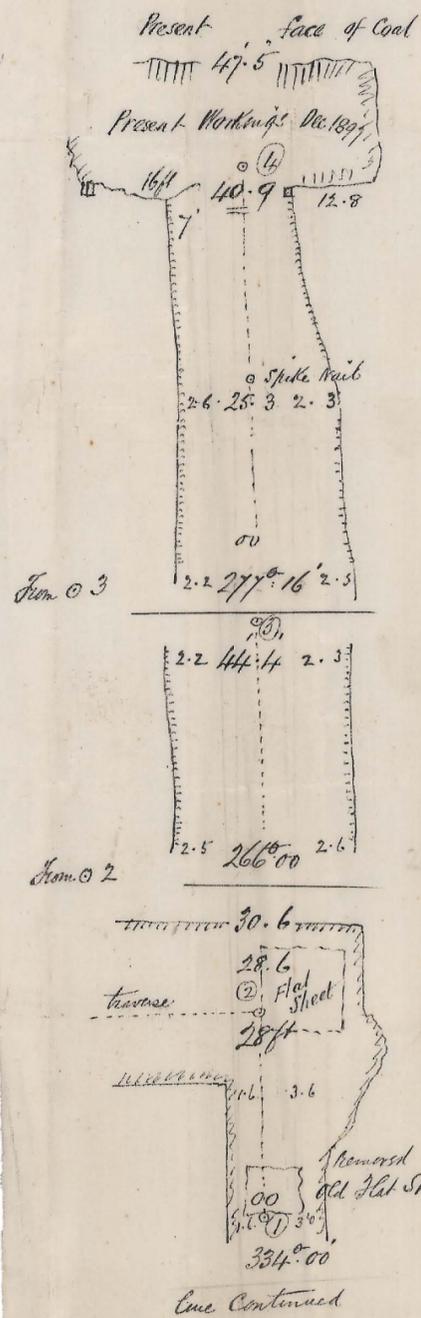

George J. Lord  
Authorized Surveyor  
Dec 1897.

