



PLAN AND SECTION OF
 MR C. J. C. LORDS COLLIERY
 YORK PLAINS.


ON PRIVATE PROPERTY.
 Scale. 30 Feet to an inch.

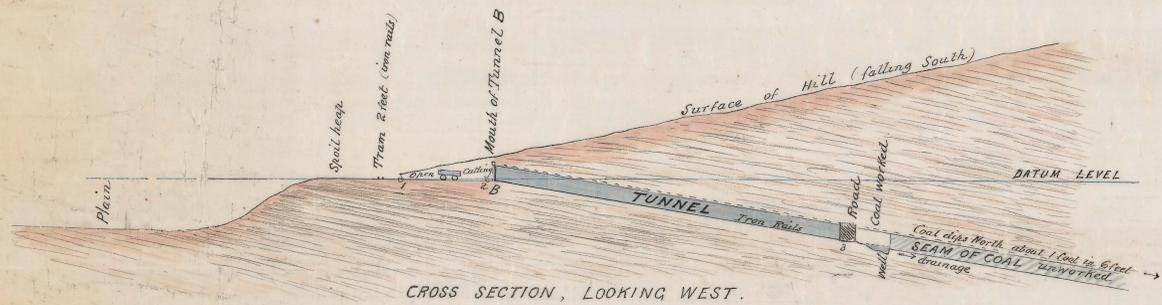

CROSS SECTION, LOOKING WEST.

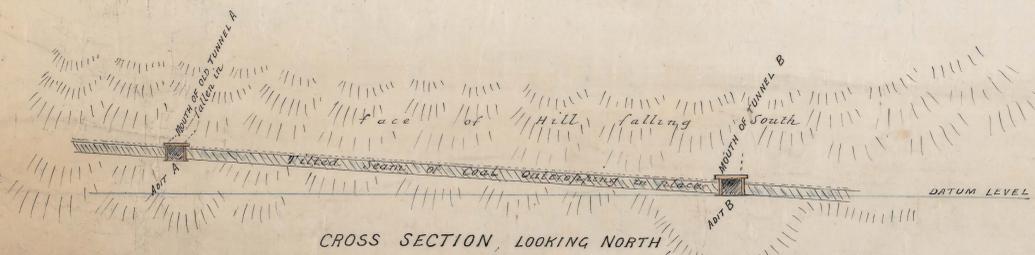

CROSS SECTION, LOOKING NORTH

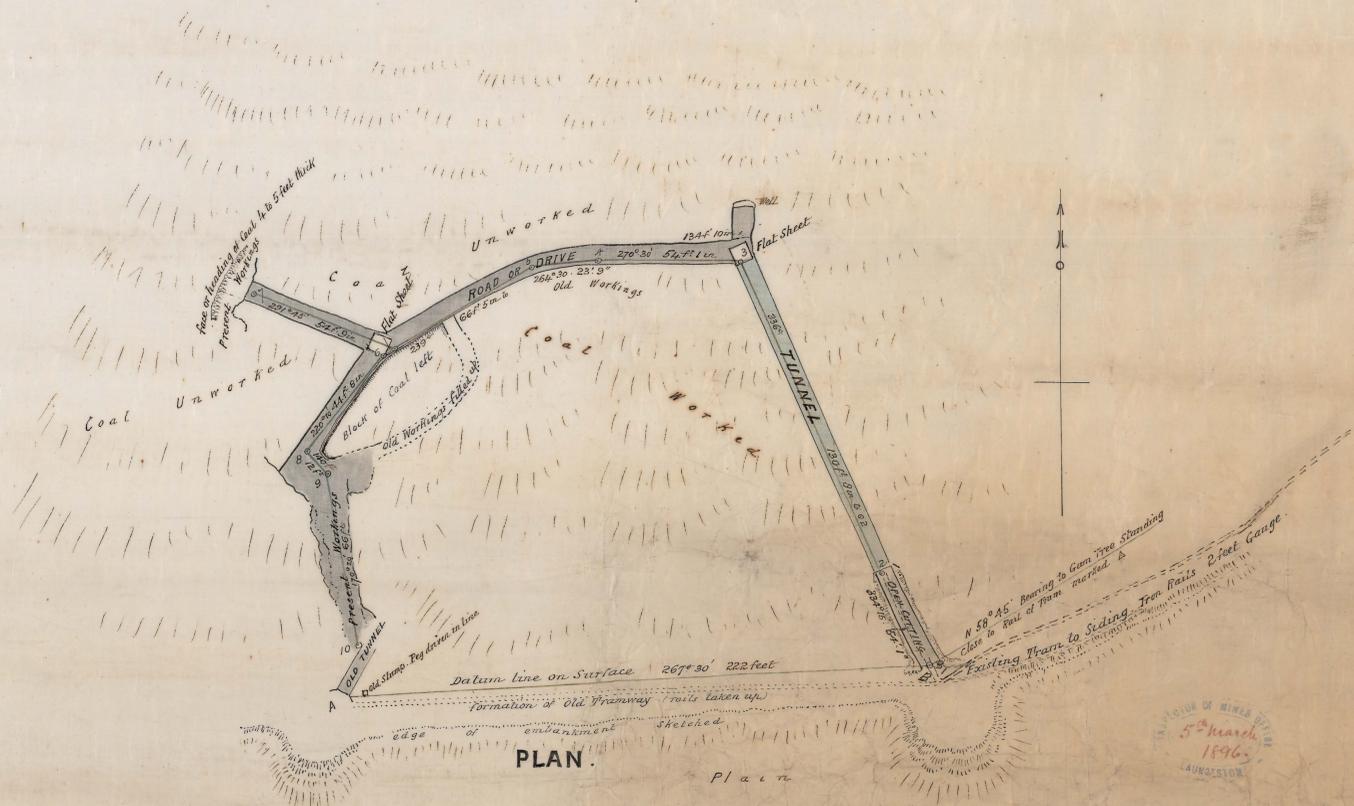

PLAN.

5th March 1896
 LAUNCESTON

George J. Lamb
 Authorised Surveyor
 February 1896
 York Plains

1000 yards
 1891-1897

5m

260-12

260-12