

5 cm




261-01

# MANGANA TASMANIA GOLD REEFS COMPANY LTD

Scale: 25 feet to an inch

VERTICAL SECTION OF MAIN SHAFT (LOOKING NORTH WEST) Showing Crosscuts to Reef

VERTICAL SECTION OF MAIN SHAFT (LOOKING NORTH EAST) Showing Drives along Reef

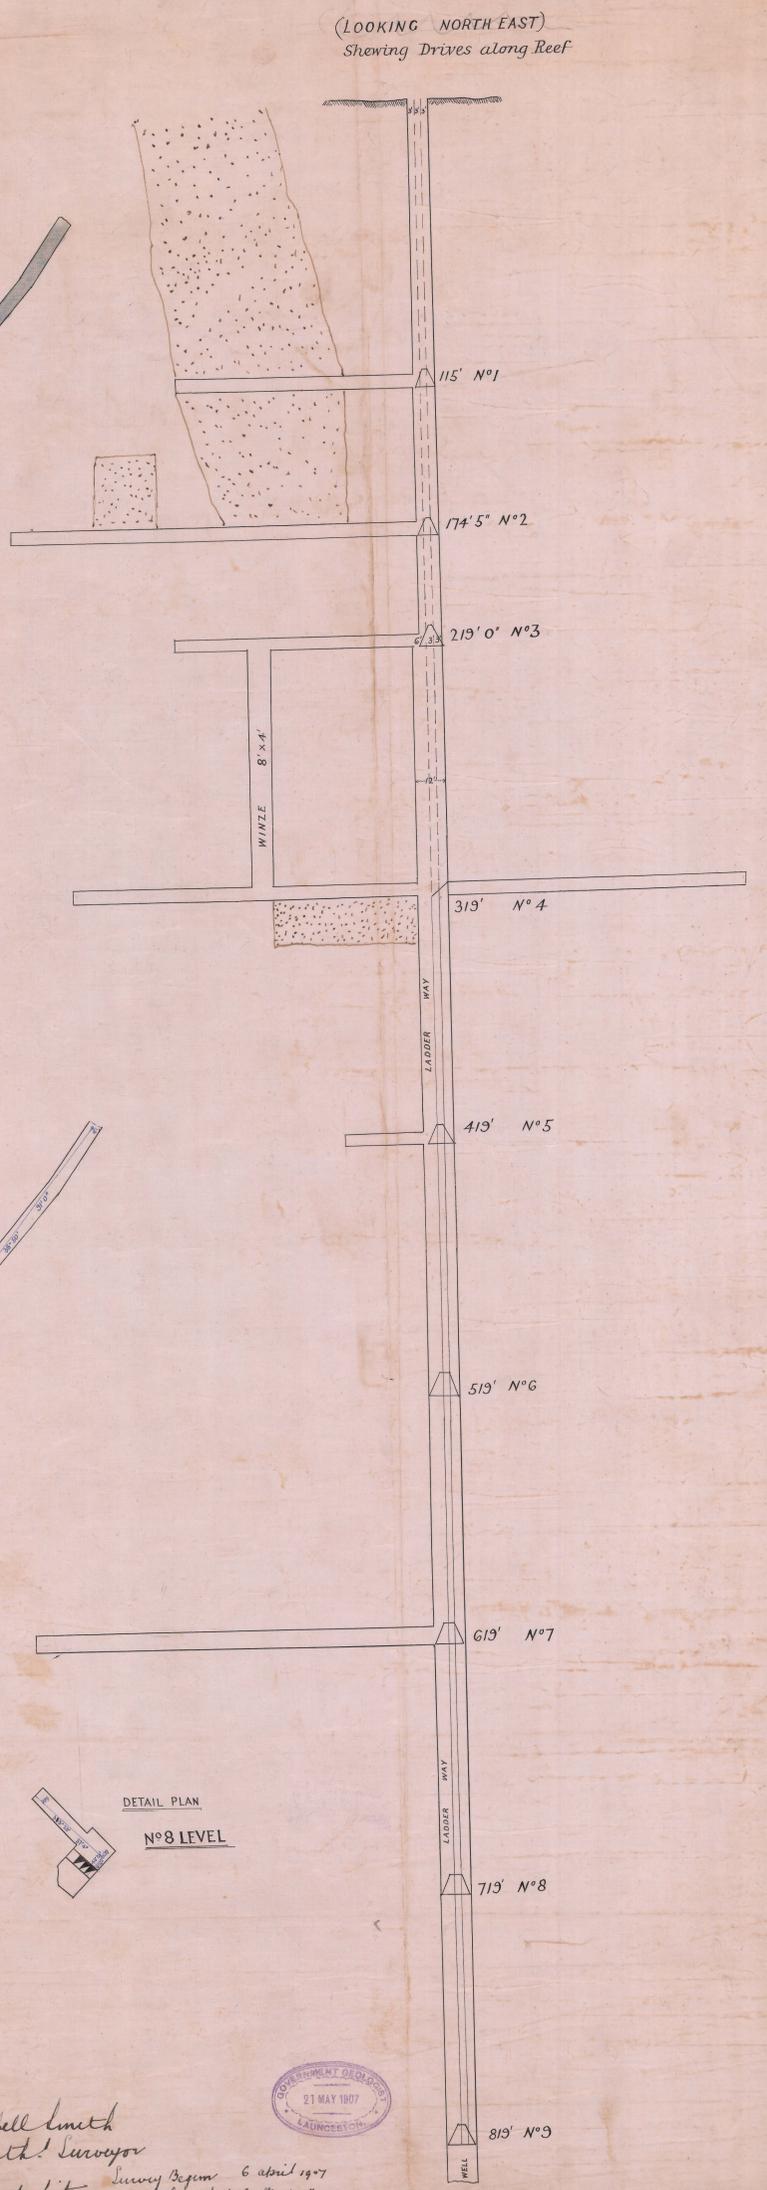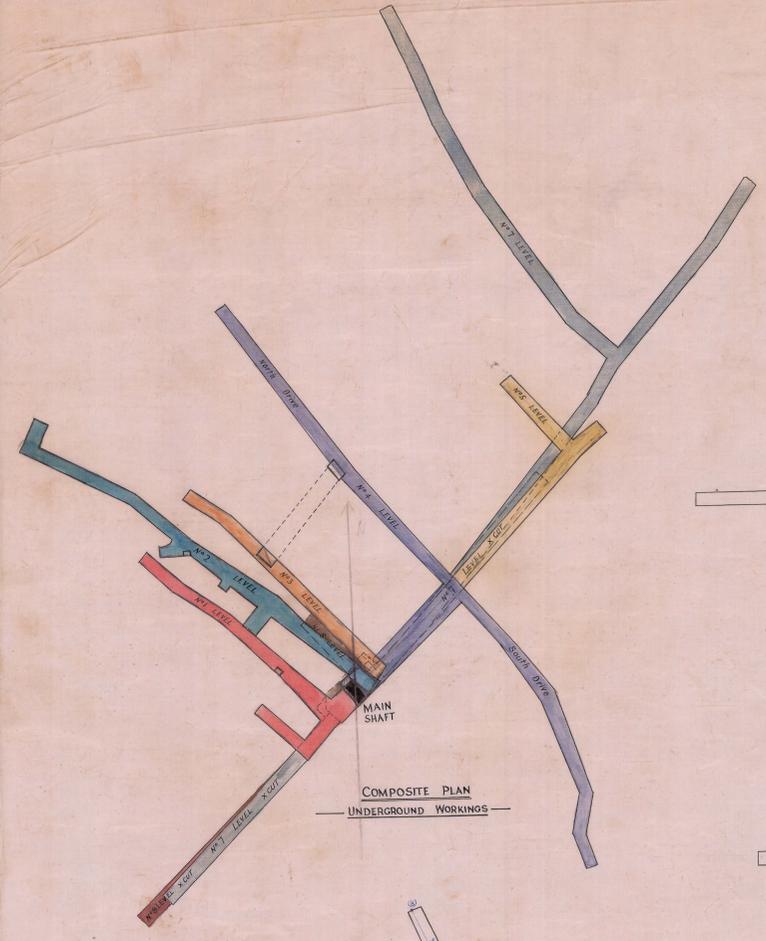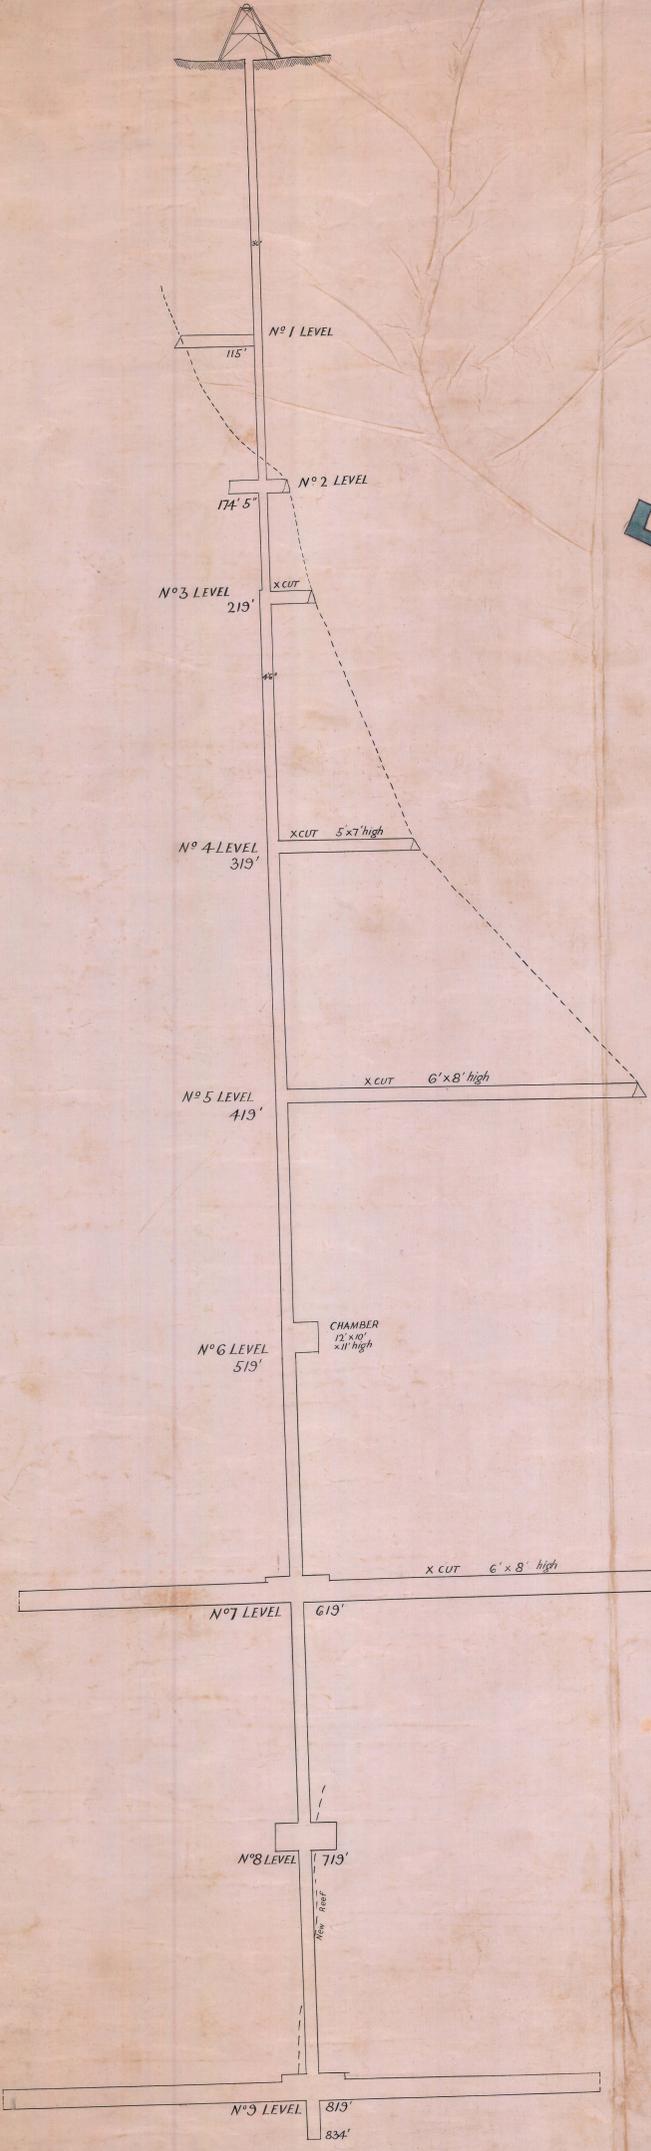

N<sup>o</sup> 7 LEVEL DETAIL PLAN

DETAIL PLAN N<sup>o</sup> 8 LEVEL

DETAIL PLAN N<sup>o</sup> 9 LEVEL



Lebaupbell Smith  
Auth. Surveyor

Surveyed with 4" transit theodolite  
Survey Begun 6 April 1907  
Finished 6 May "