


262-01

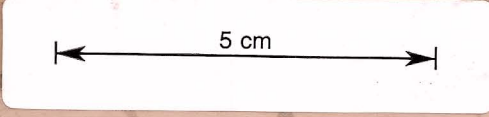

262-01

Beaconsfield Goldfield


Scale 25 feet to an inch

644
939

10 30:

J. Knight & L. E. Morgan

G. L.

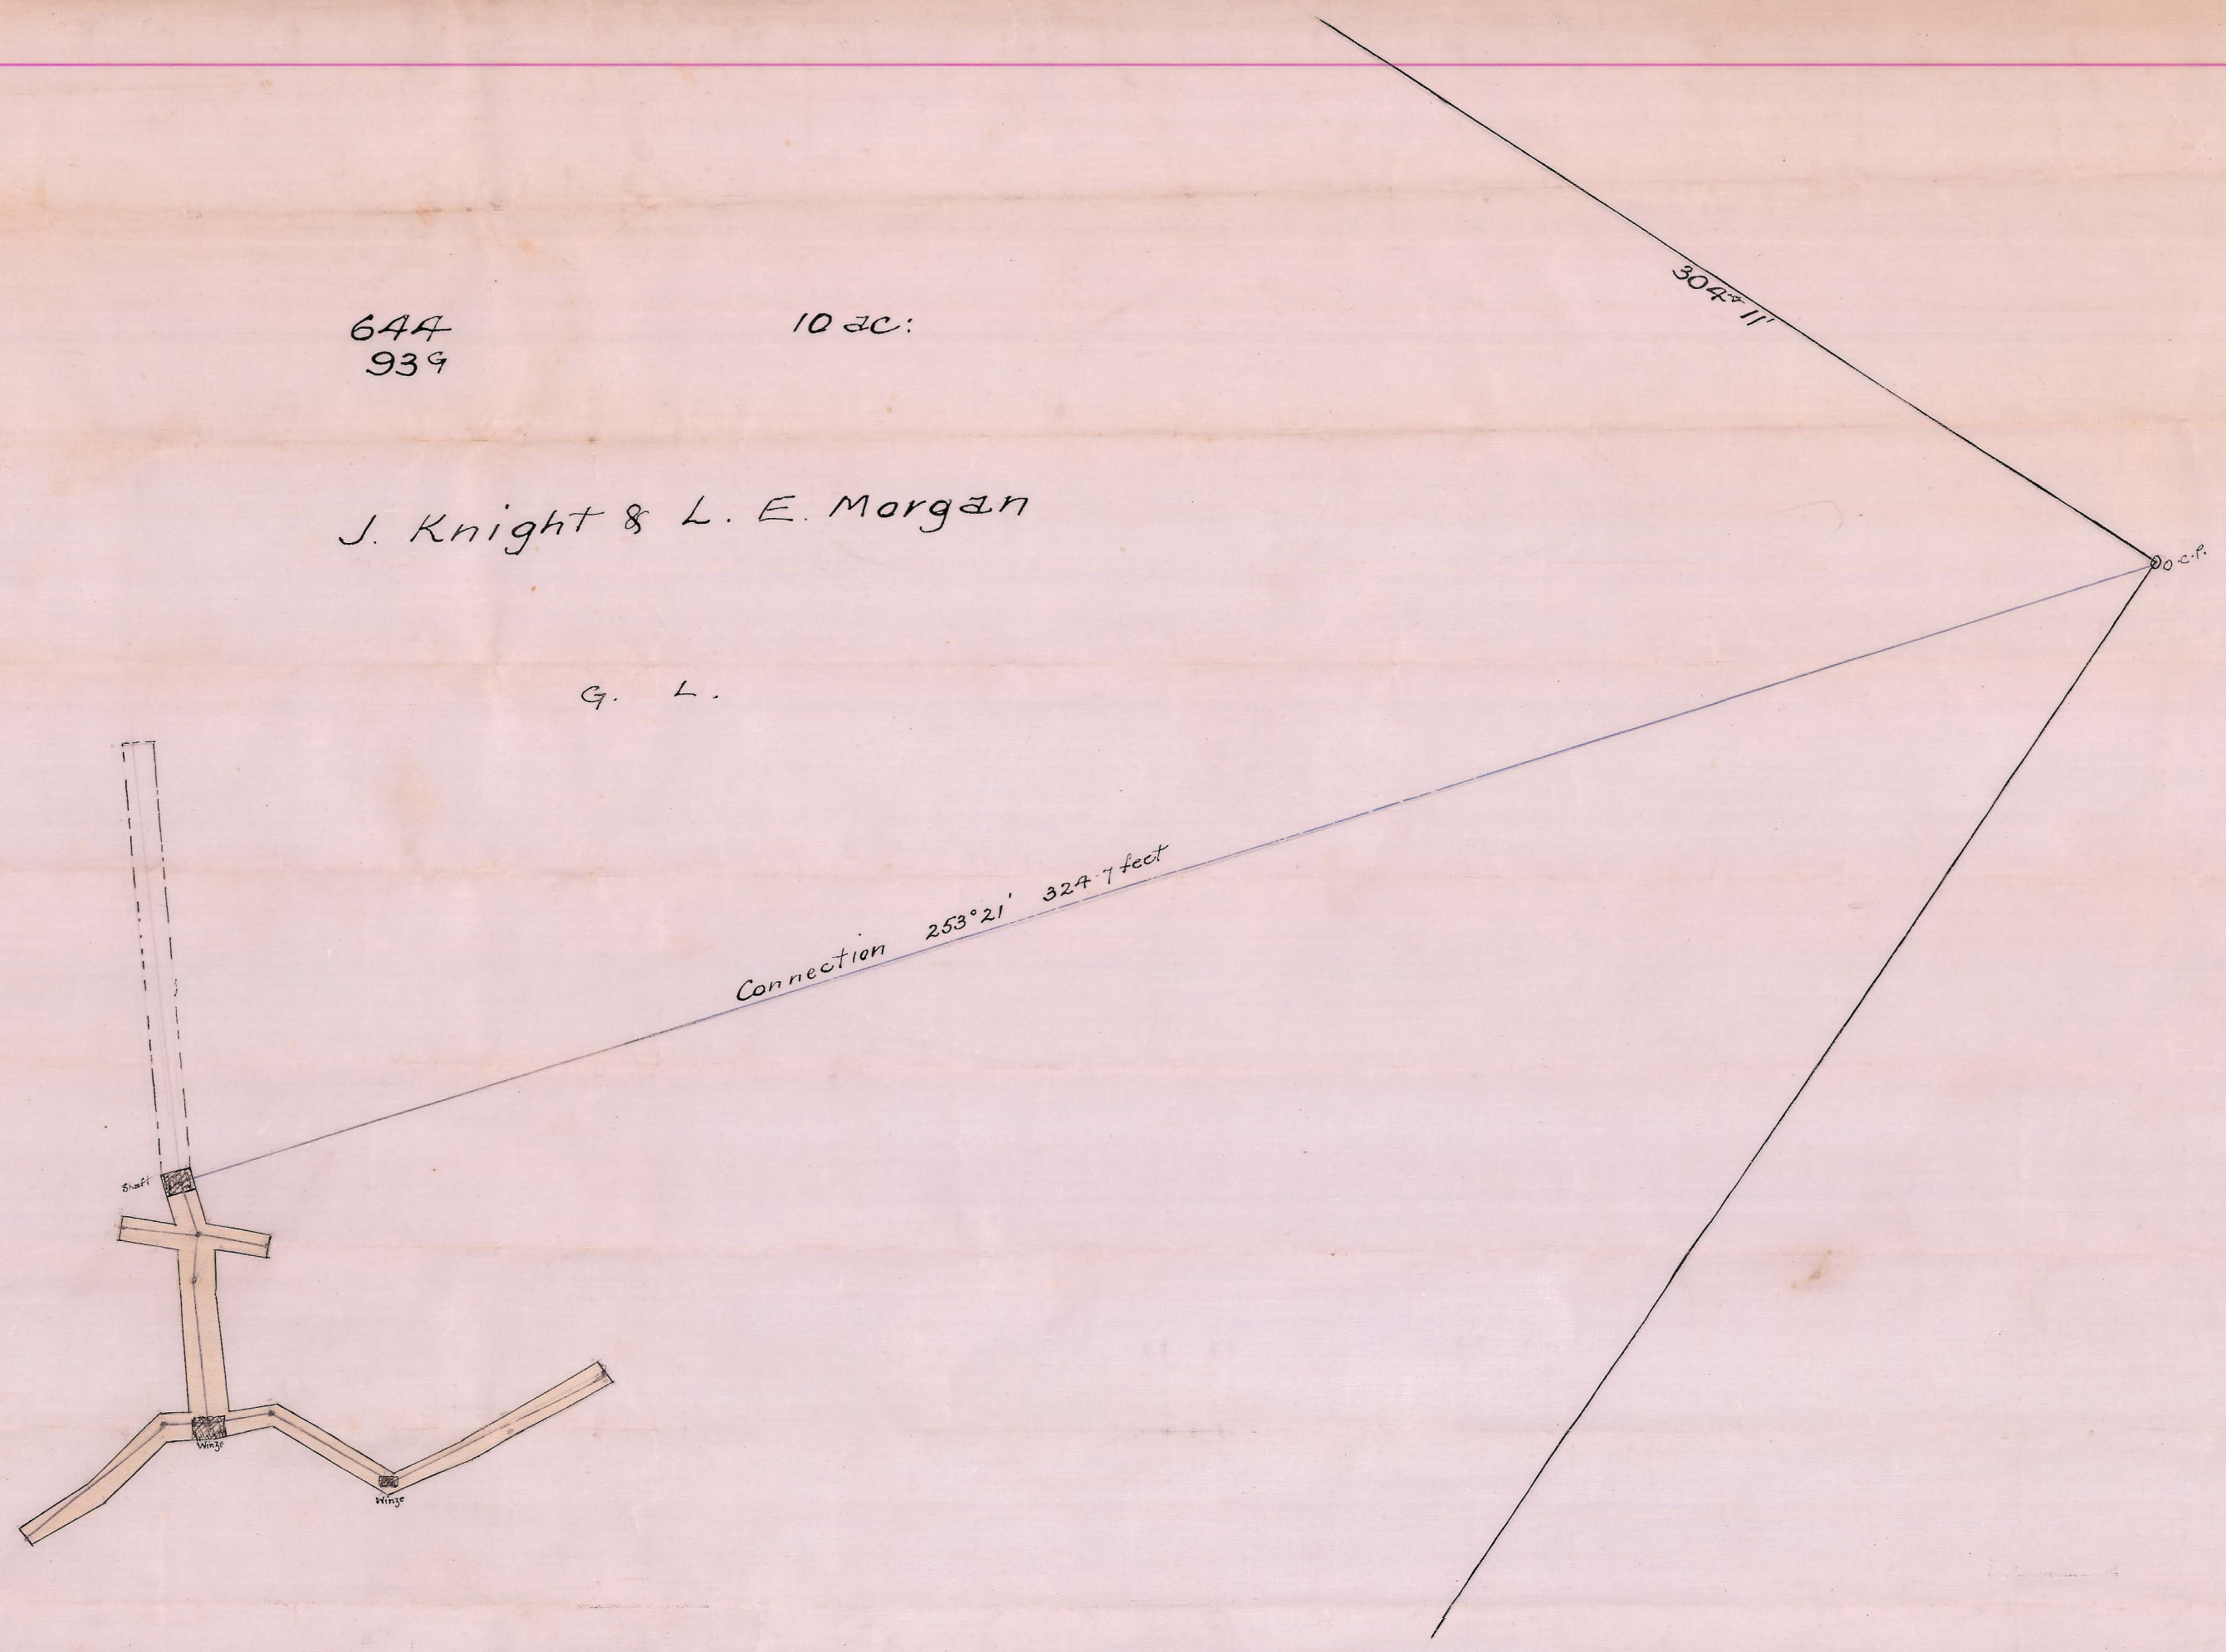

Geo. A. Sorell
D-12
Feb 1897