


84

84




263-02

263-02

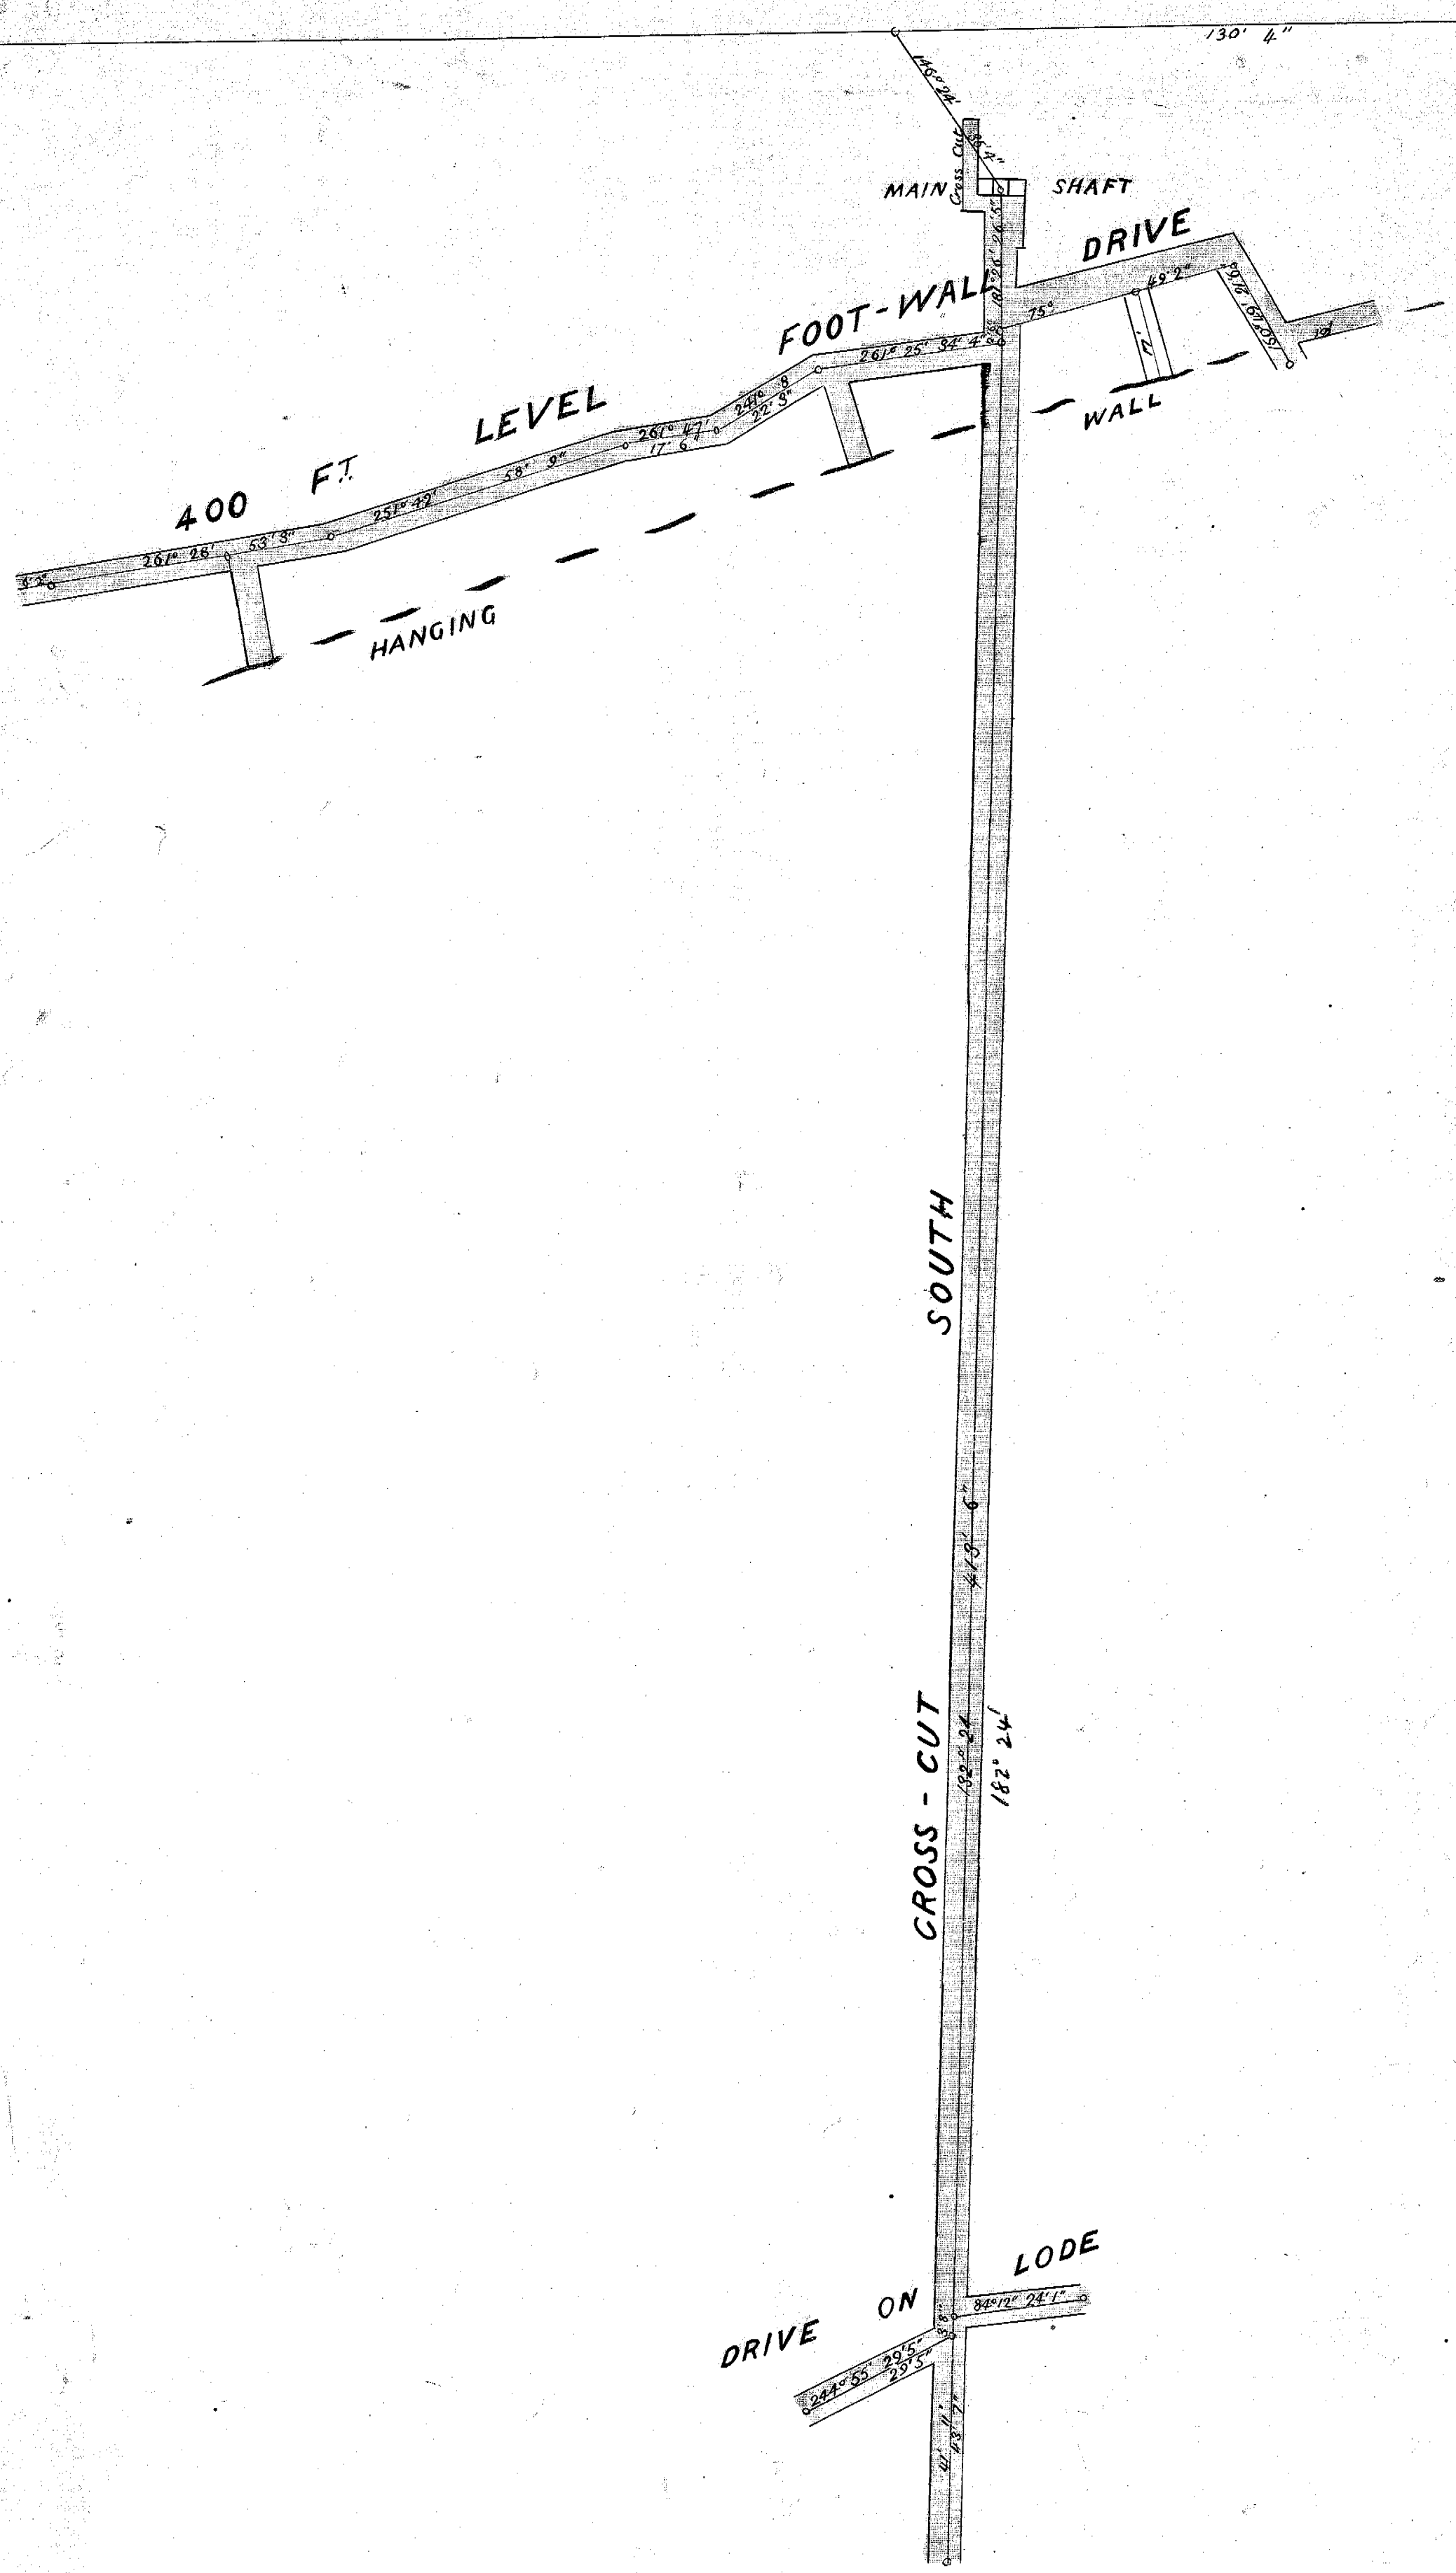

NEW LAND O' CAKES C.M.C. NO LIA
LEFROY

Scale 25 feet to an inch

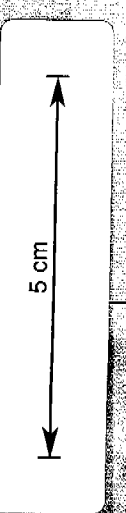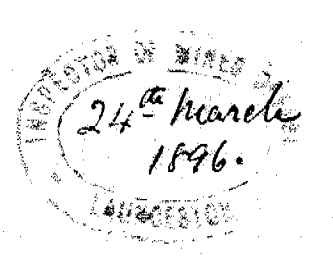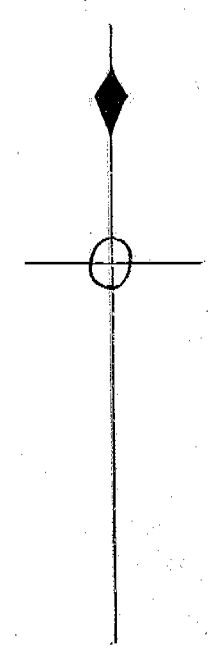

H. J. Miles
Authorized Geologist
from
Jany '96

84