



Jan 1883
New York O. P. Kaye

LAND O'CAKES G. M. CO.


Scale. 25 feet to One inch.

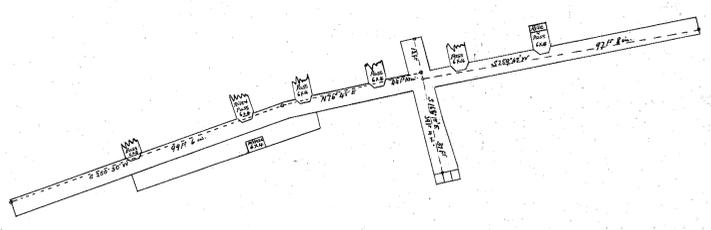


PLAN No. 1 LEVEL

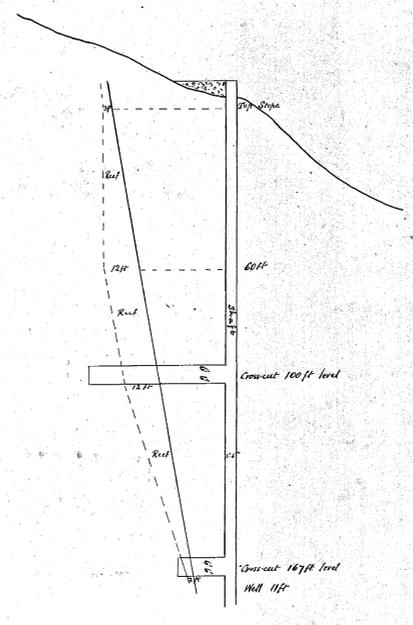

SECTION

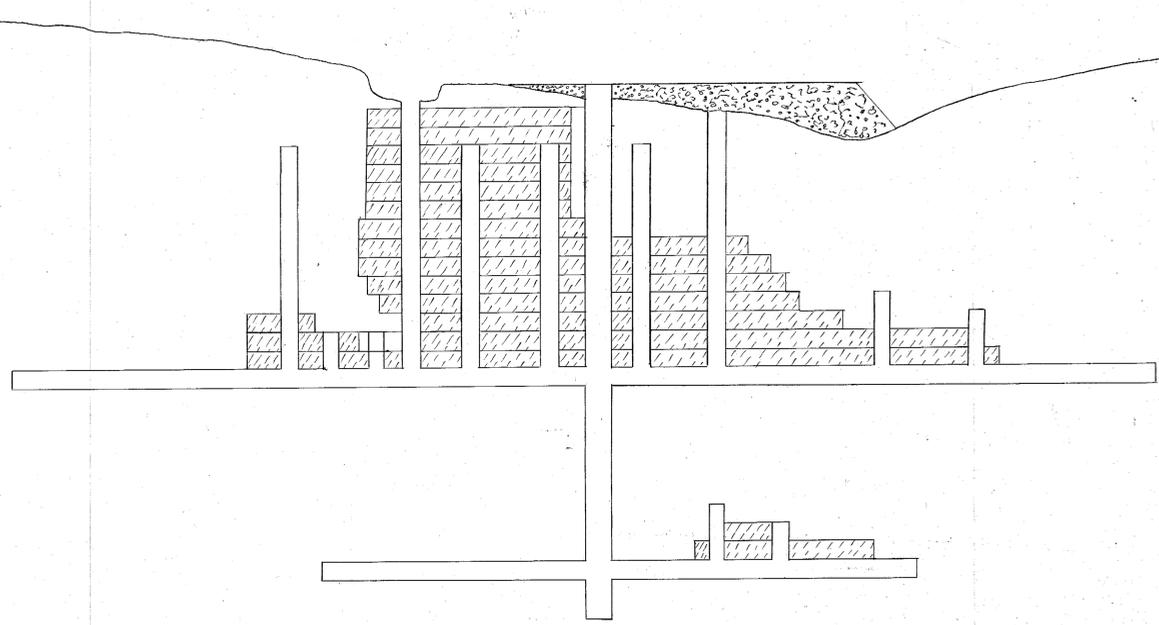

264-d

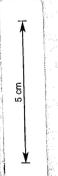

(3) At. Lord
Mining Surveyor
15th Jan'y 1883

This tracing is a copy of a Plan and section
sent to me by Mr. H. P. P. of Albany in
November 1882.
J. H. Montgomery
Geological Surveyor
25th Nov. 1882.