


LAND O'CAKES G. M. C.

Scale One chain to 1 inch


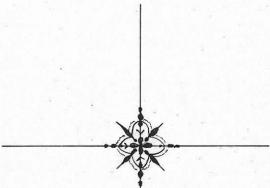


264-02

W A V E R L E Y C O

R O B R O Y C O

B R O S S C O T T S

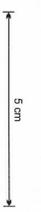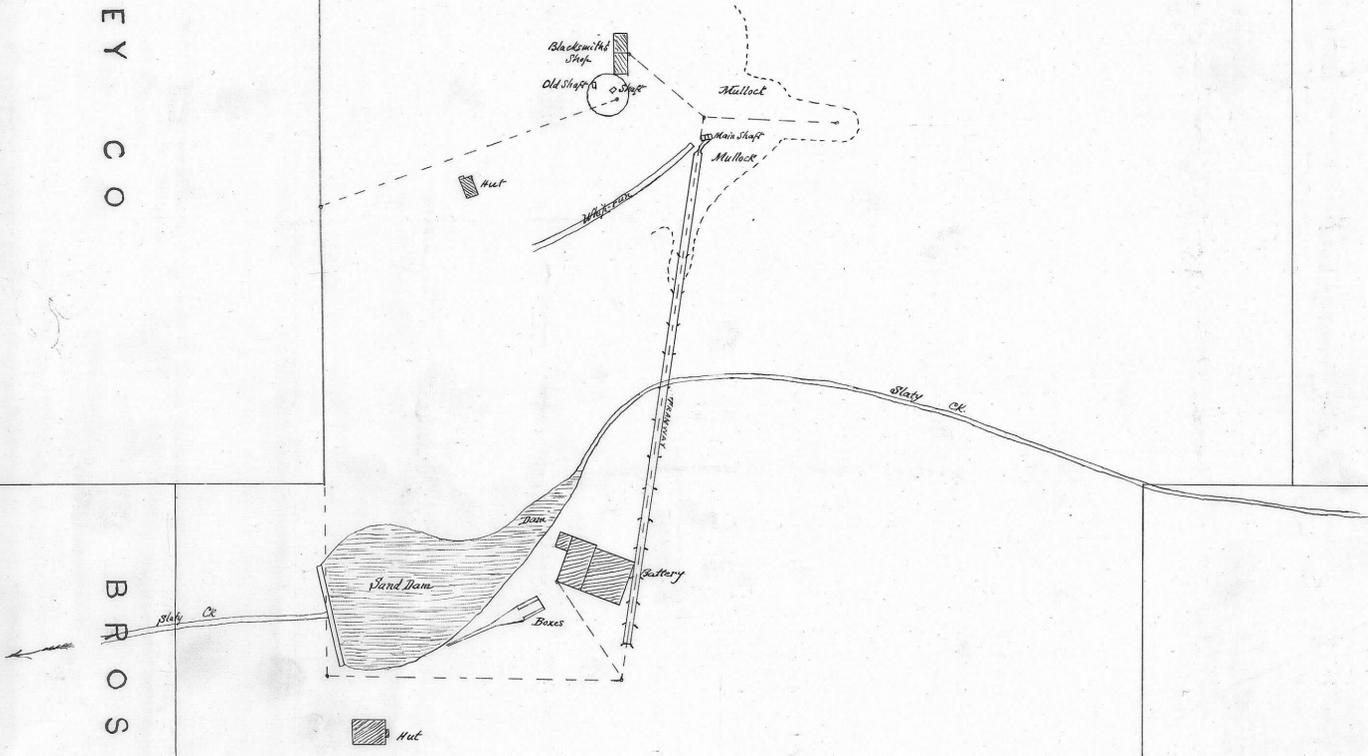

All 265 To O'KANE

264-02

This tracing is a copy of a plan
sent to me by Mr. F. Ross
of LeRoy, November 1885

Chas. Montgomery
Principal Surveyor
23rd Nov 1885

(S) C. W. Lord
Mining Surveyor
15th Jan 1883