



PLAN


THE DERBY GOLD MINING COMPANY. NO LIABILITY

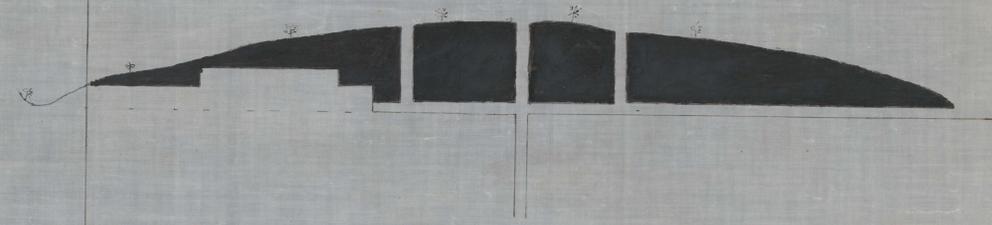


LONGITUDINAL SECTION

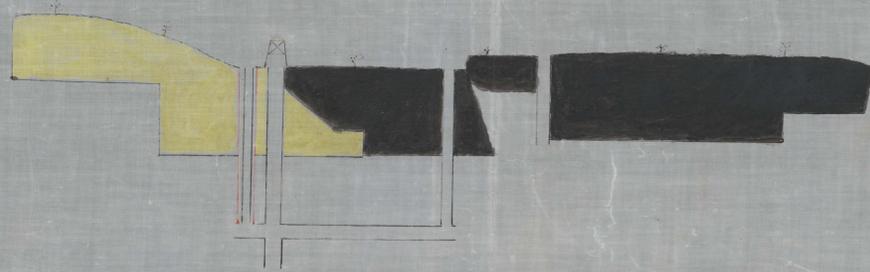

Cross Section Main Shaft

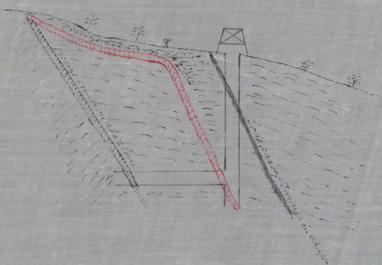

*Horizontal underground section
Main Shaft*

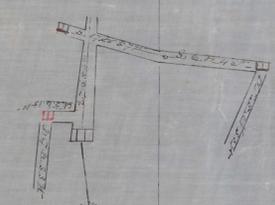

Scale 2 1/2 ft one inch

*Diagrams taken with a Pneumatic level bar
The dark shade is worked ground on the surface
The yellow shade is worked ground on the level
Surveyed by George Young Jan 6th 1894*

*Section 6000
875*

*Section 6000
1000*

*Section 6000
570*