

664 I

32



266-04

669.
879.

956.
879.

753.
879.

642.
879.

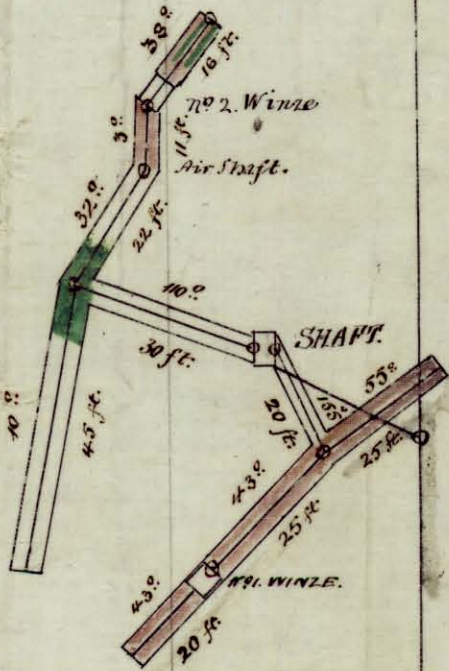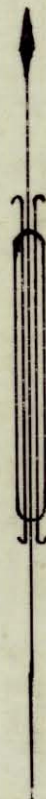

LATER MARA G Mine
WARRENTINNA
THE

CORONELLA EXT^d G.M. CO^{ys}
no liability.

PLAN

of underground workings at 40 ft. level.

Reference

- No 1. Winze 29 feet
- " 2. " 30 "
- stoped out to surface marked
- " " under foot 4 ft.

Scale 30 FEET to an inch

Taken by "Prismatic Compass" 14th May 1895
C. W. King
of Murrumbidgee



35 feet.

DATUM.

660.
879.

10

1369
G.
20 ac

1420
G

5 ac

178
3

167
5

1410
G

5 ac

178
2

5 cm

266-04