



EAST VOLUNTEER G M C^o N L

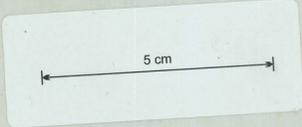

Ground Plan

Scale 25 feet to an inch

Volunteer G M C^o N L

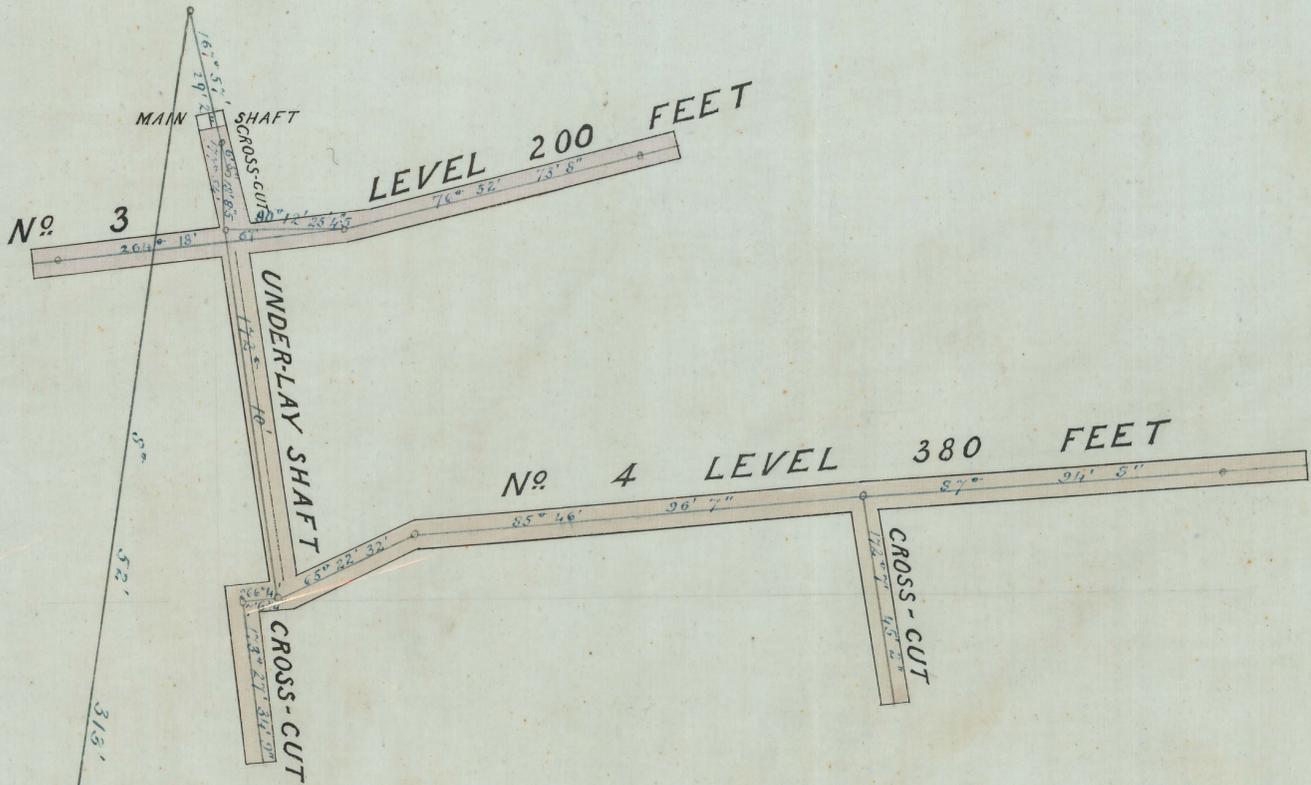

83h
87g

76
93g

Peter Lloyd



Certified copy from plan from actual survey to 20/3/95

M. J. Miles
Authorised Surveyor

Lefroy
2/4/95.