



CORONELLA EXTENDED C.M.CO.

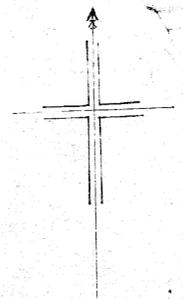

PLAN OF MINE
 EAST VOLUNTEER C.M.CO.
 WARRENTINNA
 SCALE 50 FEET TO AN. INCH

S. Slutton
 Mining Manager
 22/1/98

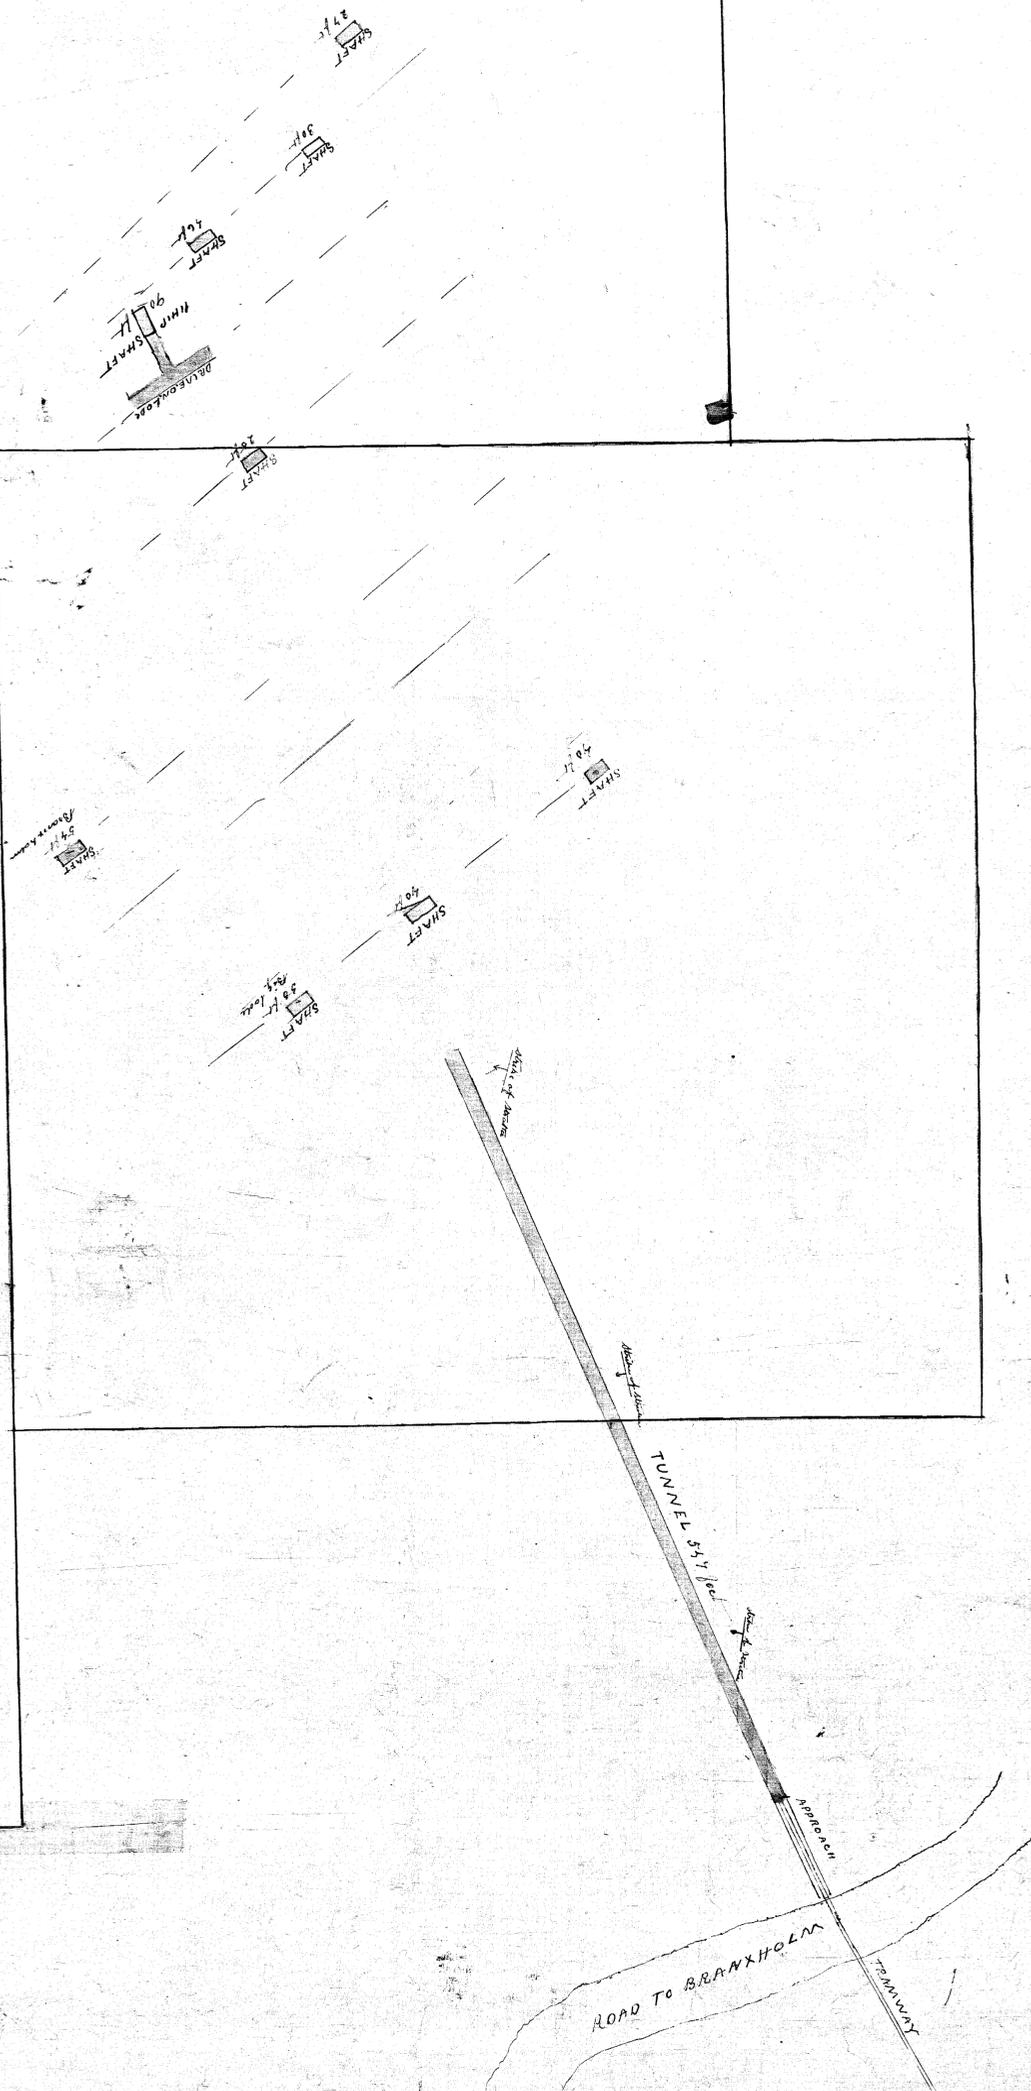

WARRENTINNA
 M. & A. G. M.
 1001
 1808

26607



266-07