

5 cm

266-10

CONSOLIDATED LEASE
1117 - 110. 0. 0



NEW GOLDEN MARA CO.

BRANXHOLM - TASMANIA

SCALE
FT 0 20 40 60 80 100 120 140 160 180 200

*W. H. Condy
September 1914.*

*J. S. White
25/6/18*

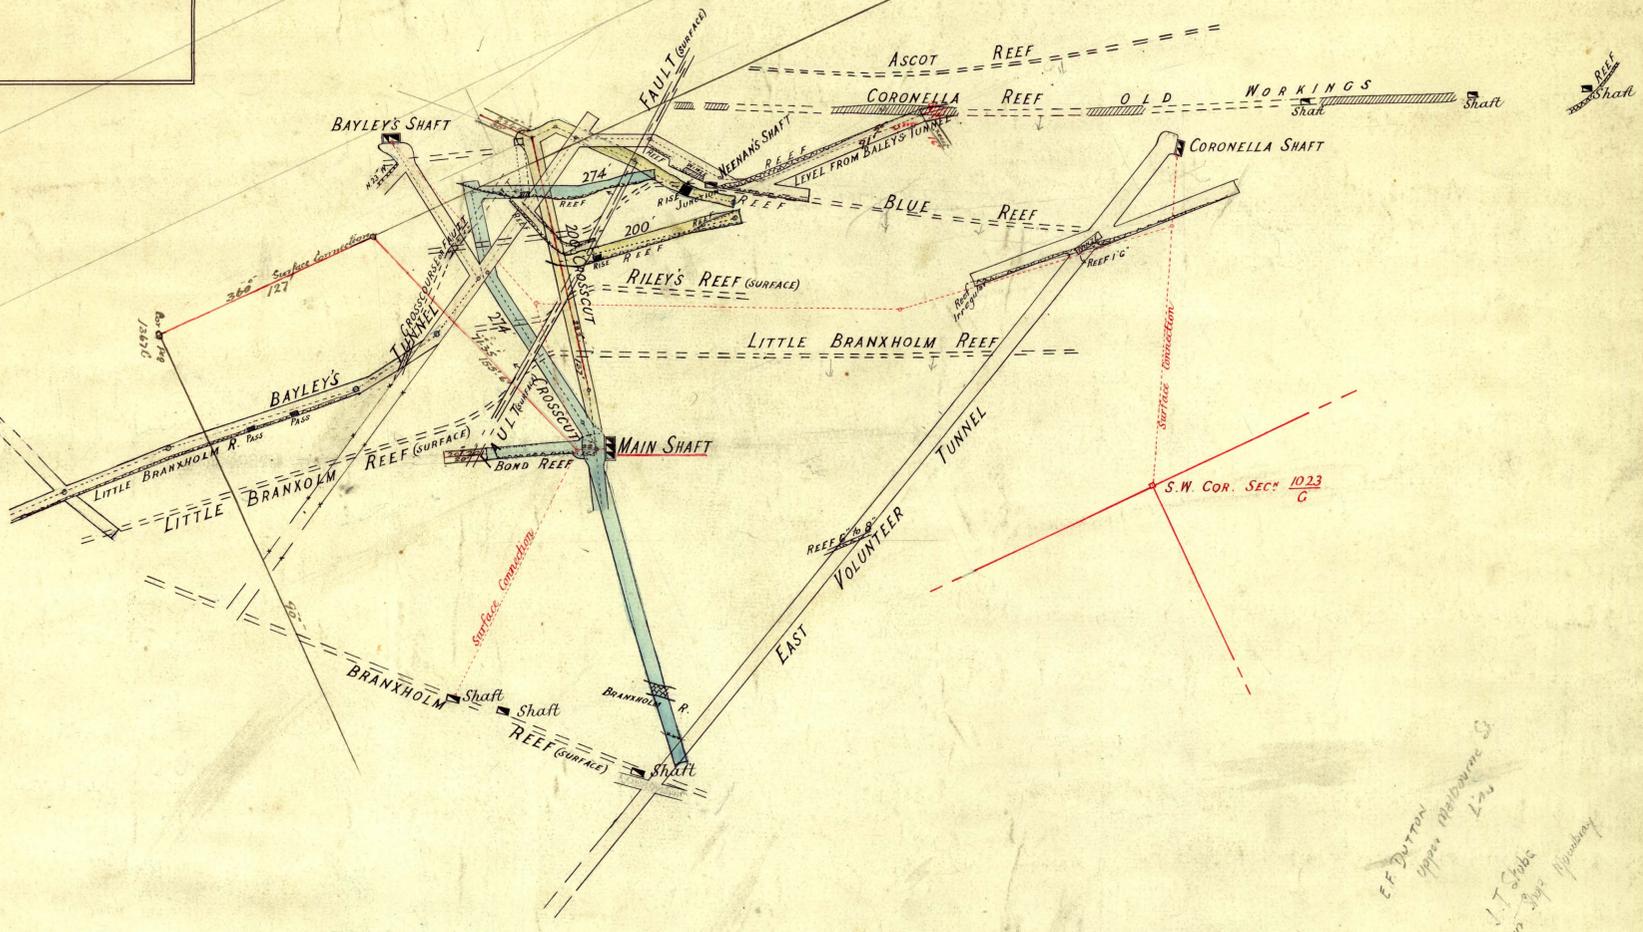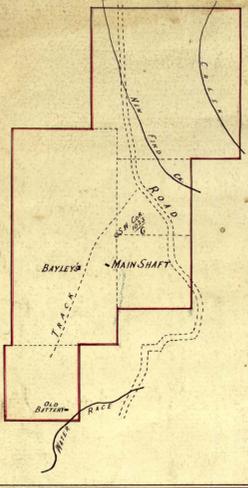

*E. F. DUTTON
Upper Middle Devonian L. 245*

*J. T. White
Sep 10 1918
W. H. Condy*

