


266-11



266-11

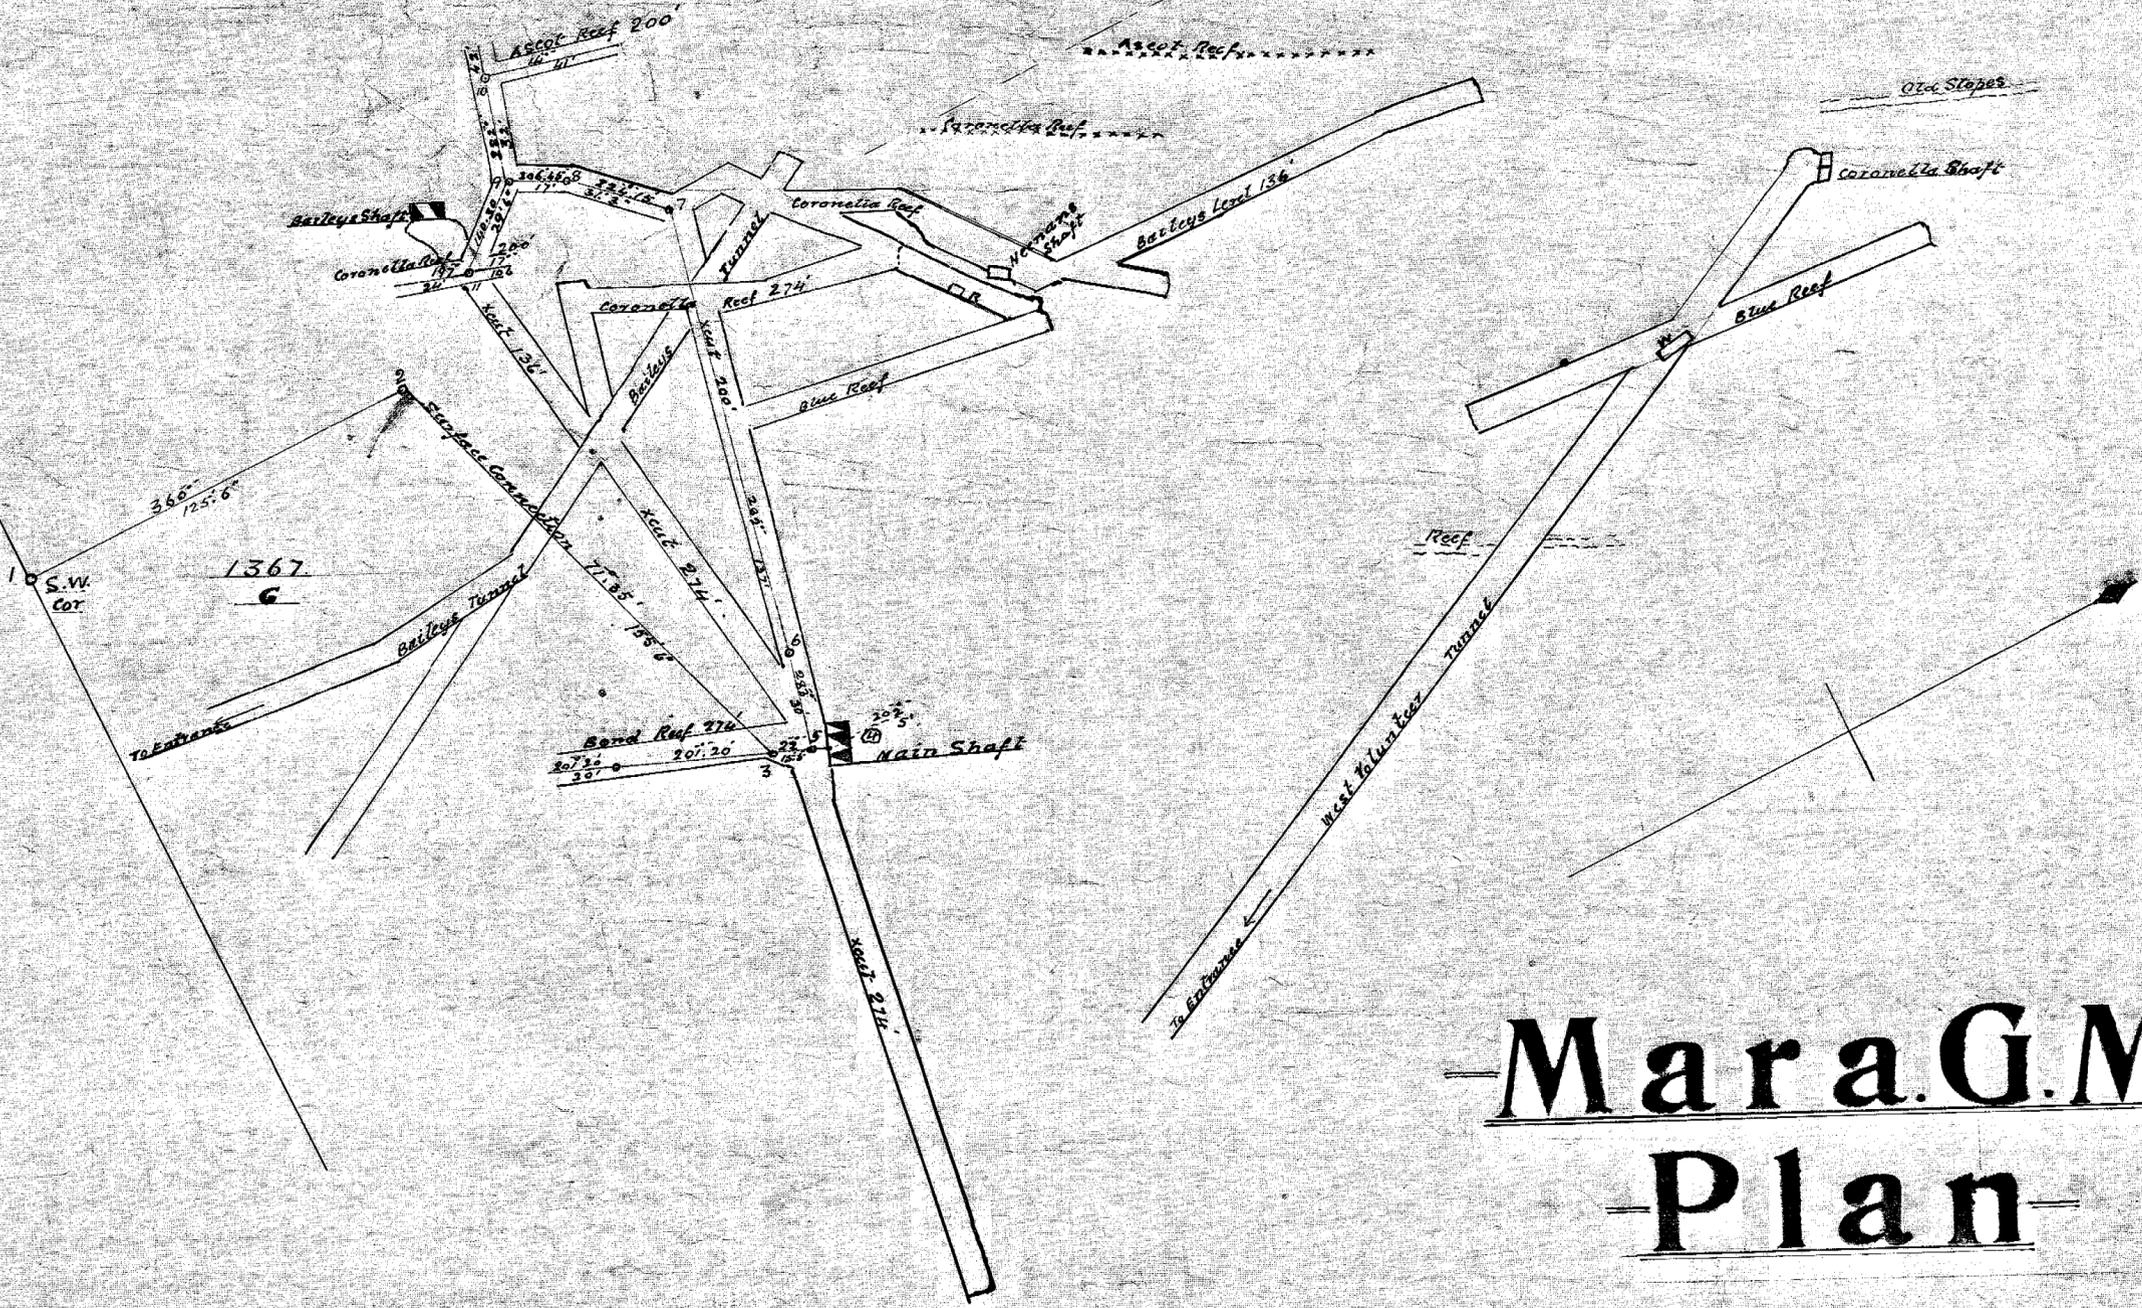

Mara G.M.C. Plan

Scale 40 Feet to 1 Inch

WARRENTINA

J. J. White
mine eng
3/12/18

MARA
WARRENTINA

21/11/18

SEP
18