
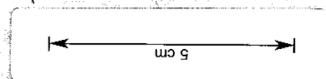


51-
996

EAST VOLUNTEER C.M.C. NO L^{IA}

LEFROY

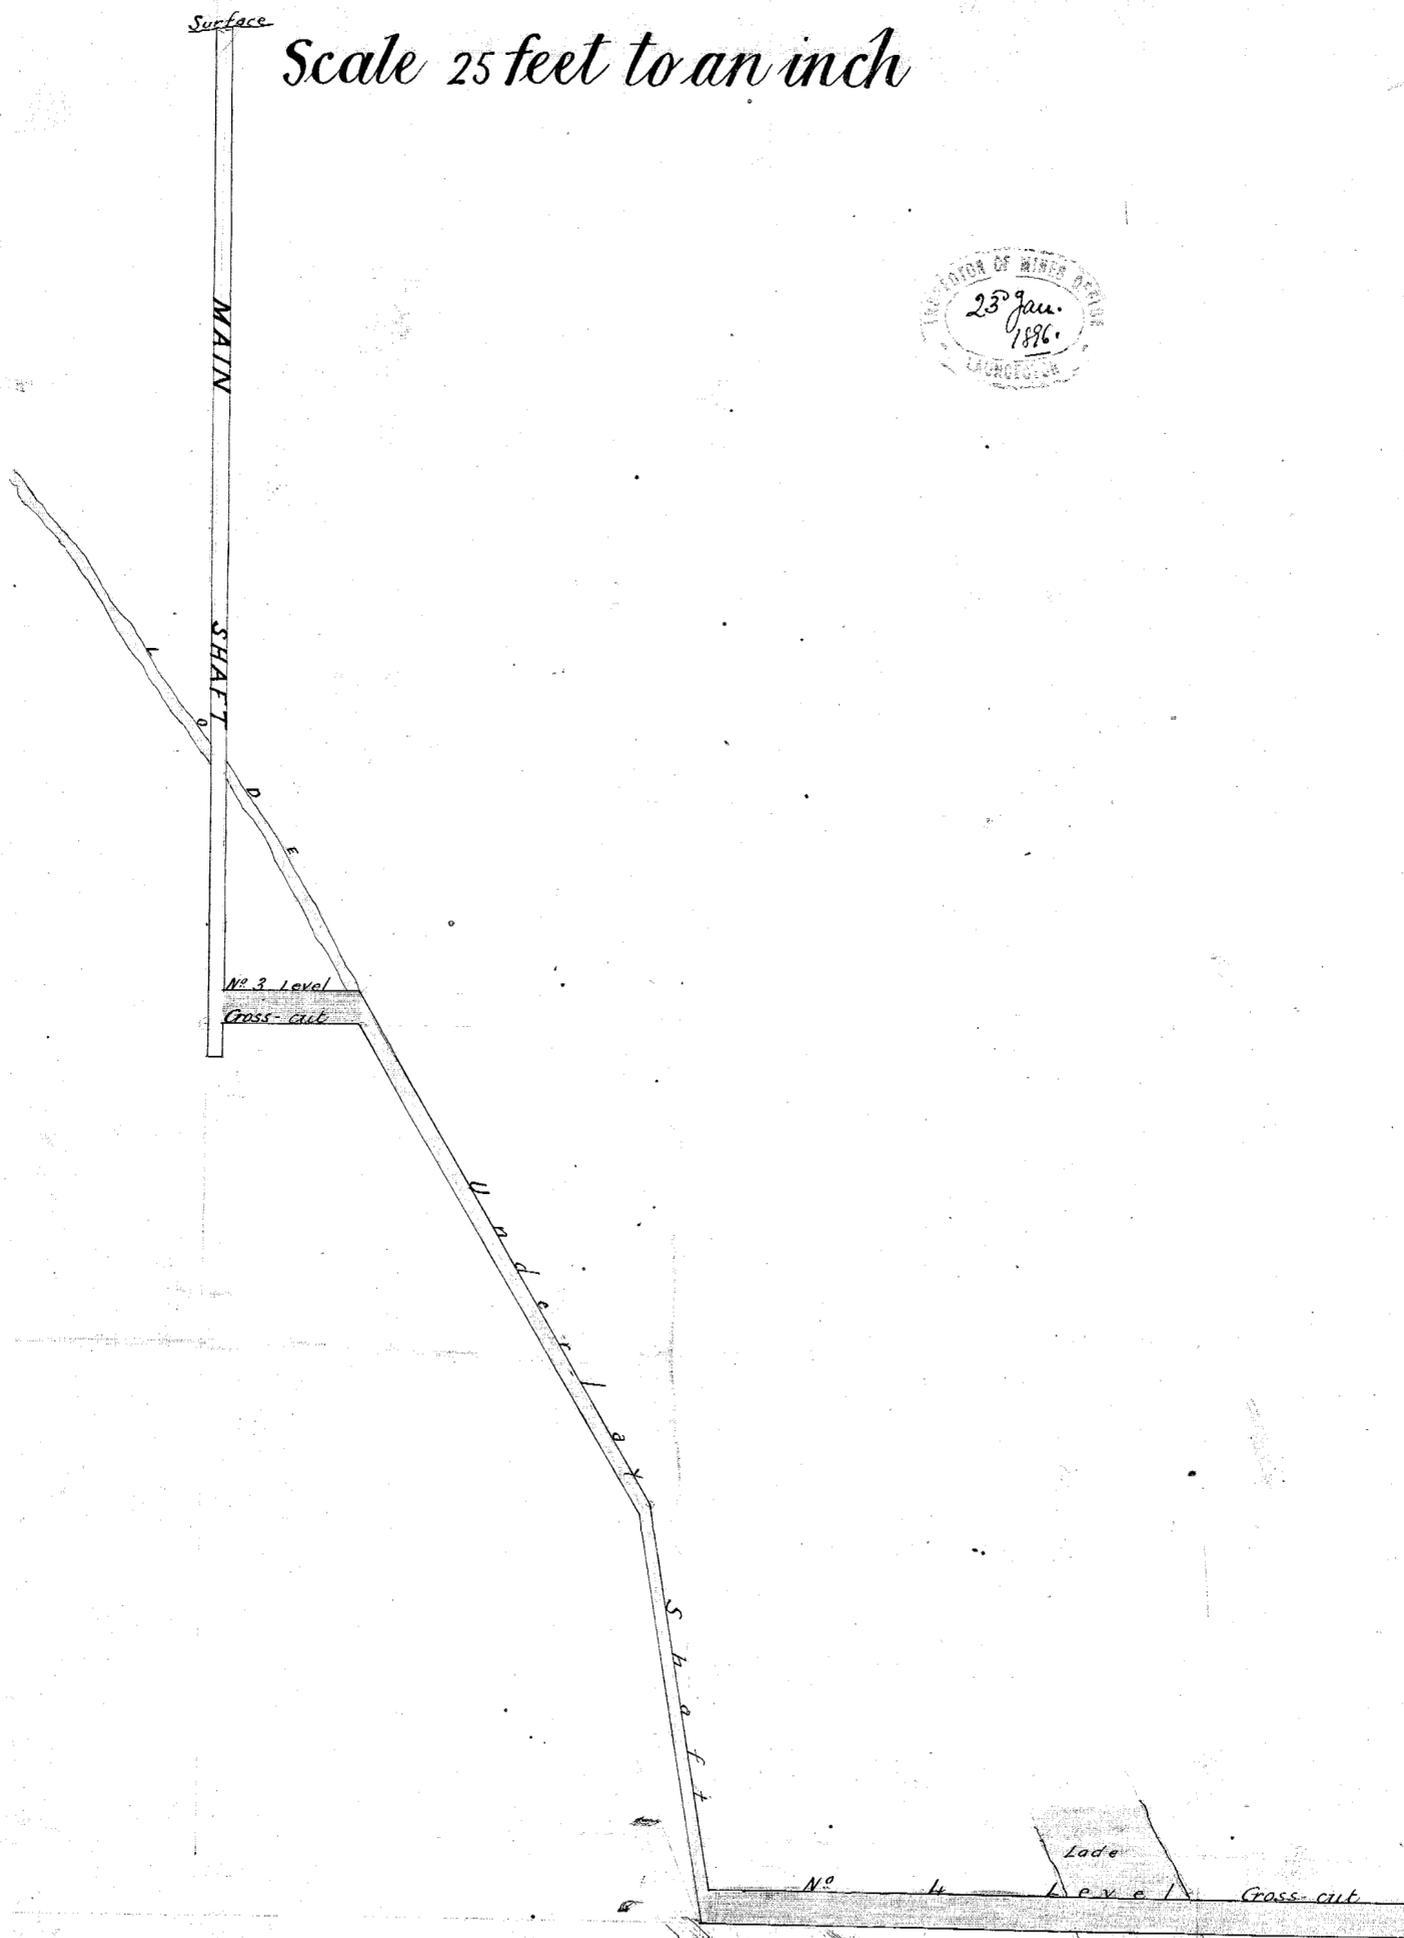

W. J. Miles.
Authorized Surveyor
January 1886

51-
998