



(B)

LONGITUDINAL SECTION

LOOKING NORTH

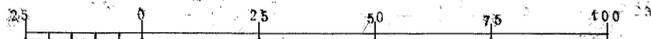

DEPARTMENT OF MINES, QUEENSLAND  
 25<sup>th</sup> April  
 1898  
 SAUNDERS

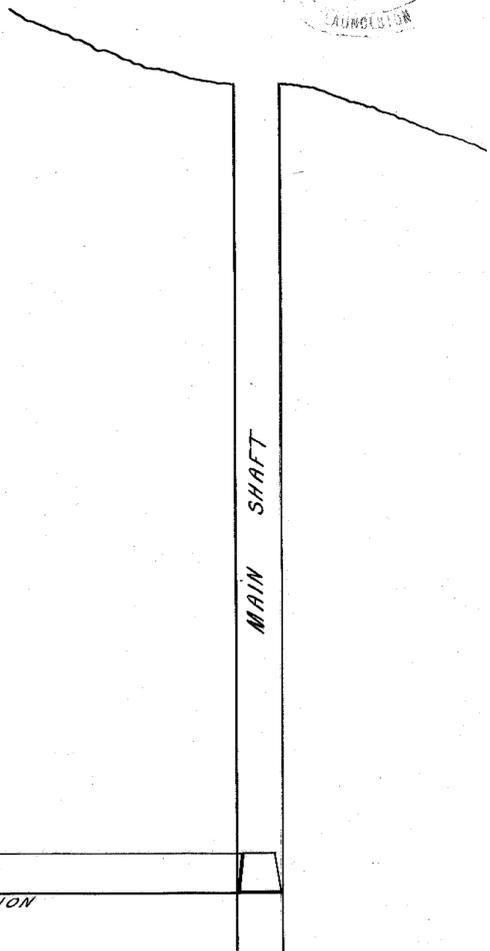

5 cm

WEST PINAFORE

266  
-51

Surveyed and drawn  
 by B. E. Roberts  
 18<sup>th</sup> March 1898  
 Department of  
 Geology, Queensland  
 18<sup>th</sup> March 1898

266  
15