


267-01

5 cm

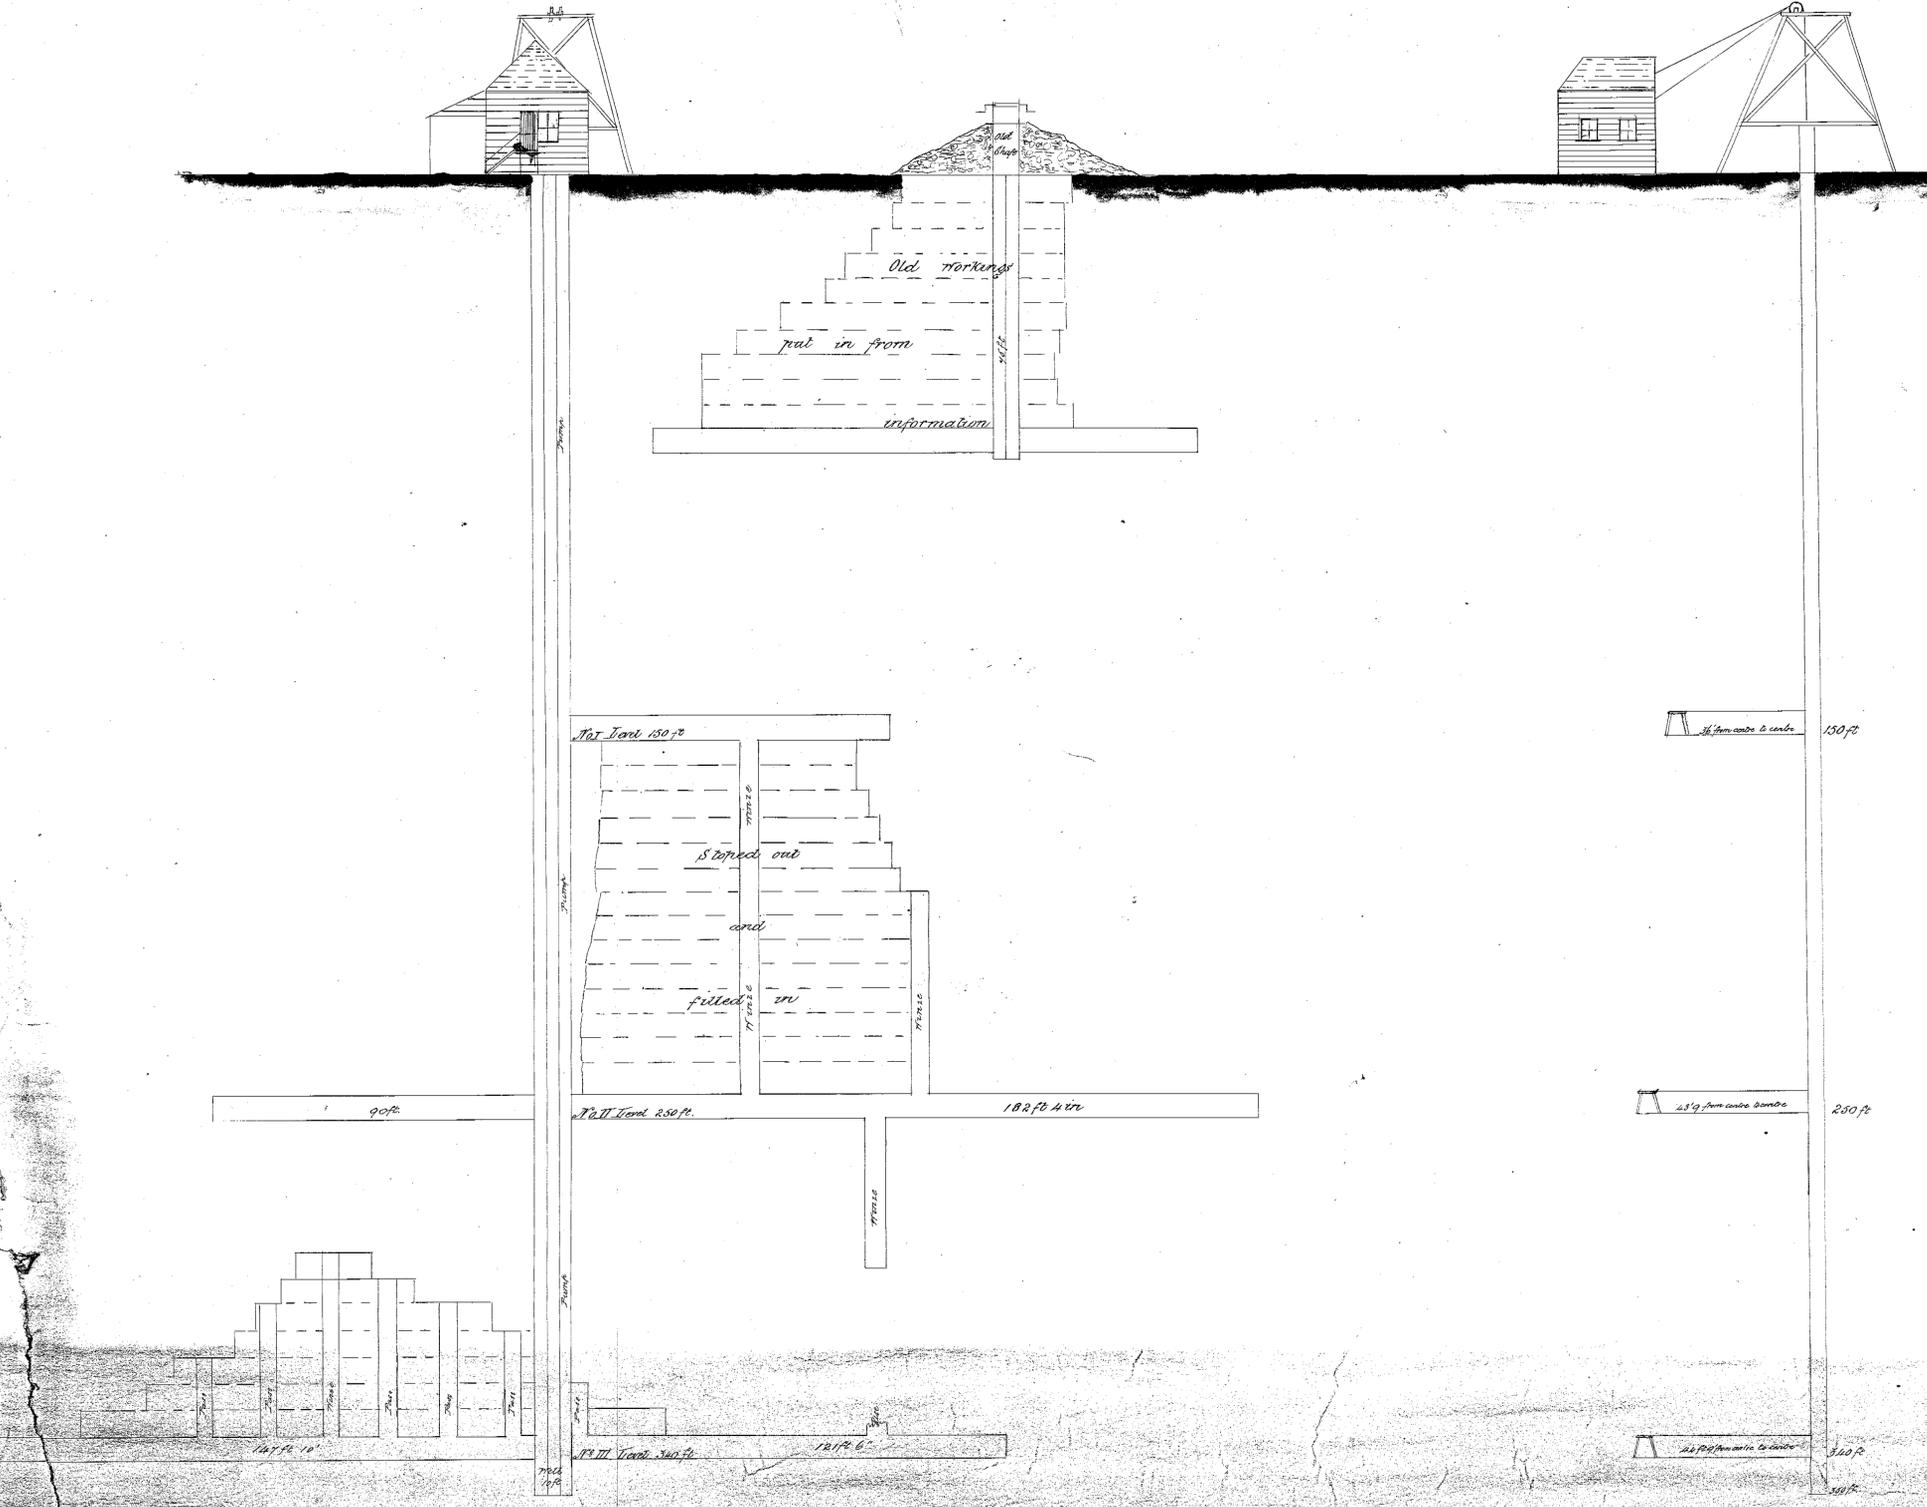

MORNING STAR C.M.C. WORKS

LEFROY

Scale 25 feet to one inch

Charles Wrightman  
Mining Manager

Inner Shaft 36 x 10'6 in the clear  
Saves 4'6 in cas, 6'6 in leg, 1' spread

Edward  
Mining Engineer  
26<sup>th</sup> March 1883