

32

Fig 33


Vertical print




267-02

Mining for 1883

267-02

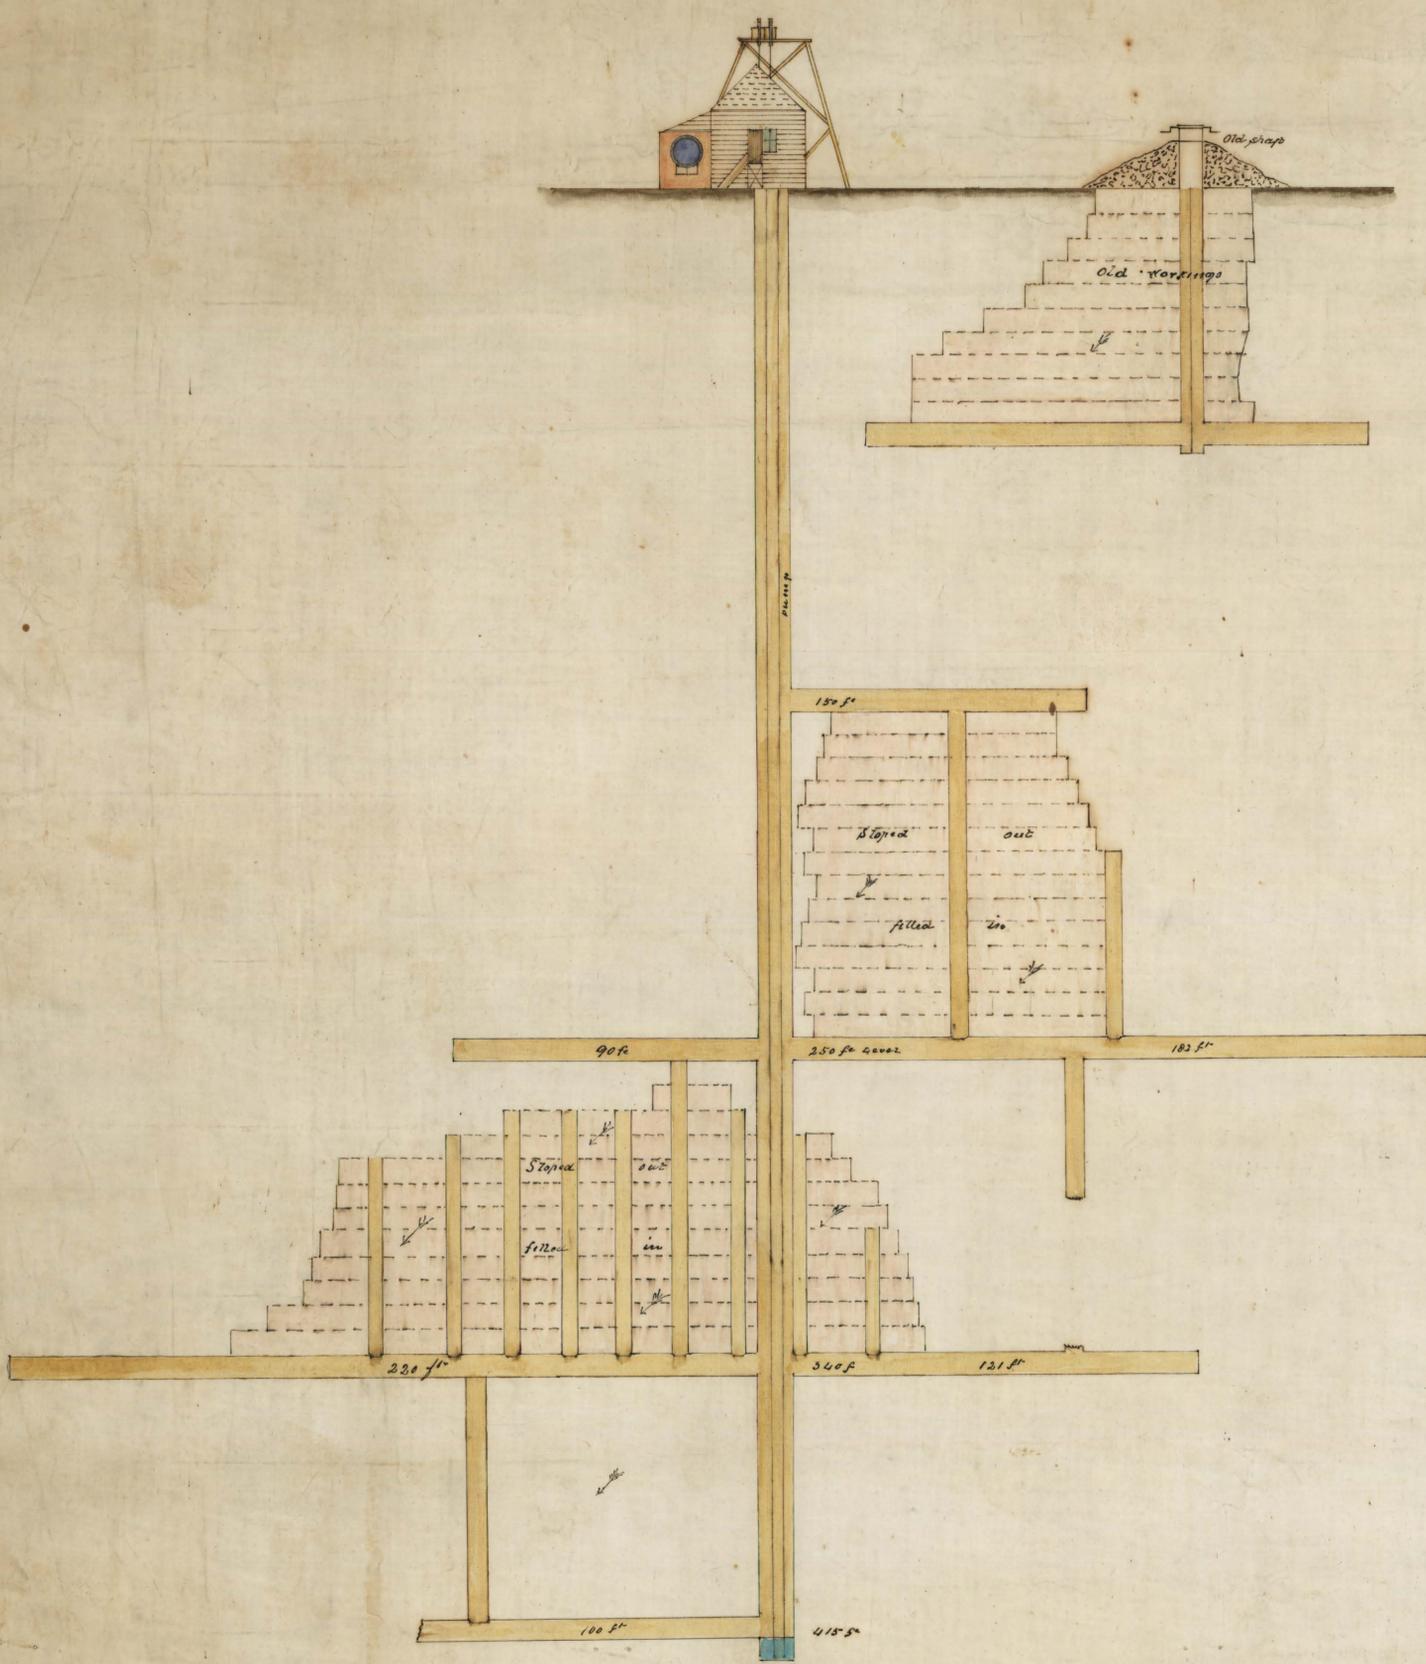

Section Looking North

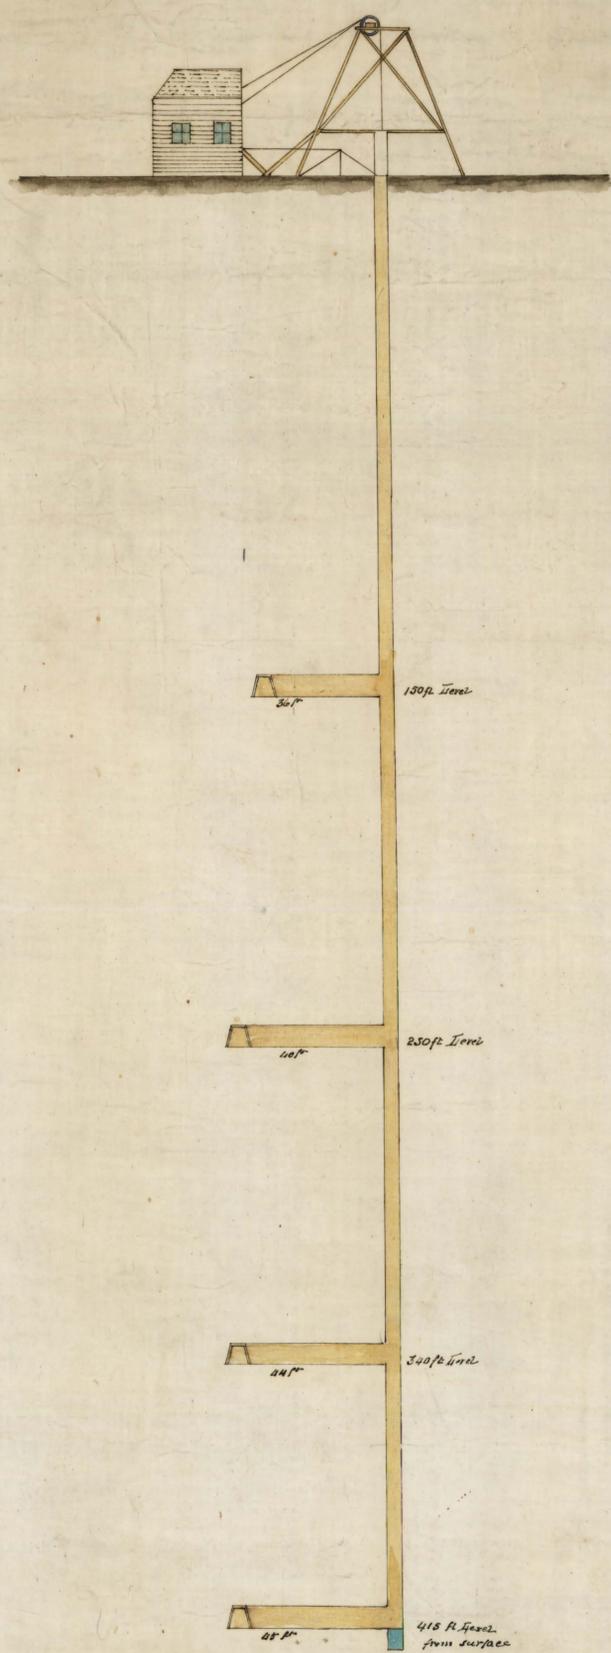

Section Looking West

MORNING STAR Q.M. CO'S WORKINGS
LEFROY
Scale 25ft to One inch.

Memo
Shaft 10 1/2 in in the clean
Lined 4 1/2 in cap 6 1/2 in 1 ft spread

James Boughtman
Mining Engineer
Manager
7/1/84

1881. mt
W. J. ...

32