



PLAN
OF
MORNING STAR & CO WORKS
LEFROY

Scale 25 feet to 1 inch

1884
1884

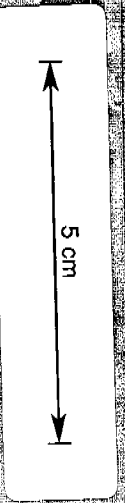


267-03

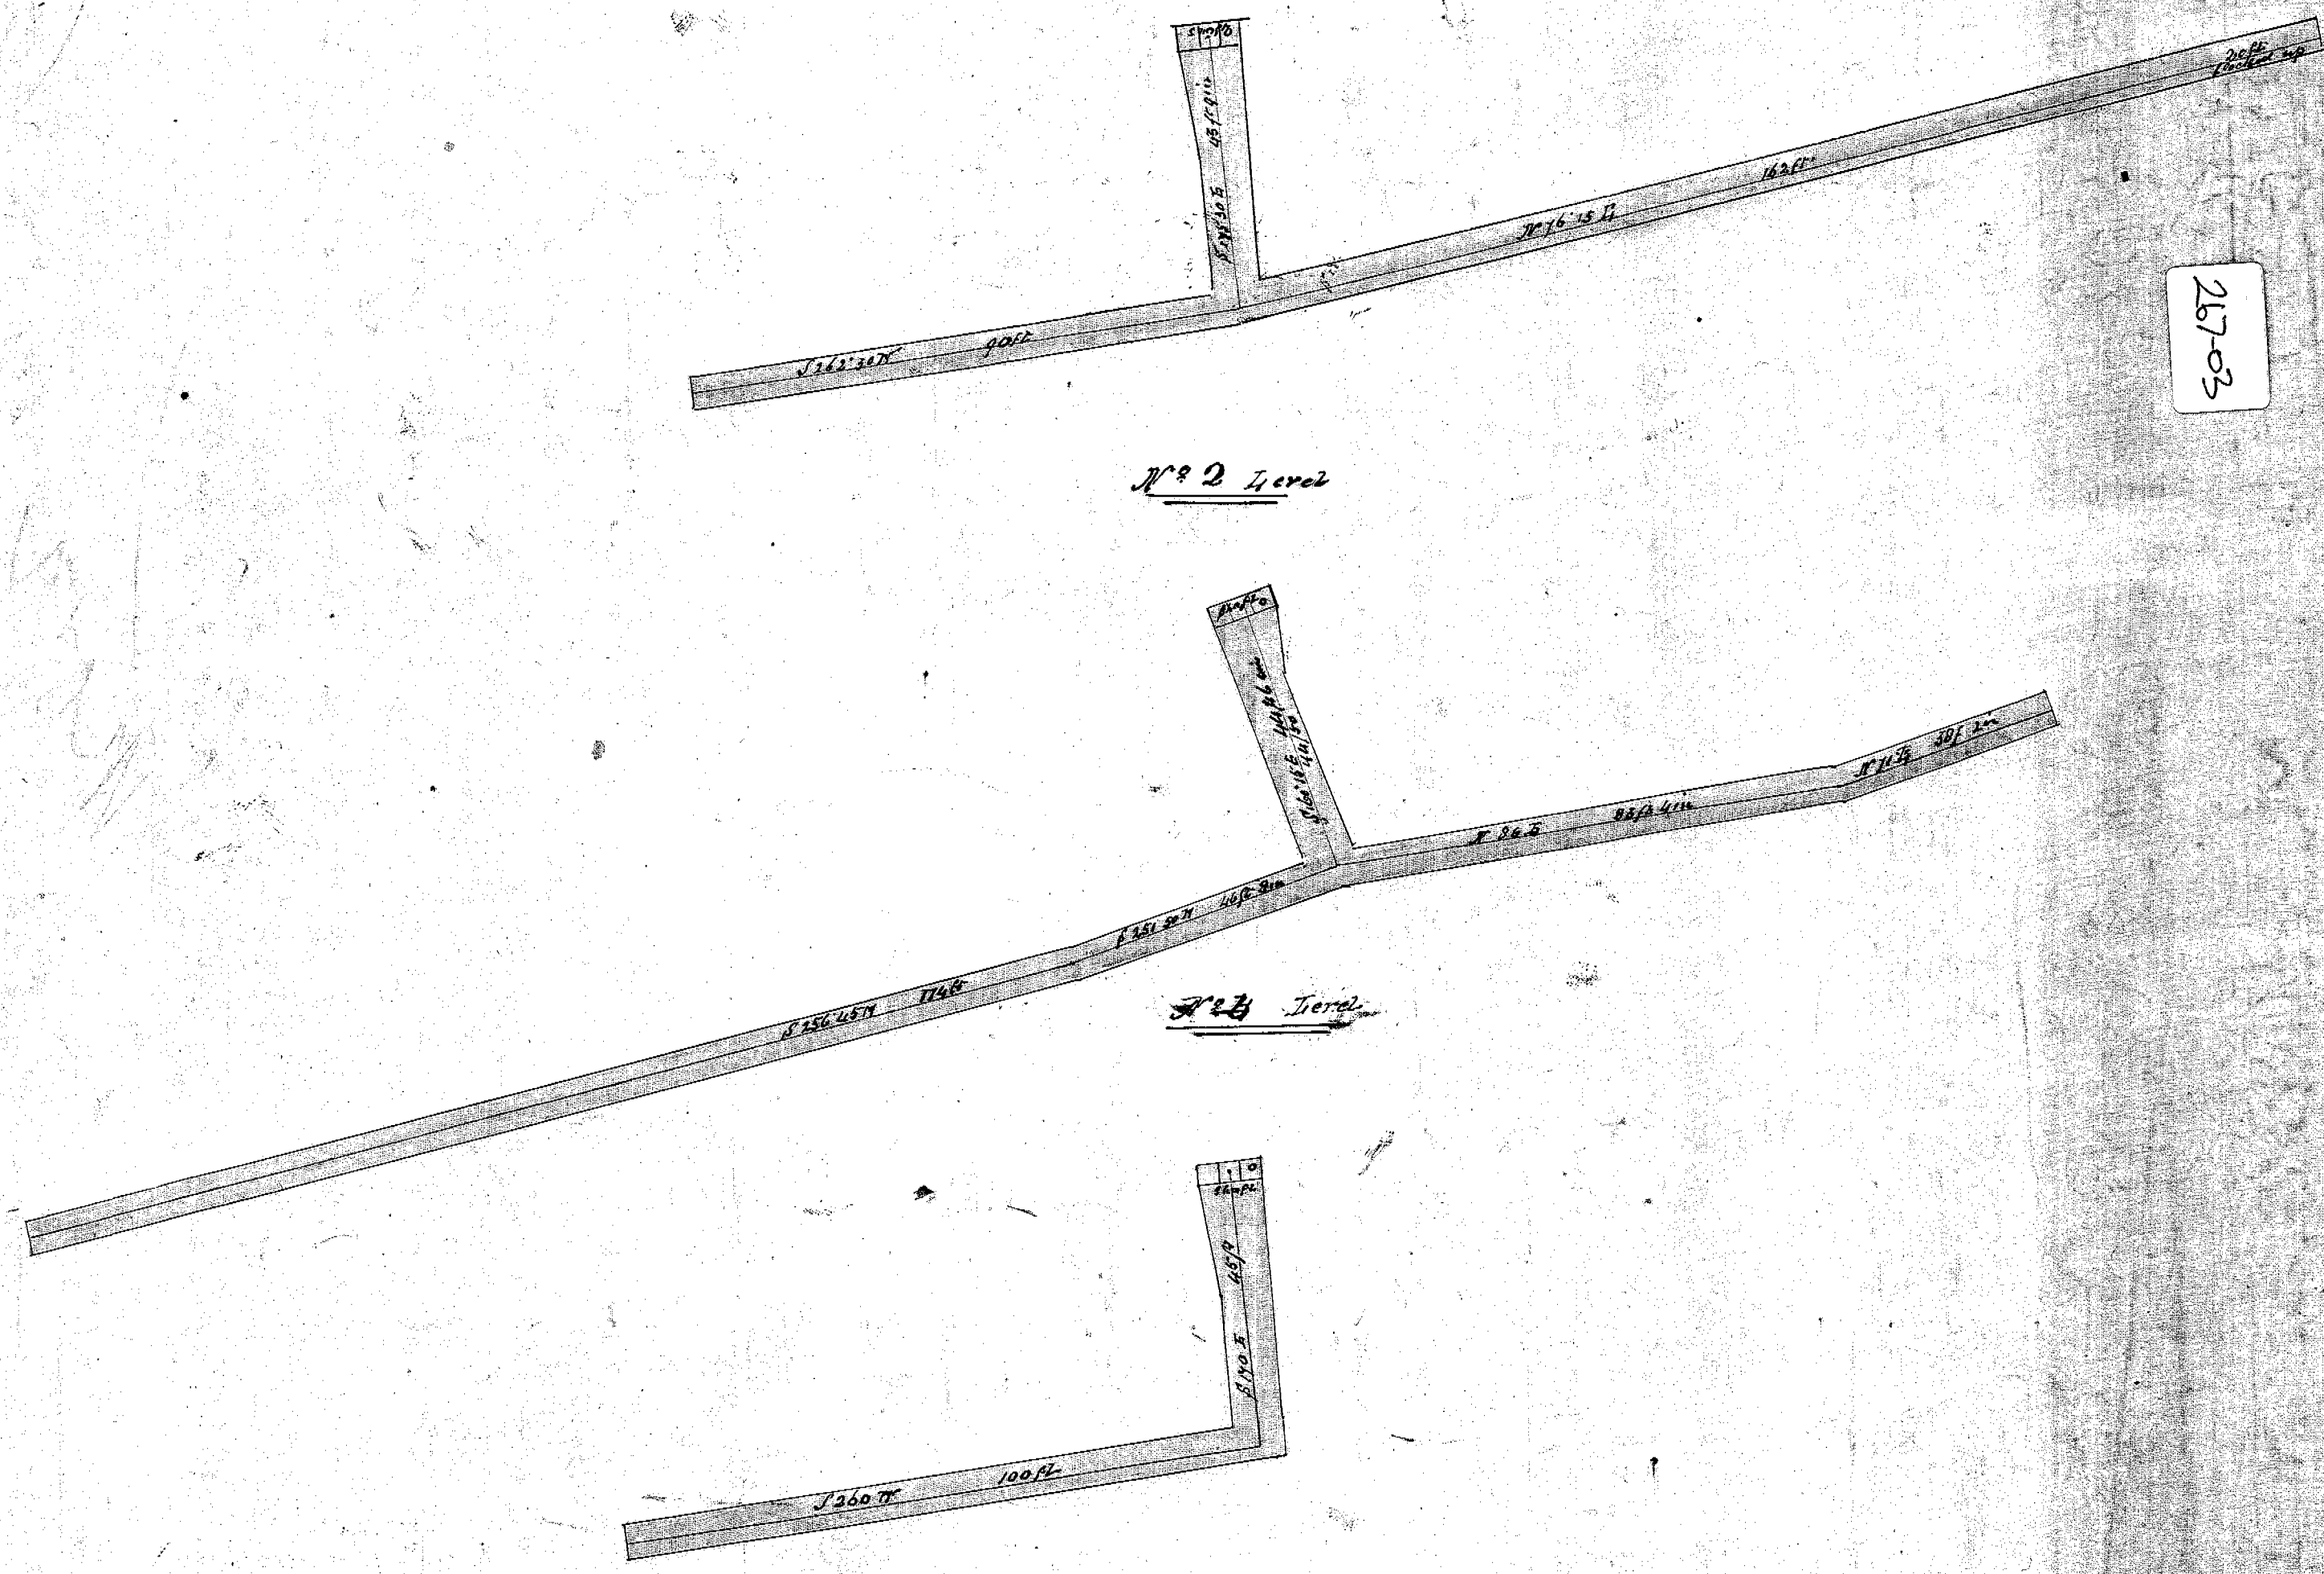

No 1089

T. Hogg

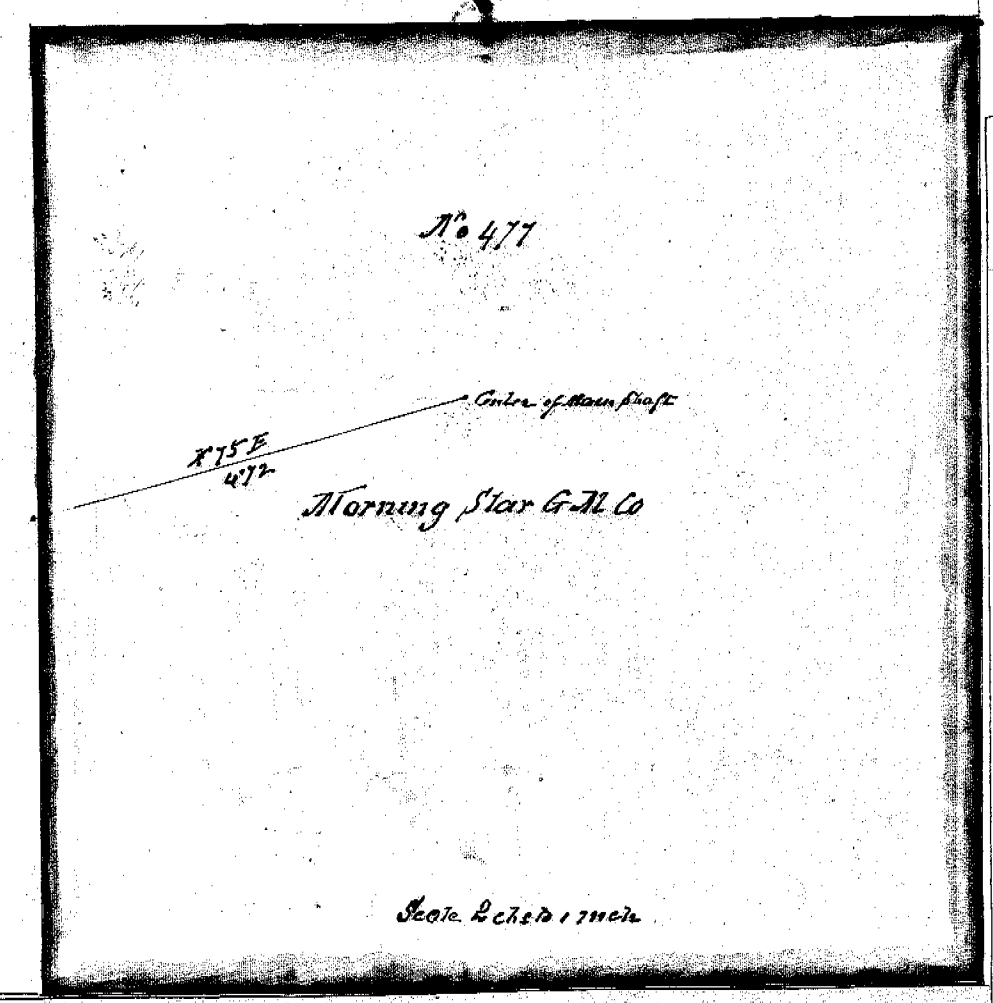

Scale 25 feet to 1 inch

Excelsior

No 514

Barb. & others

James Bouchman
Mining Engineer
Manager
30/1/84

267-03

266, 367, 315, 318