
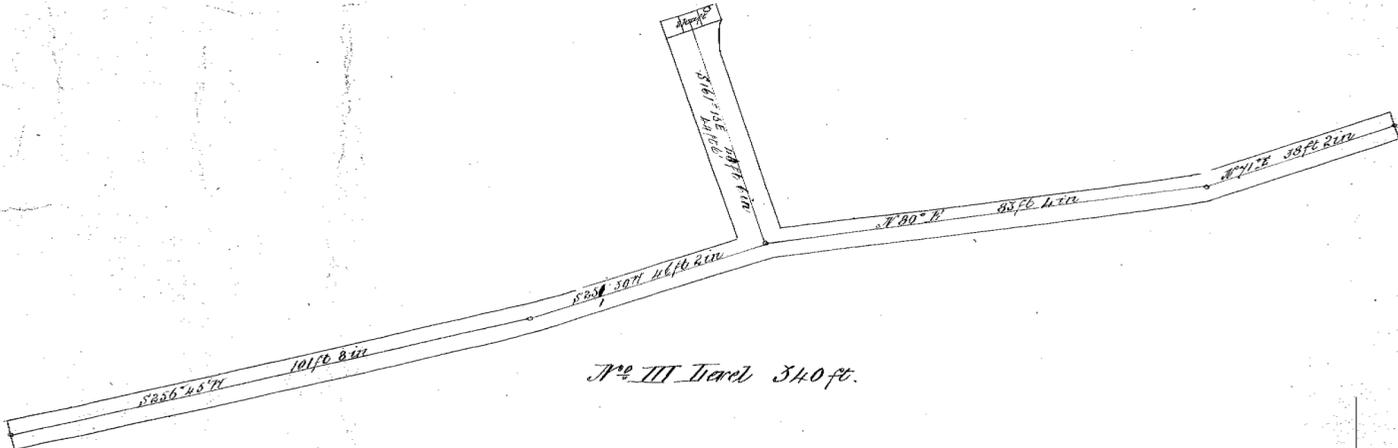


267-04

MORNING STAR G M C^os WORKS.

LEROY

Scale 25 feet to One inch.

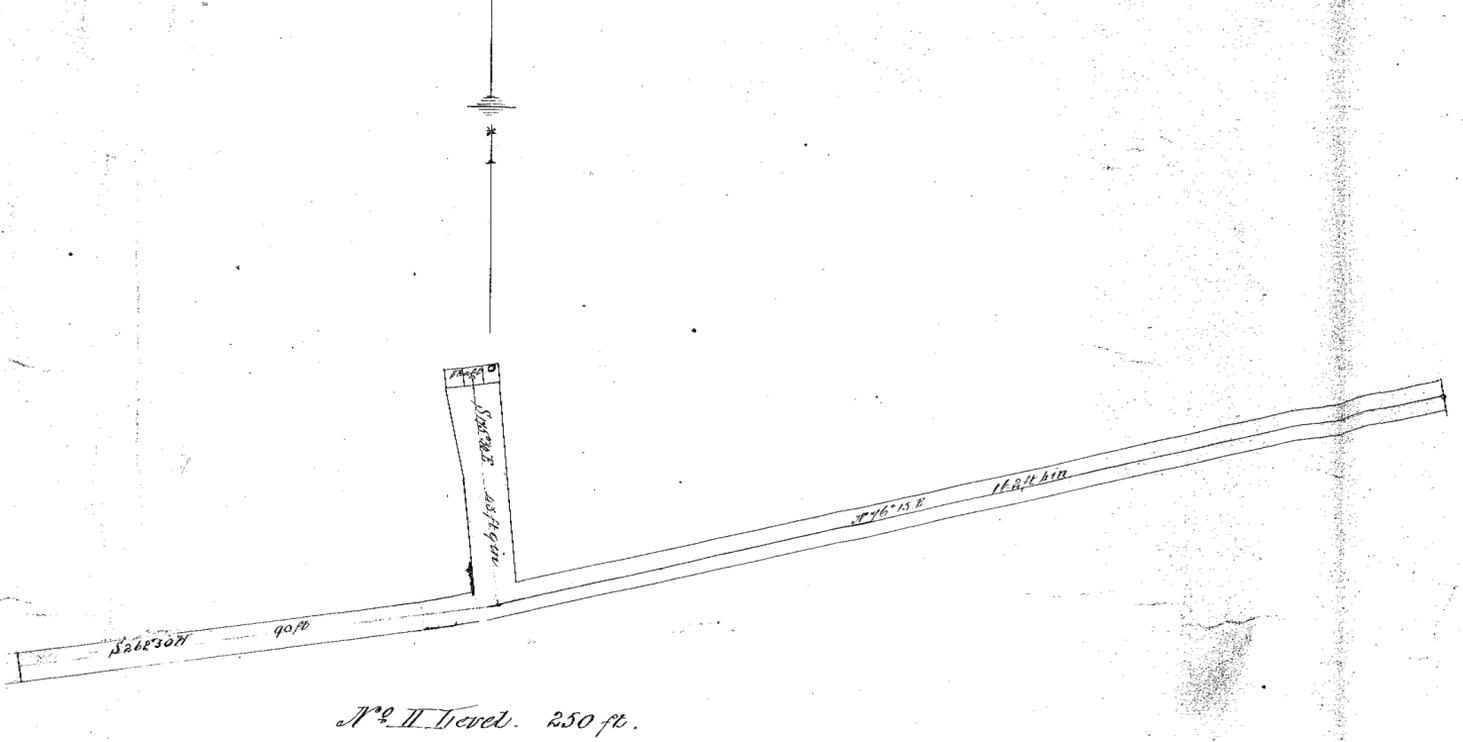

267-04

1089

Thos Hogg

No 144

Morning Star G. M. Co.


514

Steels & others

James Boughton
Mining Manager

10 ac

C. W. Lord
Mining Surveyor
26th March 1880

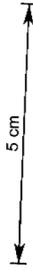

Excelsior

Scale 25 feet to 1 inch