

268-01

268-01


5 cm

DEMON C. W.

PLAN DEVON . M. C.

Scale 25ft to 1 inch.

*Certified correct copy of plans
of work done &c up to Jan 1901
Theodolite survey
C. Bingley Watson
Auth. Survey*

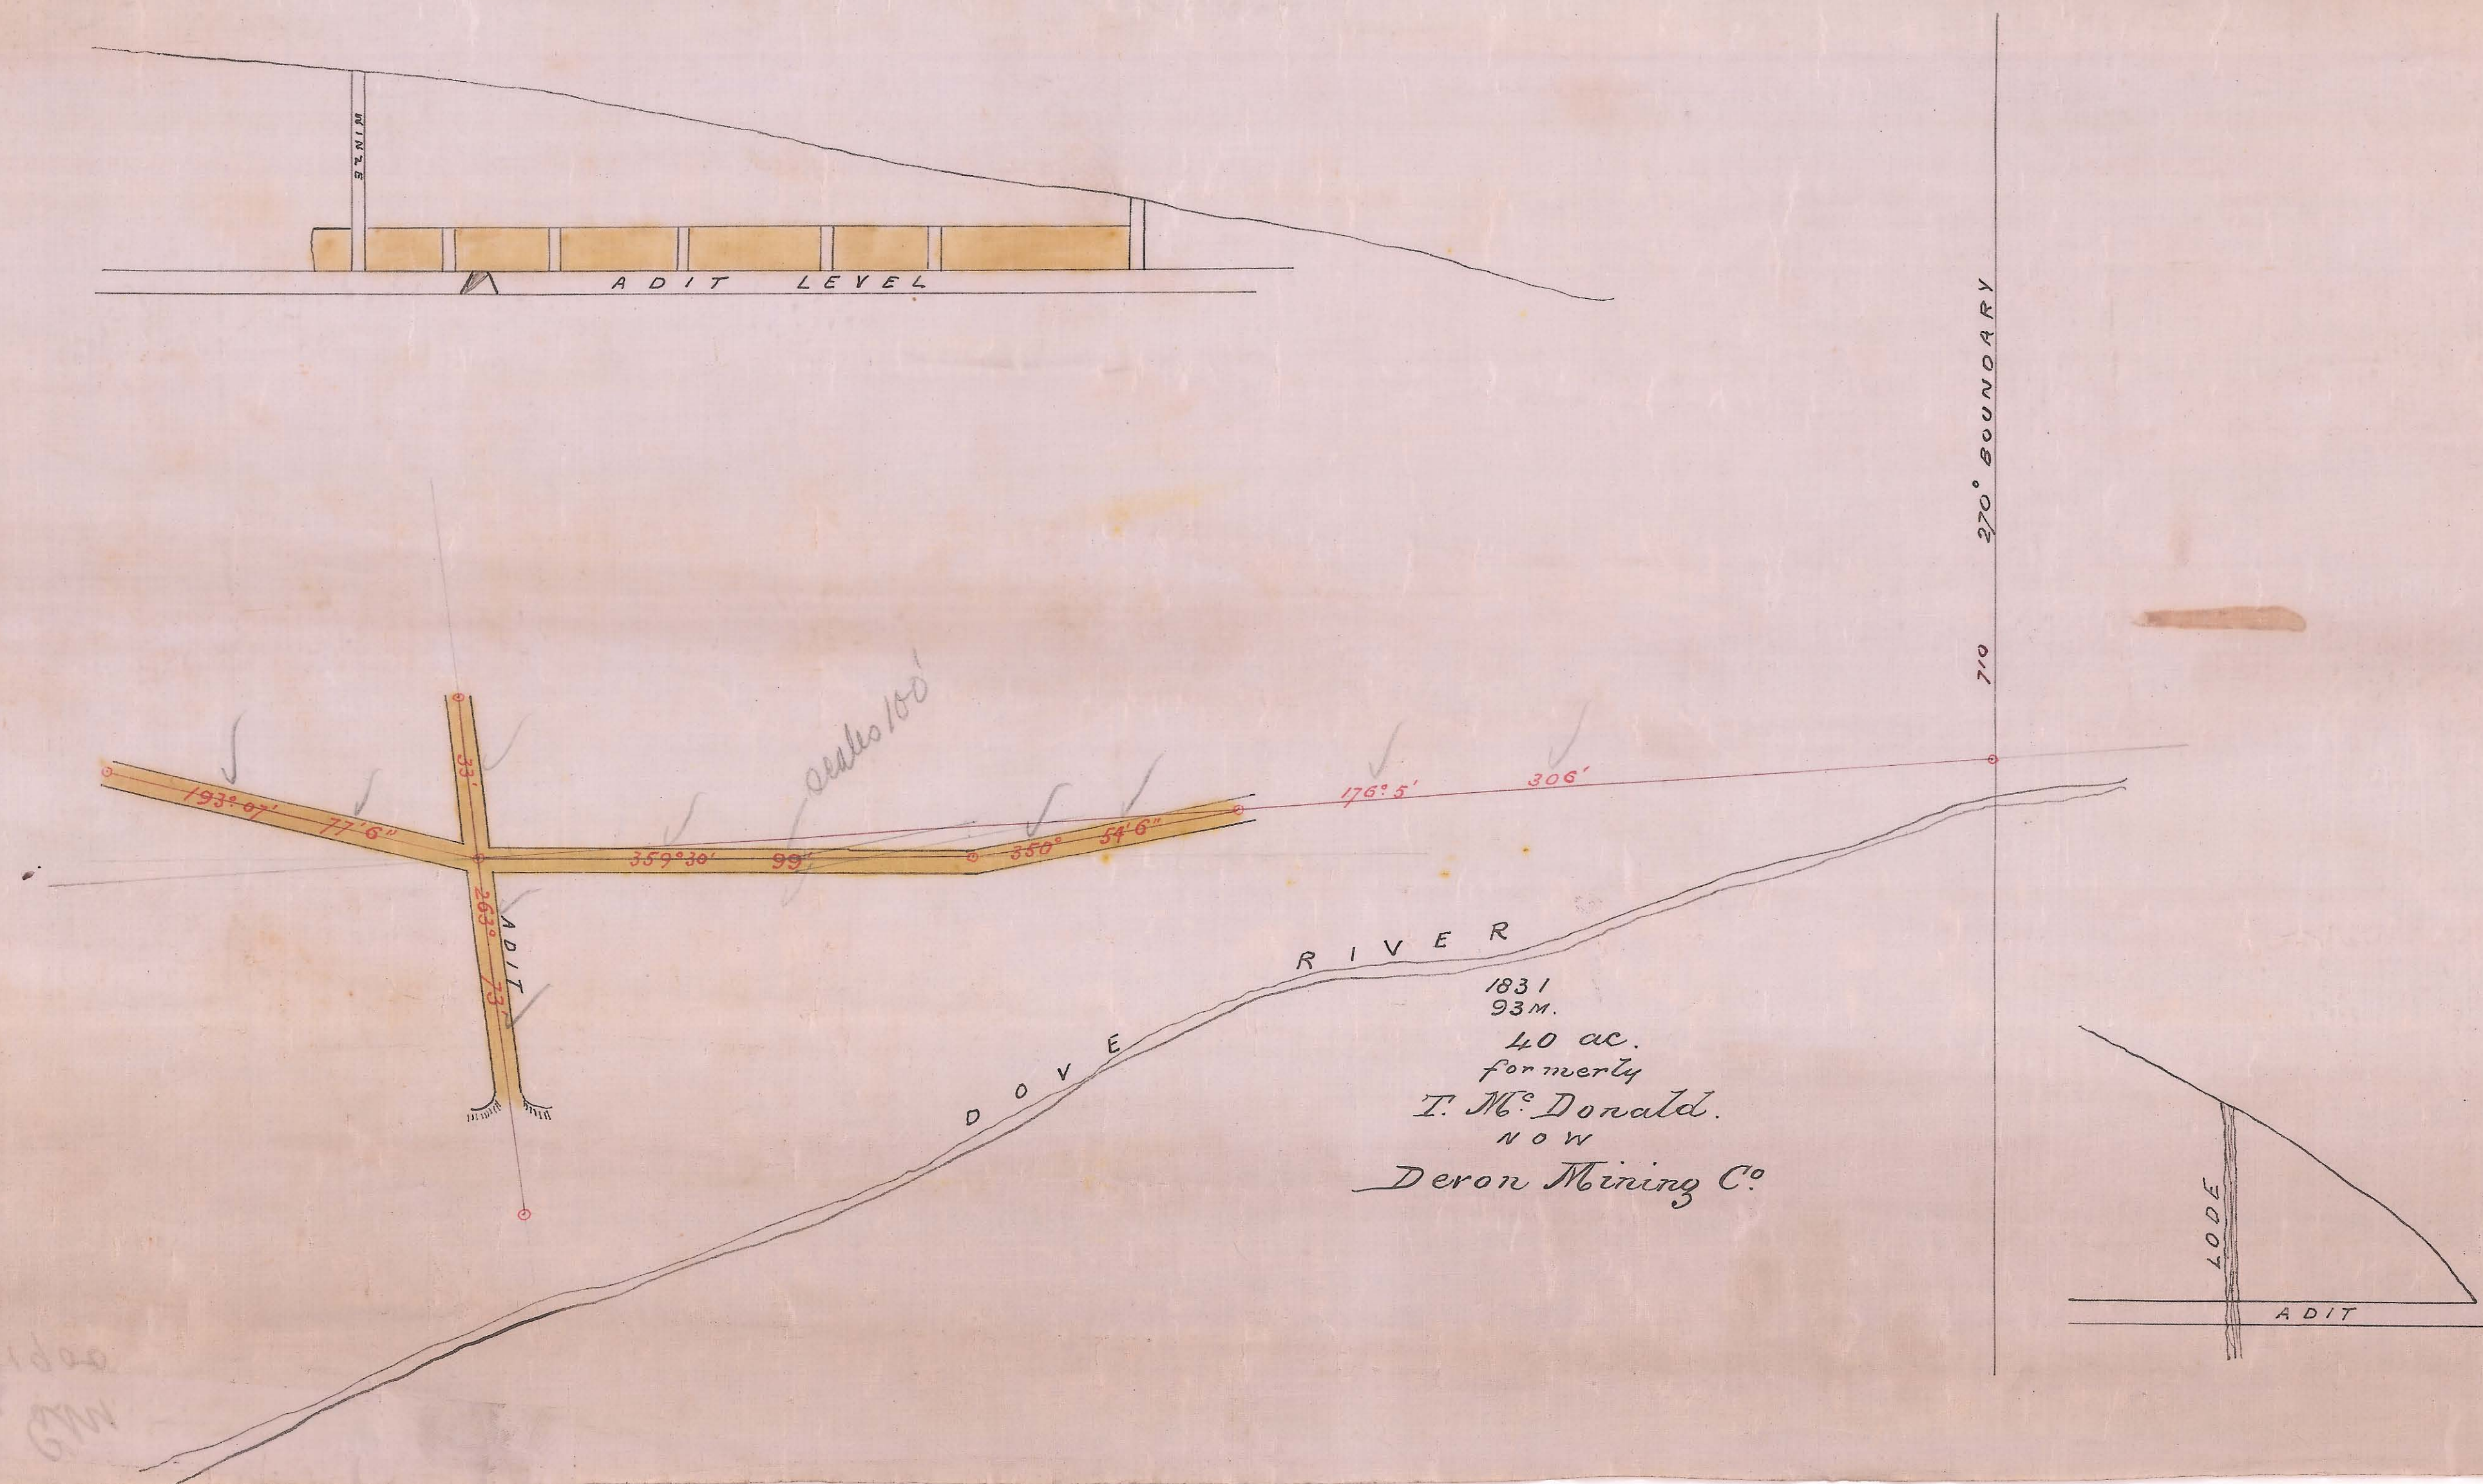

1831
93 M.
40 ac.
formerly
T. Mc Donald.
NOW
Deron Mining Co.

*For 1800
Deron Mining Co.*

*For 1800
Deron Mining Co.*