


268-02

5 cm


268-02

Devon Mine

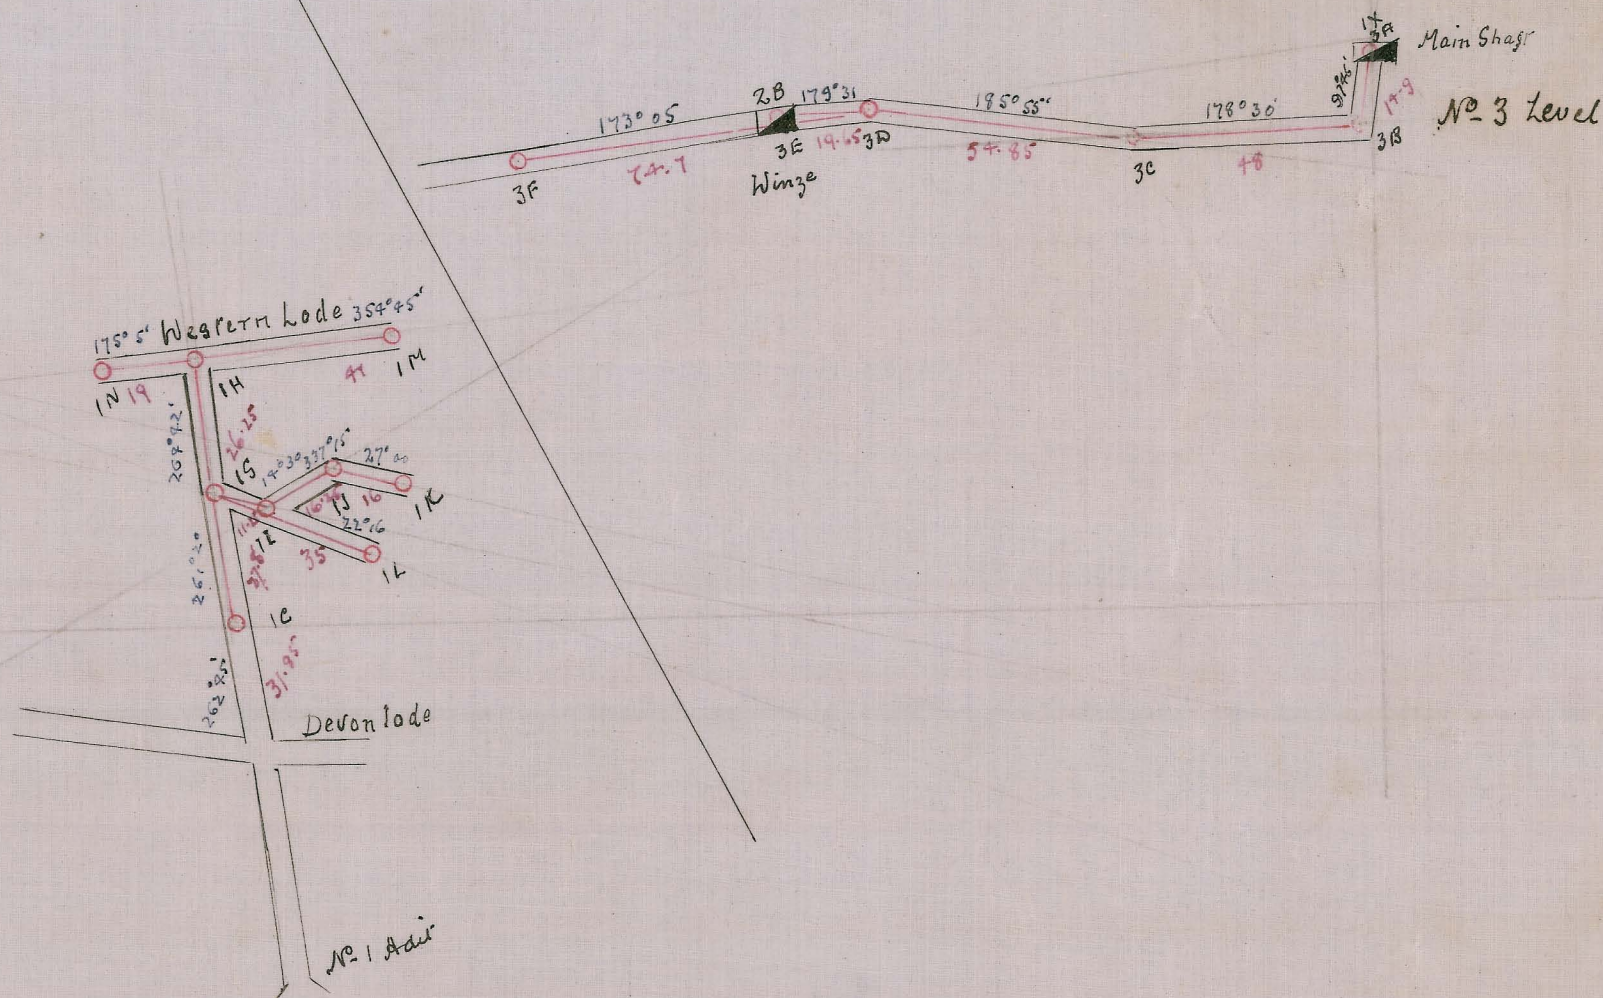


Plan 1" = 40 F^t
Dist. in F^t

I S W Come by 40 21 98 01

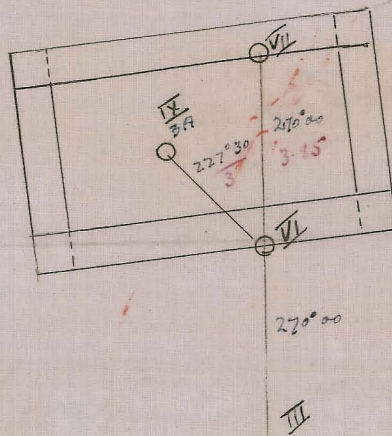

Showing Substation IX at
Main Shaft Collar
Scale 1/4" = 1 F^t

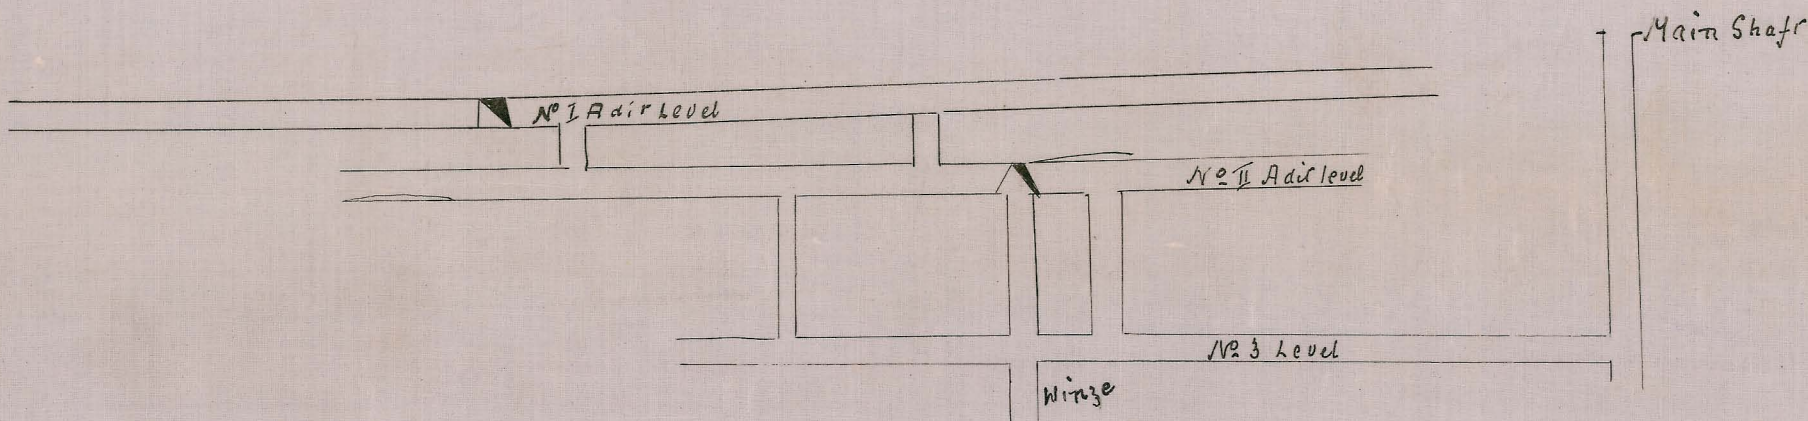

Long. Section 1" = 40 F^t

Wm L. Hitchcock
20 May 09
Survey made with T & S theodolite
Station IX by measurement from
II with heavy found by projection
as instrument could not be used



50 p/m/ed
2 m/ed