



1881  
1881

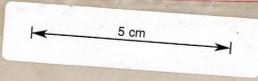

269-01

# COSMOPOLITAN C.M.

Ground Plan  
Scale 25ft to an inch

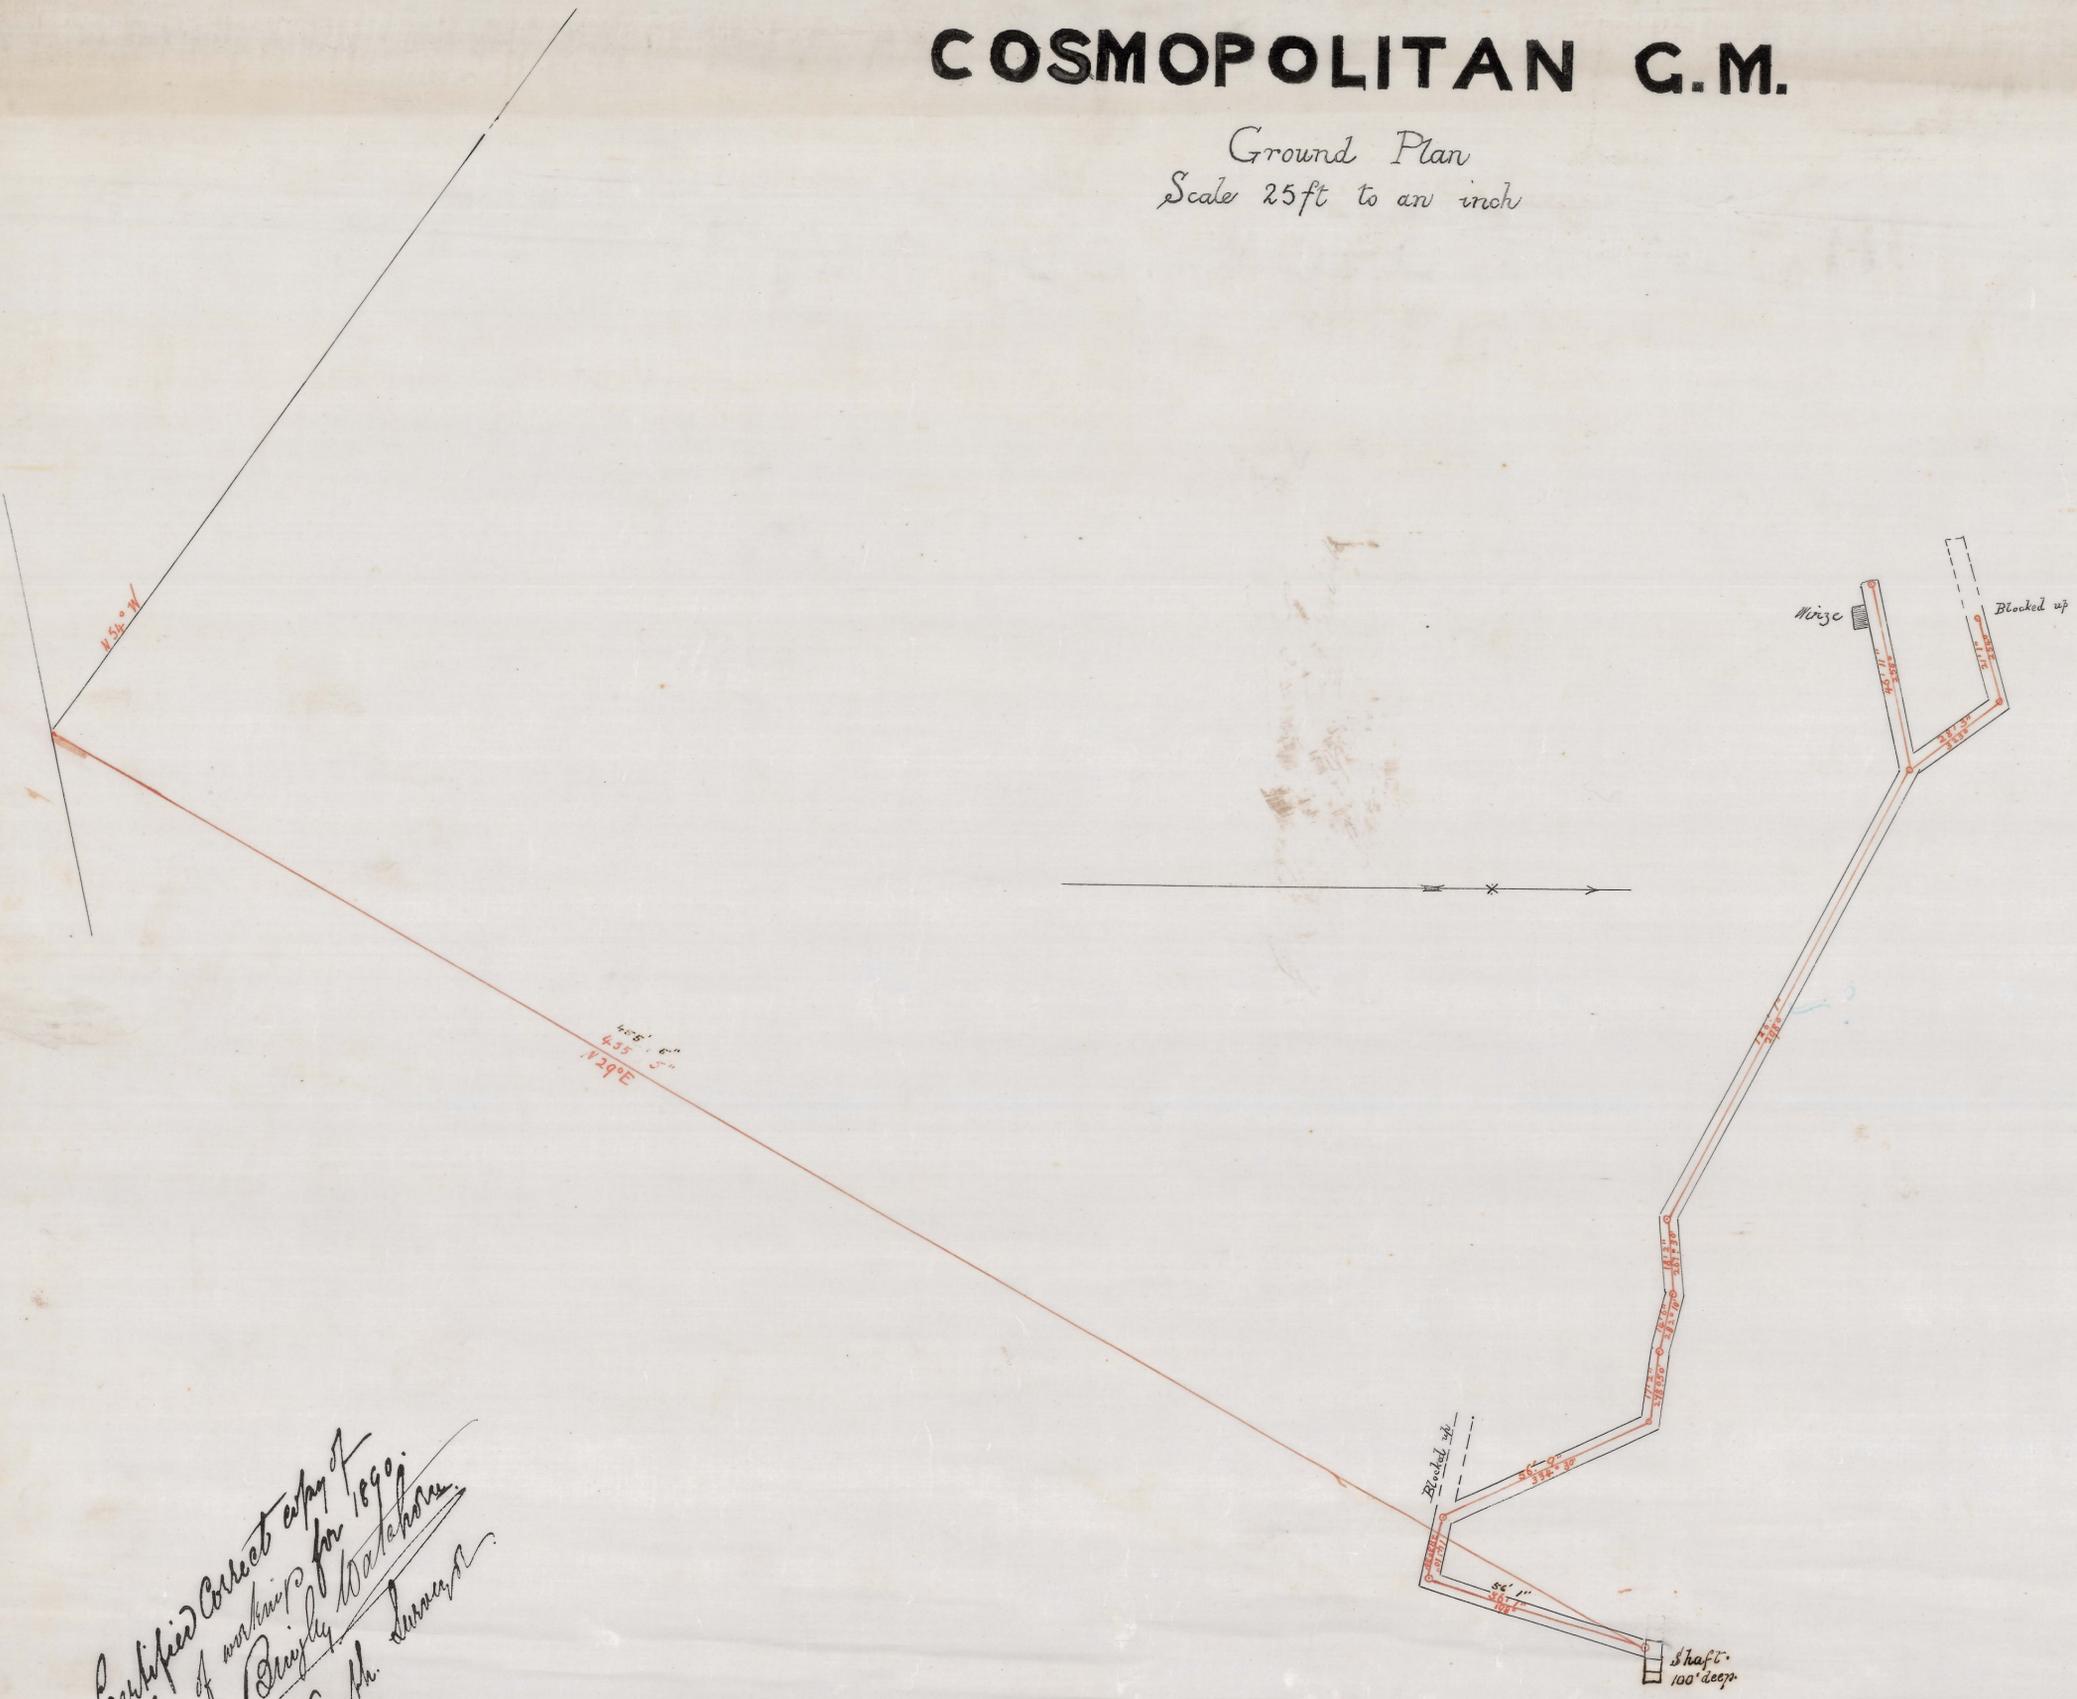

*Certified Correct copy of  
Plan of workings for 1890.  
C. Dingley Waterhouse  
Cuth. Sumner*

*W.P. [unclear]*