


269-02



269-02

COSMOPOLITAN C.M.

*Longitudinal Section
Scale 25ft to an inch*

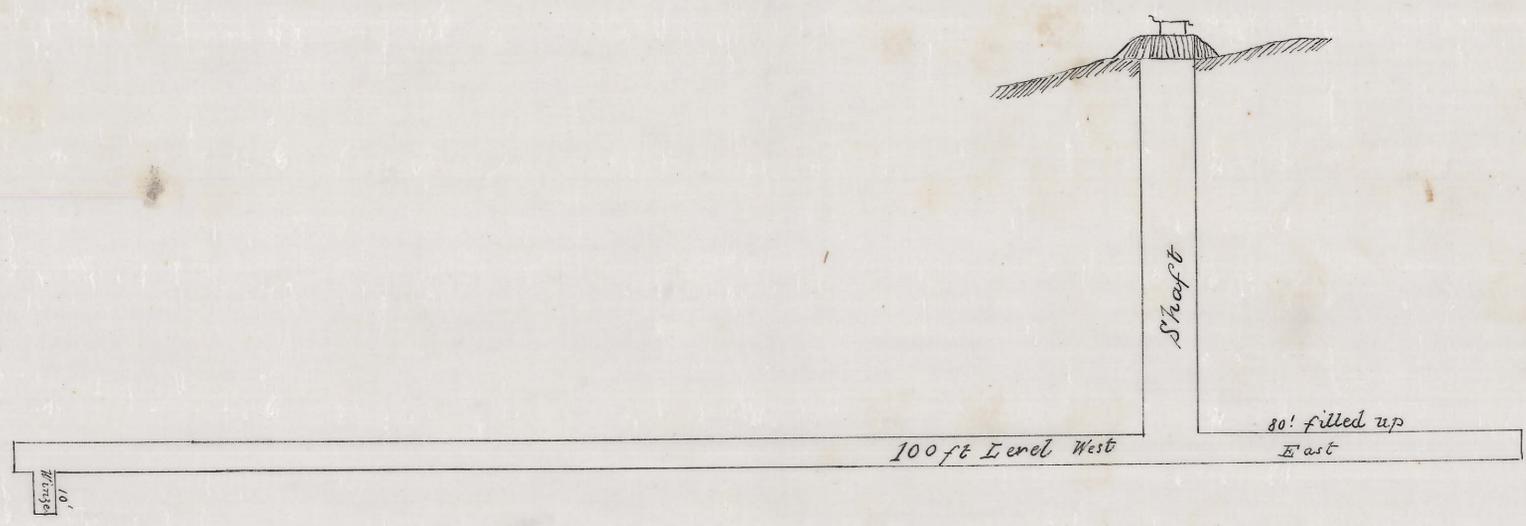

*See original correct copy
of plan to year 1891
C. P. Bishop Waterworks
Amherst, Mass.*