


270-01

Cosmopolitan G. M.

Scale 25 ft to 1 in during 1891

[illegible]

N (original
d.M.)

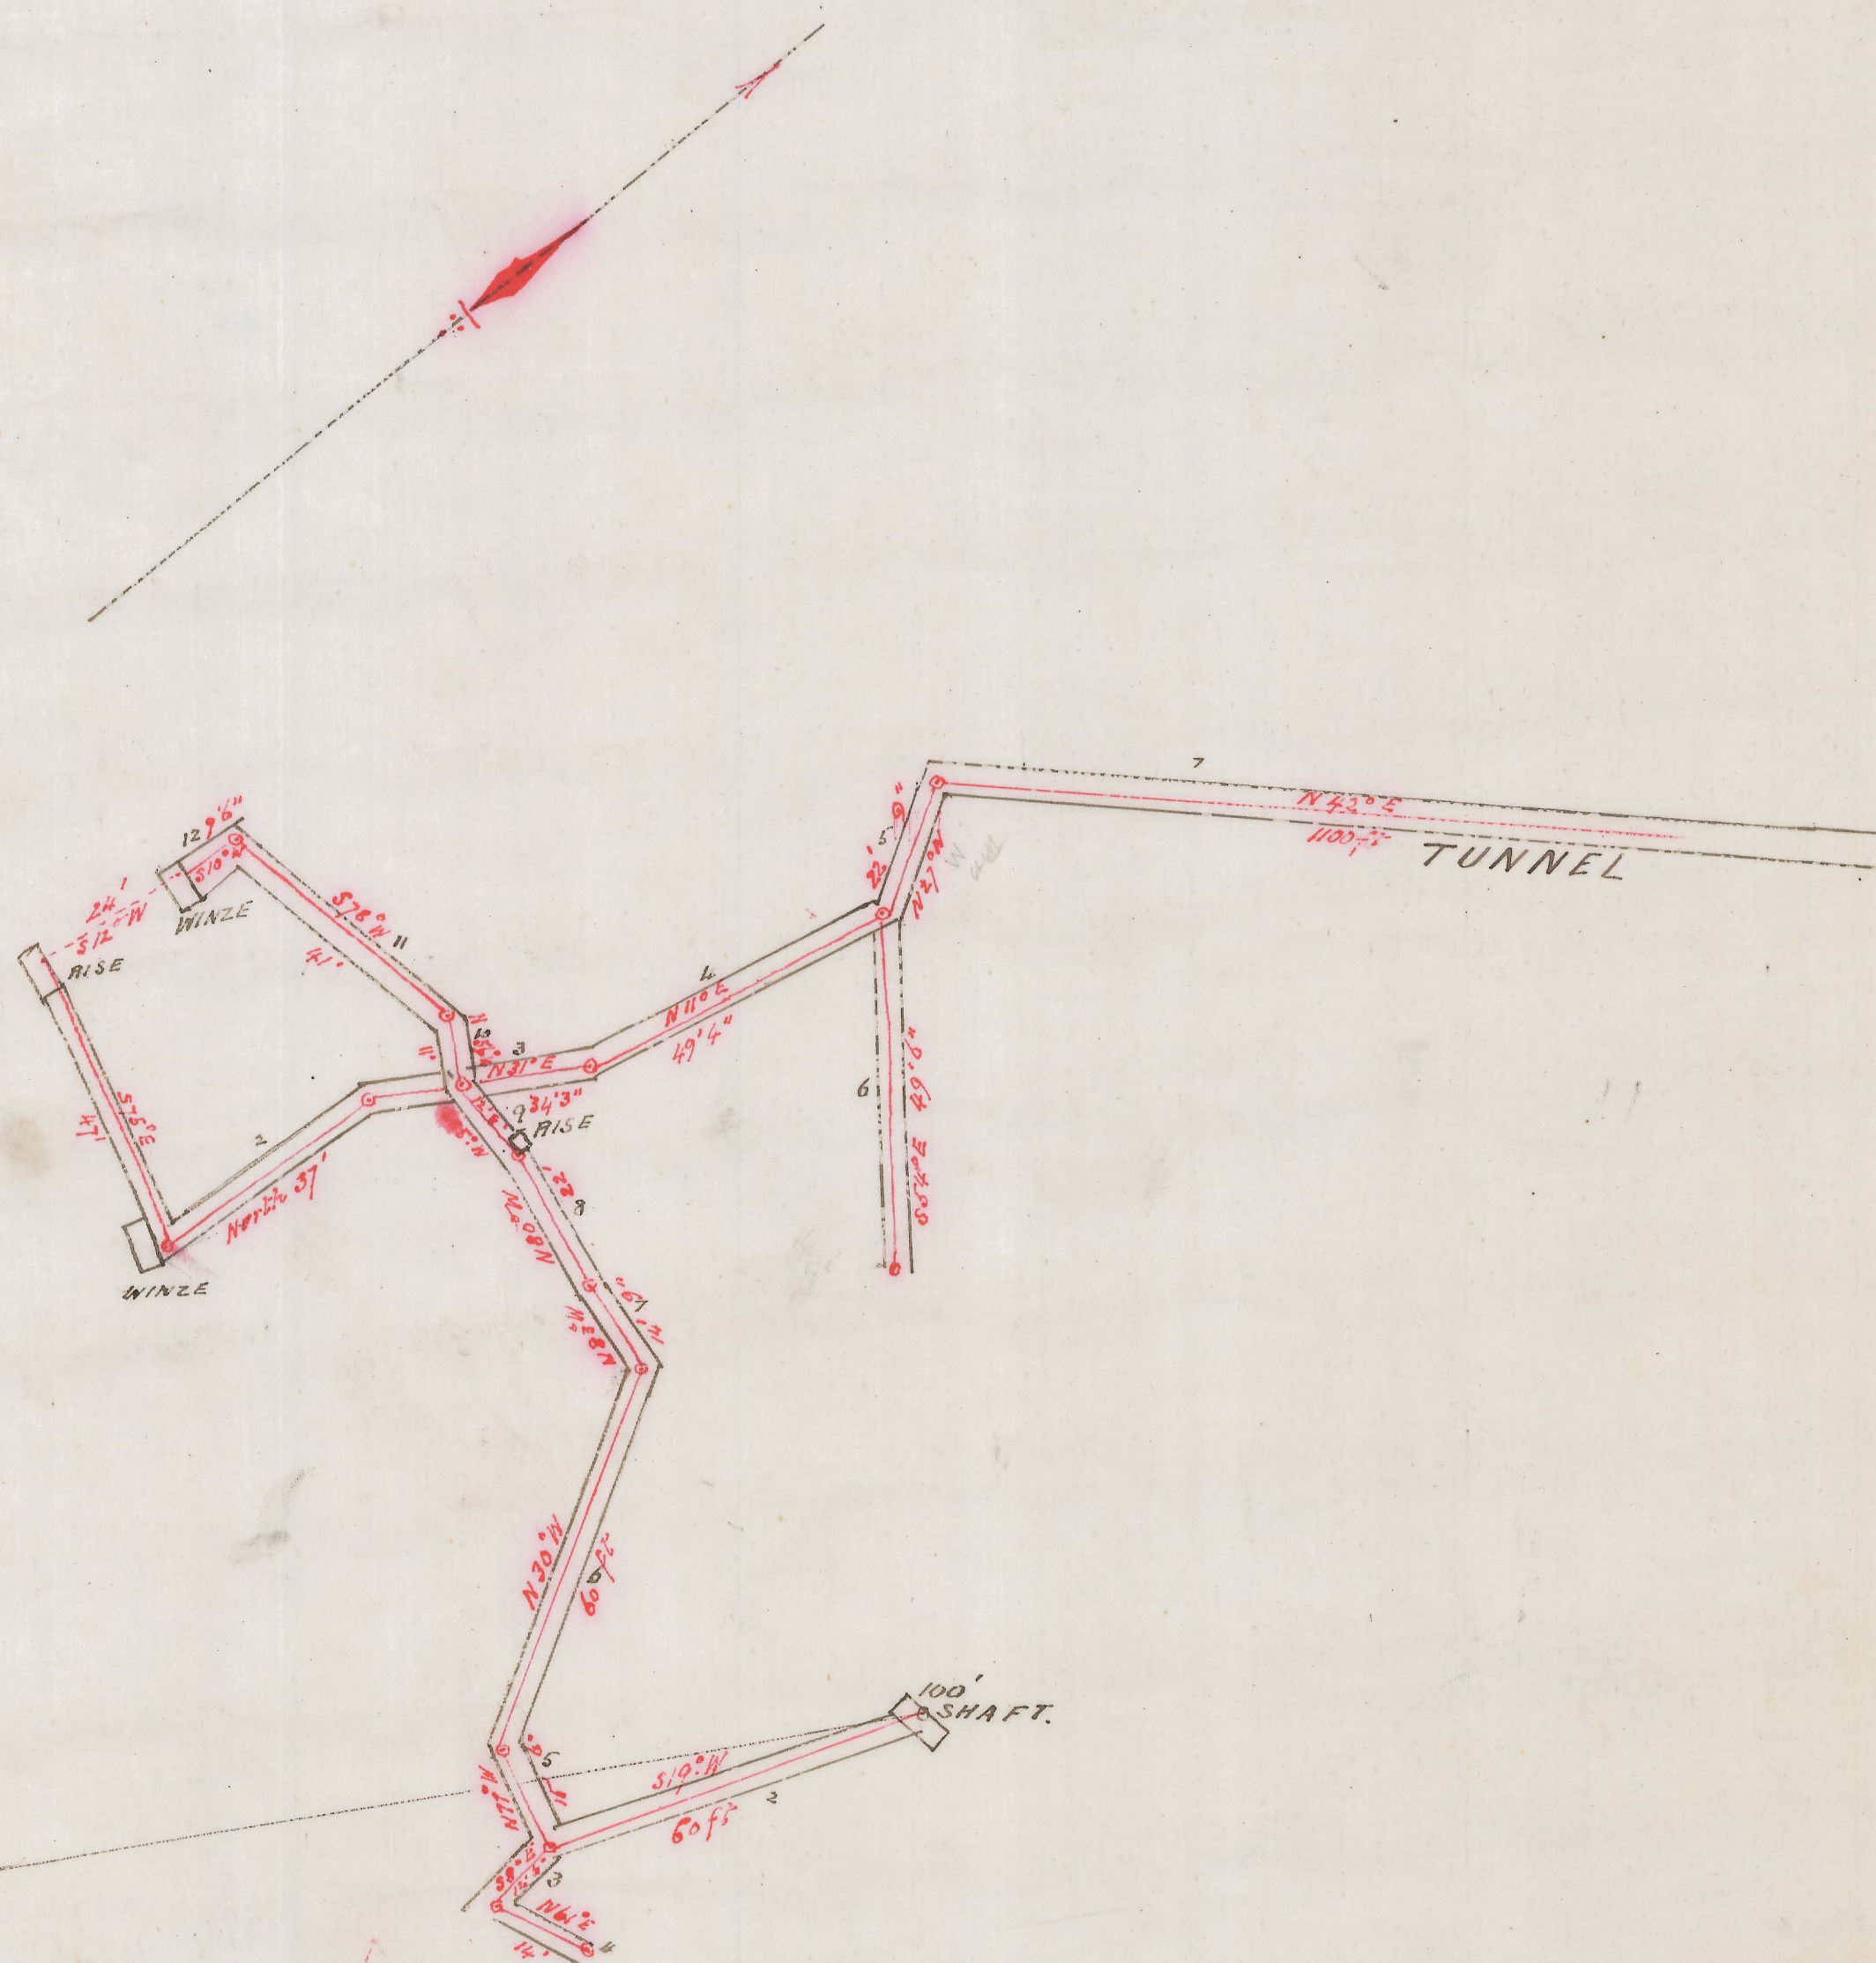

P. Bunker Watson
Drayton
May 5th 94

ms. 9. 1881