





NEW COSMOPOLITAN C.M.

Scale 25 ft to 1 inch.

27 APR 1898

5 cm

270-04

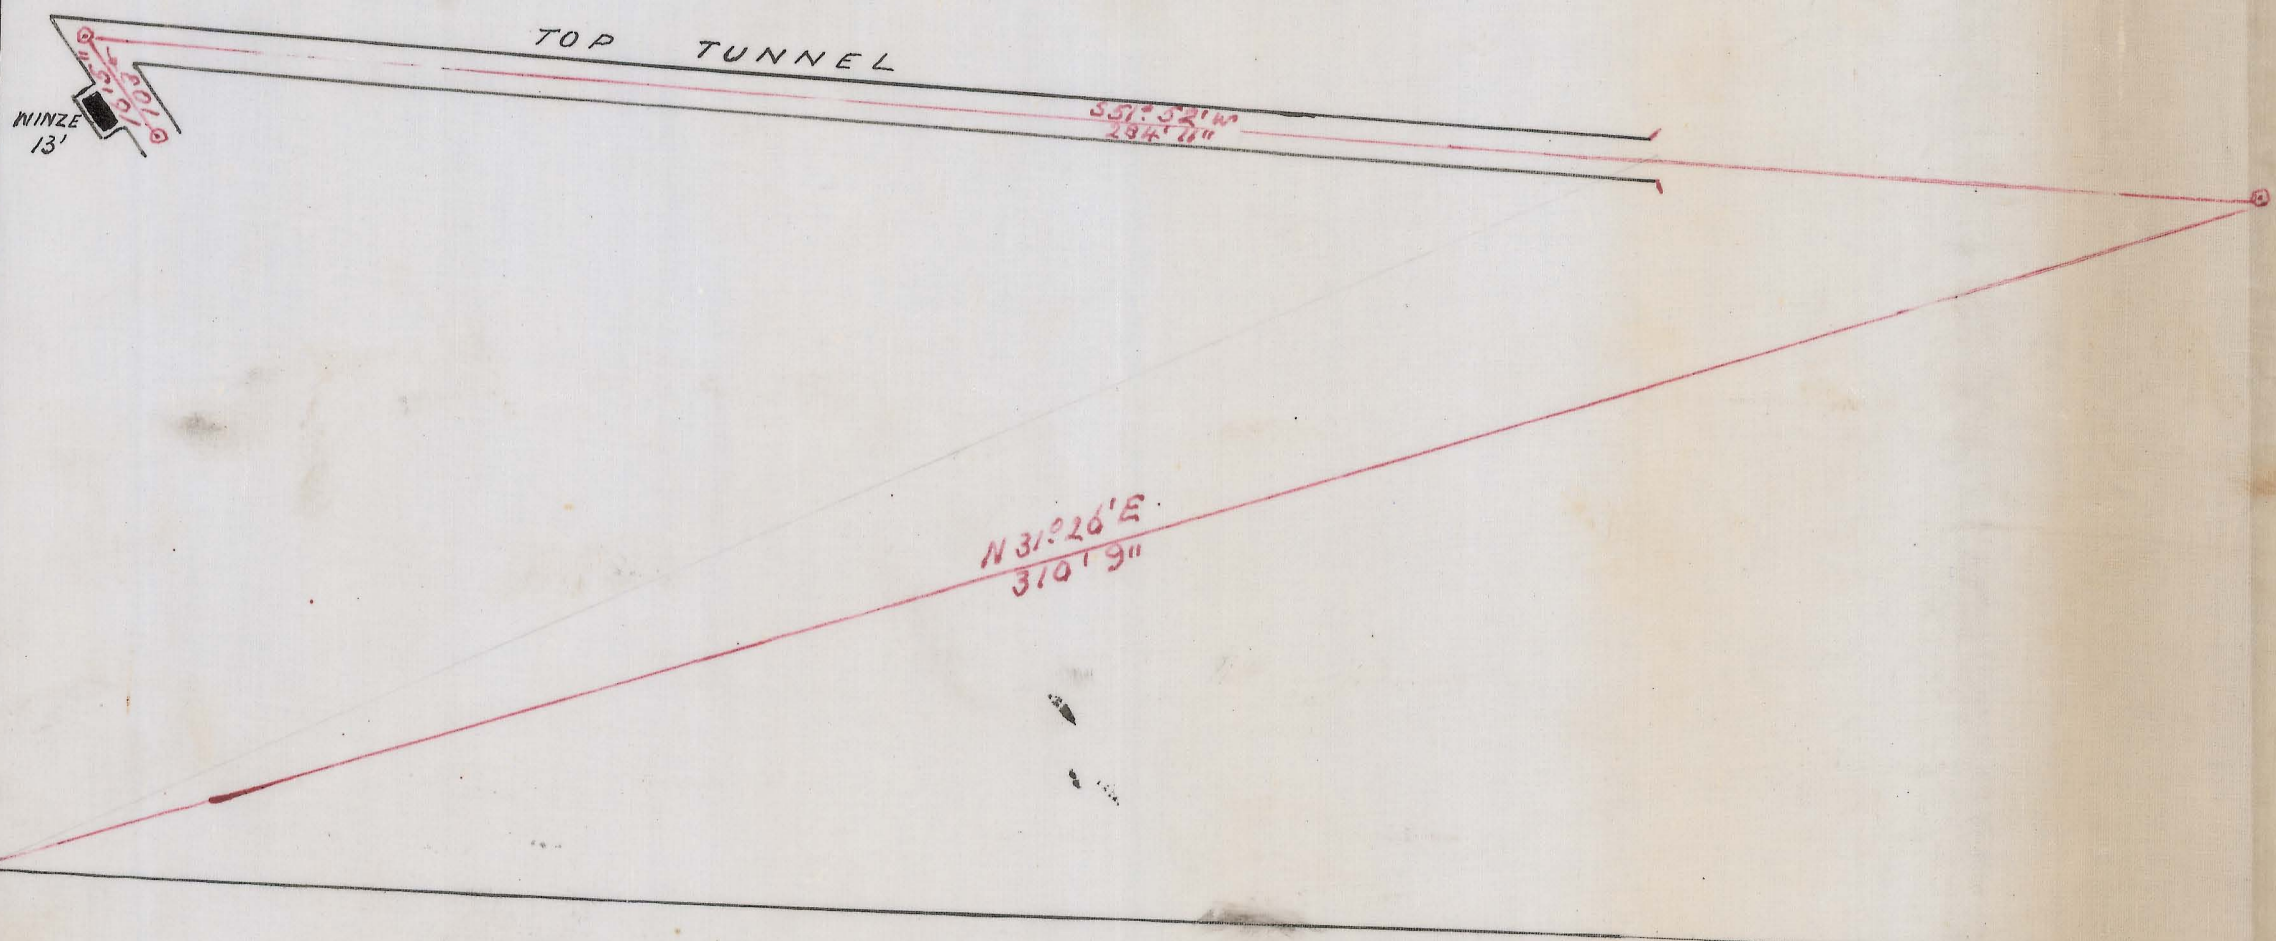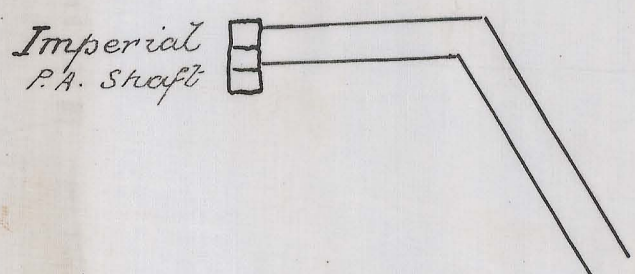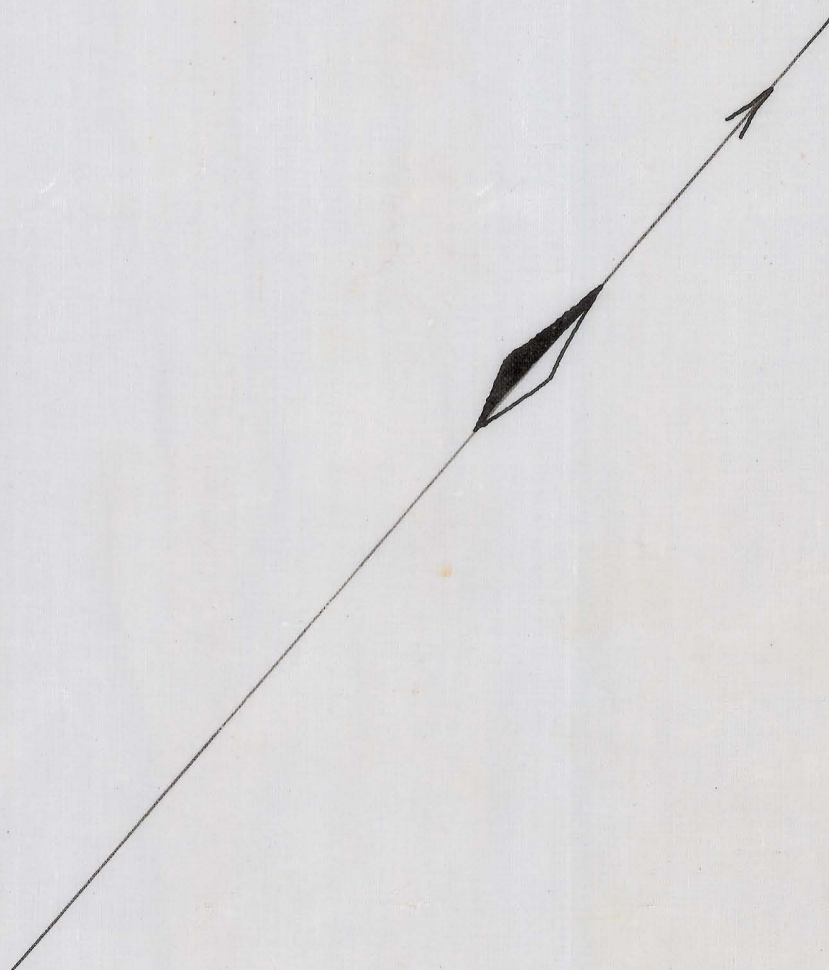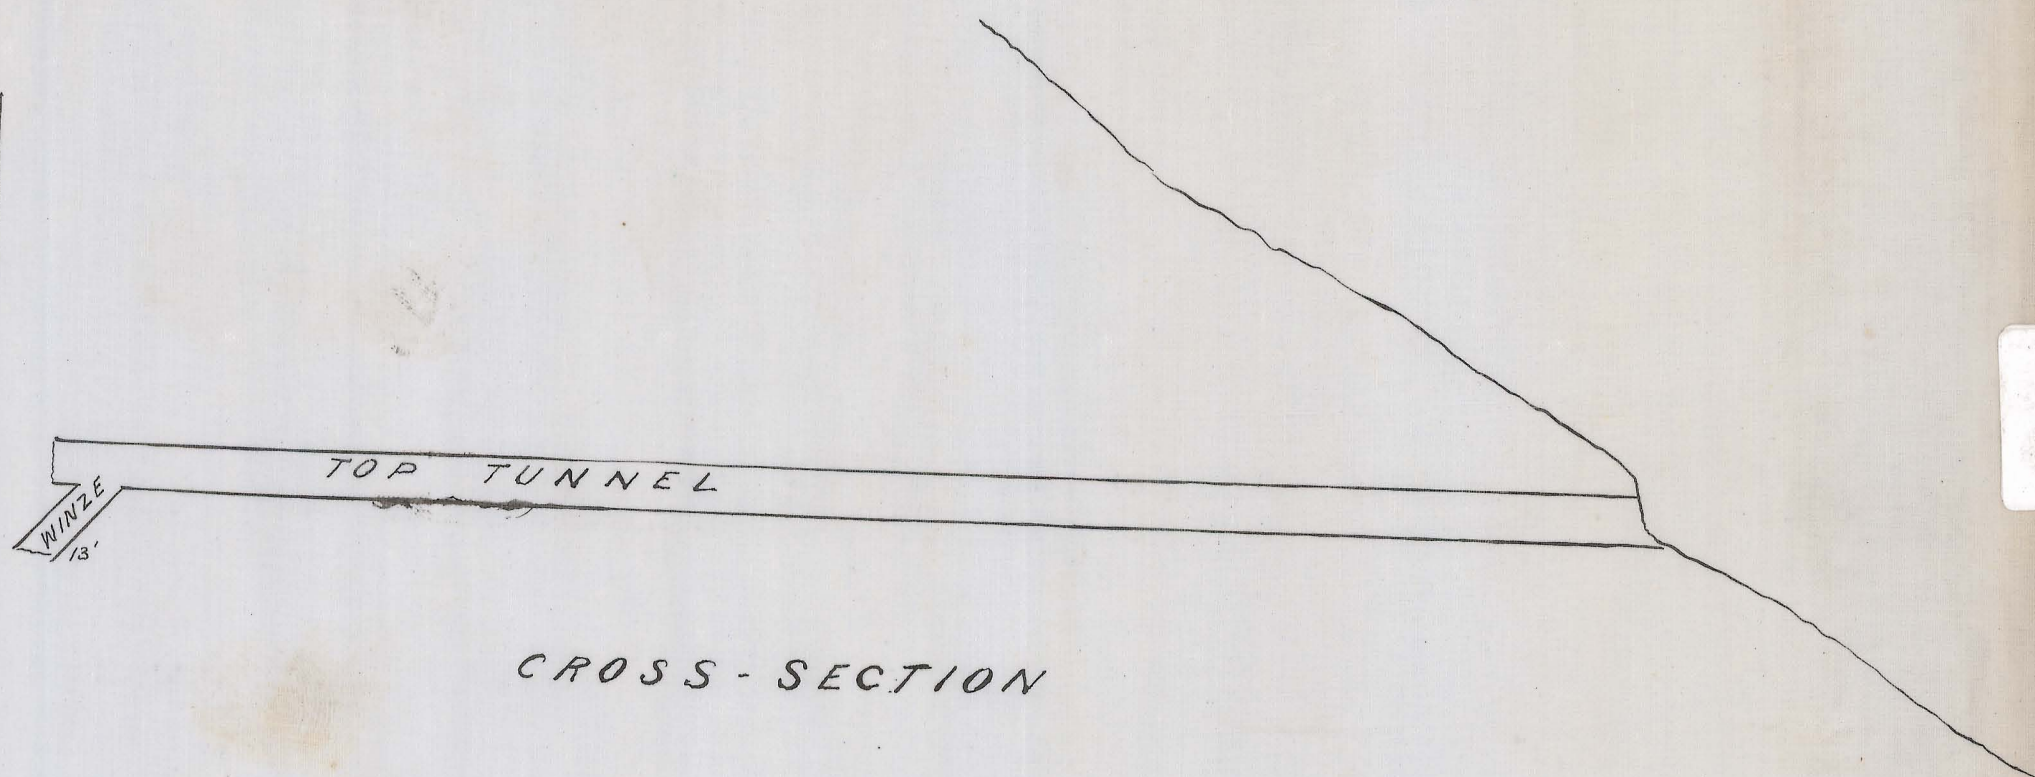

Verified correct copy
of plan of work done
during 1898
by J. J. Watson.
30/12/98.

270-04