
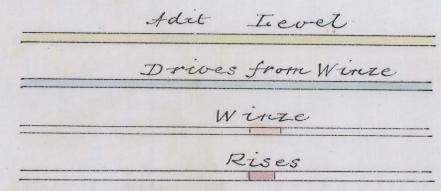
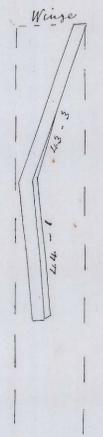


Normal level

| | |
|------|----------------|
| (1) | From datum Peg |
| (2) | Tramway |
| (3) | Approach |
| (4) | to shaft |
| (5) | |
| (6) | |
| (7) | |
| (8) | |
| (9) | |
| (10) | |
| (11) | Winze |
| (12) | to Rise |

Bottom of Winze

| | |
|-----|--------------------------------------|
| (1) | Centre 1-3 from foot wall |
| (2) | |
| (3) | datum 3-6 from foot, centre of Winze |
| (4) | |
| (5) | Cross cut |

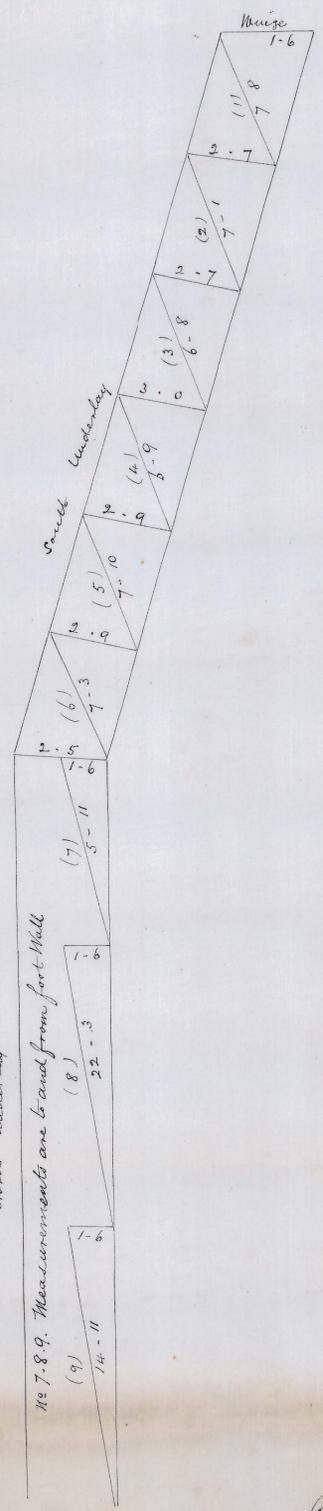


No 7, 8, 9. Measurements are to and from foot wall

7th, 10th, 19th December 1895

To date, 7th September 1896

Sinking Winze continued

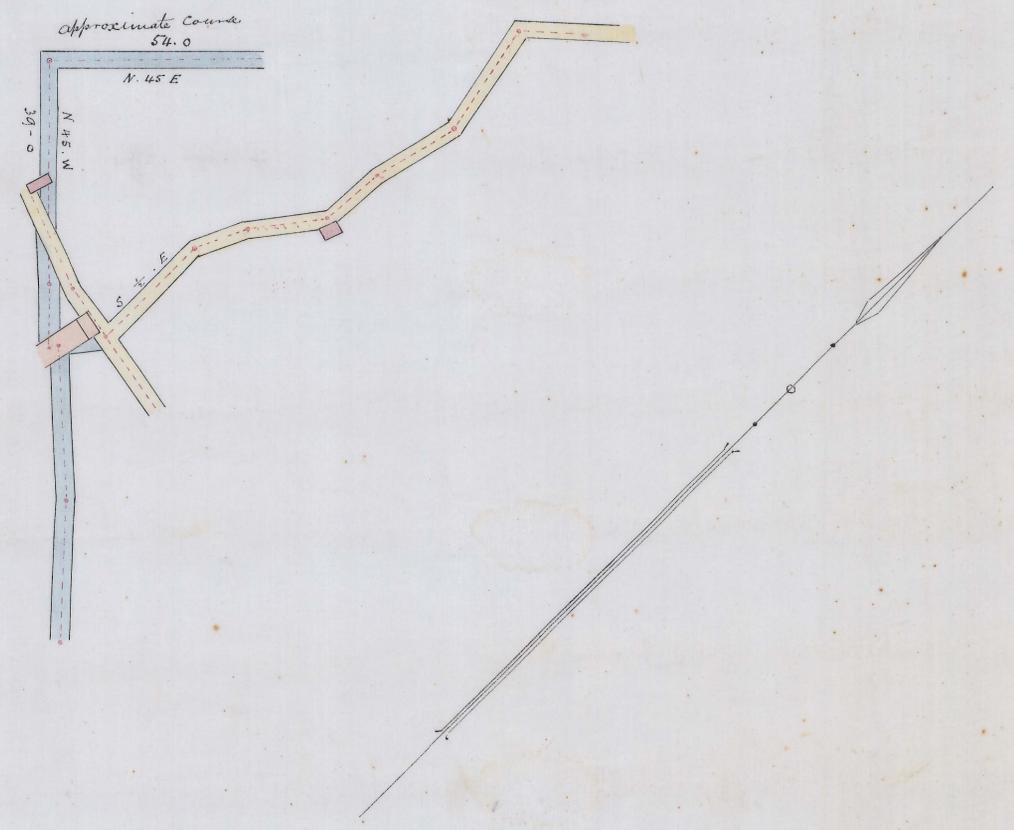

The New Cosmopolitan C.M.C. No Lia:
Beaconsfield
Scale 25 ft to an inch

(Signed) E. S. Bufford
Certificated Mining Manager

Tracing from
Mr Bufford's plan
Sched. 1897
8th April 1897

1891
No 7, 8, 9