


273-02

273-02

5 cm

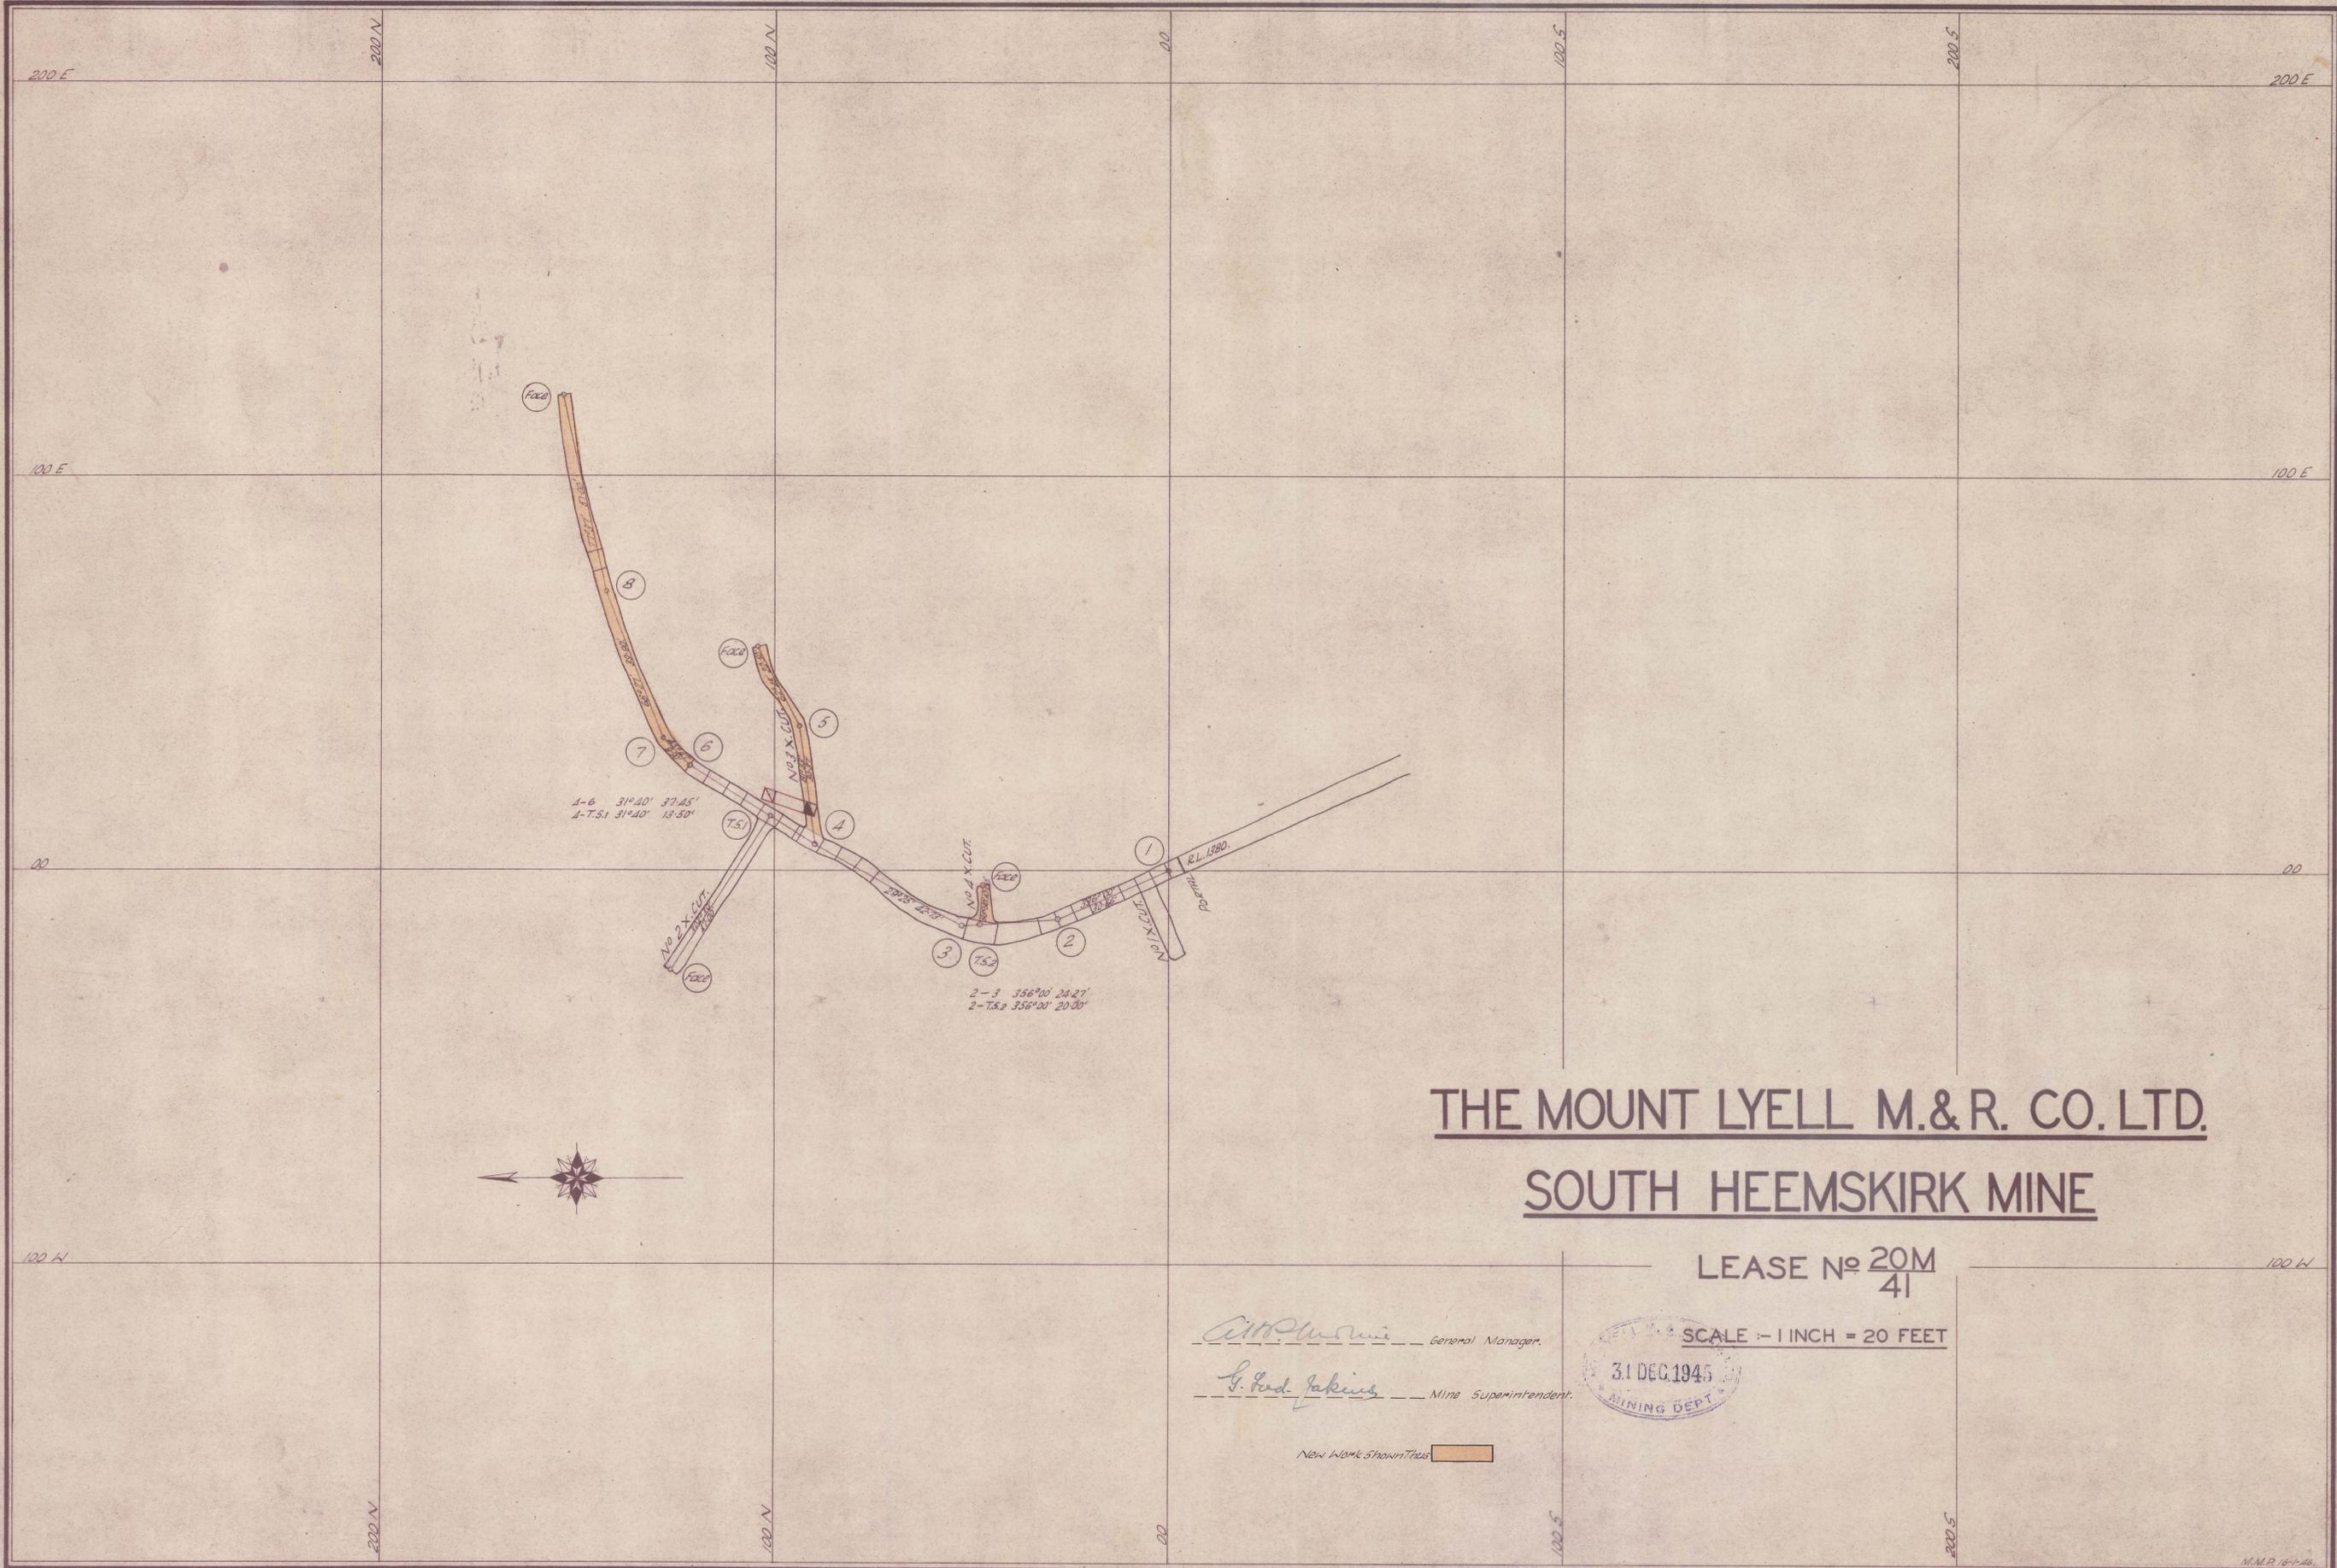

THE MOUNT LYELL M. & R. CO. LTD.
SOUTH HEEMSKIRK MINE

LEASE No **20M**
41

W.P. ... General Manager.

G. ... Mine Superintendent.

New Work Shown Thus

SCALE - 1 INCH = 20 FEET
 31 DEC. 1945
 MINING DEPT.