

274-01



274-01

5 cm

PLAN

TASMANIA WEST EXT^d C.M.

Scale 25 ft. to 1 inch.

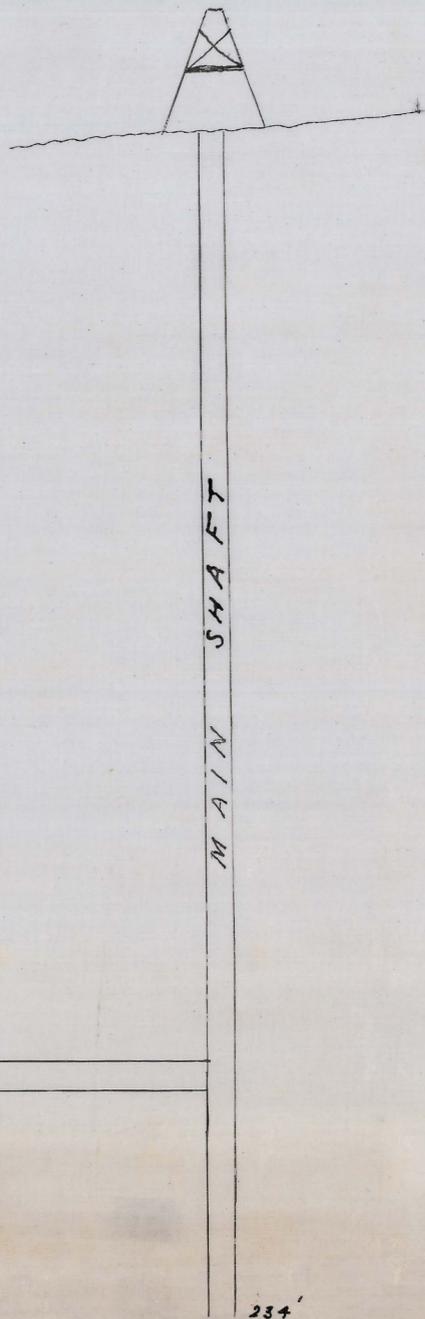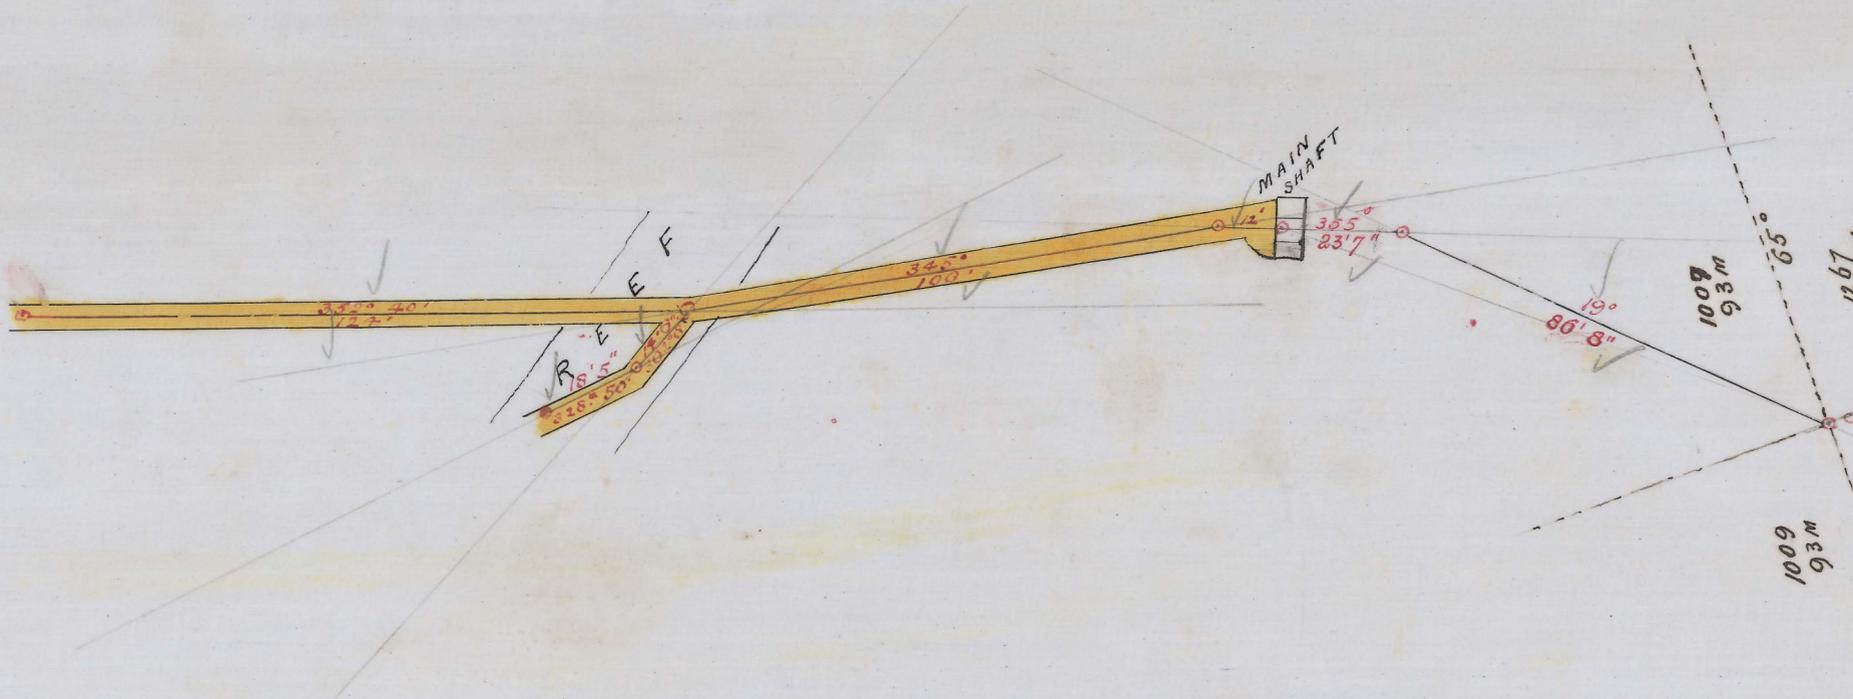

REEF

181 ft. LEVEL

234'

*Corrected
copy of plan
with
M. J. B. Watson
1/9/1900*



*for 1000 shaft
depths and 1000
depths of 1000 shaft*